



SI-2733-2 D. West, Government Printer

STATION YARROWLYCK. TS 6904-											
<p>Owner's Name: R.S. J. F.J. MARTELL            Address: Woodstock            Phone: 75 5529</p> <p>Access Owner: Alan Dickson            Current Occupant: Ben Dingle            Address: Uxale            Phone: 75 5536</p> <p>ACCESS</p> <p>Access Report of: 1961 was found suitable/unsuitable:            0.0 Armidele P.O. heading south along Faulkner Street.            0.13 Turn RIGHT into Rusden Street            1.84 Turn LEFT            1.96 Turn RIGHT into McKenna Street            2.15 Turn LEFT after passing under railway bridge            2.89 Turn RIGHT towards Bundarra, Inverell            14.89 Cross Invergowrie Creek            26.31 Concrete bridge over Boorlang Creek            28.65 Cross Oakley Creek            30.62 Turn RIGHT into Ben Dingle "Woodstock" is straight ahead for about 2km            30.66 Cross Grid            31.06 Double wooden gates            31.27 Through double wooden gates on RHS of house.            31.38 Through iron gate            31.43 Through wooden gate beside old concrete block dairy            31.82 Wire gate            32.04 Old wooden gate            32.12 Track veers LEFT at fence corner.            32.55 Leave vehicle near old tractor tyre on LHS.            Walk up spur - veer right at saddle to tug About 1 1/2 hours steep walk.</p>	<p>Beacon Diagram</p> <p>NOTE: Station appears to be on boundary of freehold and vacant crown land.</p> <p>The crown land is in the process of being dedicated to nature reserve.</p> <p>This section to be completed by officer constructing pillar.</p> <p>Original station mark found/not found.</p> <p>Description of mark:</p> <p>Original beacon found/not found.</p> <p>Description of beacon:</p> <p>Height Top of Vanes to Top Mark: above .....m.</p> <p>Height of mark: above rock/conc .....m, below G.L. ....m.</p> <p>Diameter of Vanes: .....m. Height of Calm .....m.</p> <p>Original Beacon has/has not been destroyed by me.</p>										
<p>Access Report of: 1961 was found suitable/unsuitable:            0.0 Armidele P.O. heading south along Faulkner Street.            0.13 Turn RIGHT into Rusden Street            1.84 Turn LEFT            1.96 Turn RIGHT into McKenna Street            2.15 Turn LEFT after passing under railway bridge            2.89 Turn RIGHT towards Bundarra, Inverell            14.89 Cross Invergowrie Creek            26.31 Concrete bridge over Boorlang Creek            28.65 Cross Oakley Creek            30.62 Turn RIGHT into Ben Dingle "Woodstock" is straight ahead for about 2km            30.66 Cross Grid            31.06 Double wooden gates            31.27 Through double wooden gates on RHS of house.            31.38 Through iron gate            31.43 Through wooden gate beside old concrete block dairy            31.82 Wire gate            32.04 Old wooden gate            32.12 Track veers LEFT at fence corner.            32.55 Leave vehicle near old tractor tyre on LHS.            Walk up spur - veer right at saddle to tug About 1 1/2 hours steep walk.</p>											
<table border="1" style="width: 100%; border-collapse: collapse;"> <thead> <tr> <th style="width: 30%;">Date</th> <th style="width: 70%;">Record of Station</th> </tr> </thead> <tbody> <tr> <td>22.3.82</td> <td>Permission granted verbally by Mrs Martell for work to be carried out on freehold land.</td> </tr> <tr> <td>23.3.82</td> <td>Permission granted for access by Alan Dickson [Ben Dingle] and gang of timbering before</td> </tr> <tr> <td>23.3.82</td> <td>Permission granted for clearing on Crown Land by R.W. Torgott - Armidele L.B.O.</td> </tr> <tr> <td>29.4.82</td> <td>Letter from N.P.W.S requests that an officer from the Service accompany the overseers when commencing work</td> </tr> </tbody> </table>		Date	Record of Station	22.3.82	Permission granted verbally by Mrs Martell for work to be carried out on freehold land.	23.3.82	Permission granted for access by Alan Dickson [Ben Dingle] and gang of timbering before	23.3.82	Permission granted for clearing on Crown Land by R.W. Torgott - Armidele L.B.O.	29.4.82	Letter from N.P.W.S requests that an officer from the Service accompany the overseers when commencing work
Date	Record of Station										
22.3.82	Permission granted verbally by Mrs Martell for work to be carried out on freehold land.										
23.3.82	Permission granted for access by Alan Dickson [Ben Dingle] and gang of timbering before										
23.3.82	Permission granted for clearing on Crown Land by R.W. Torgott - Armidele L.B.O.										
29.4.82	Letter from N.P.W.S requests that an officer from the Service accompany the overseers when commencing work										

## CENTRAL MAPPING AUTHORITY

## GEODETTIC SURVEY OF N.S.W.

## GEODETTIC STATION RECONNAISSANCE and MAINTENANCE REPORT

## Description:

Notes: Cross out word or words which do not apply

1. Cleared by ~~none~~ bearing ~~to~~ Perimeter ~~346°~~ 185° ~~195m~~ 40m from Trig. ~~West~~ East Pillar.

2. Mast & Vanes have been painted white & black respectively. ✓

3. The ~~station~~ station pillar was ~~erected~~ erected / constructed on ~~30°~~ 1982 dimensions now being:

Description of mark: ~~Steel~~ Steel Pillar ~~10m~~ 10m should be explicit, e.g., S/Steel Pillar Plate, Steel plug, Brass plug, Bolt, G.I. Pipe

Height of mark: ~~1.335~~ 1.335 m. ~~above~~ above ~~rock/concrete~~ rock/concrete Mark is ~~1.435~~ 1.435 m. ~~above~~ above ~~Large Rock~~ Large Rock.

Height of Top Vanes to Top ~~Mark~~ Mark / Pillar plate ~~1.350~~ 1.350 m. Diameter of Vanes (vertical) ~~1.550~~ 1.550 m.

Height of Cairn ~~1.450~~ 1.450 m. Diameter of Cairn ~~1.782~~ 1.782 m. Name Plate ~~found~~ found / placed ~~1.782~~ 1.782 m.

Length of Mast ~~1.450~~ 1.450 m. (approximate if not supplied) Central Mapping Authority

4. A. ~~S.T./S.M.~~ S.T./S.M. set in conc/ ~~rock~~ rock has been ~~placed~~ placed / found, bearing ~~346°~~ 346° M from ~~Mast/Plug~~ Mast/Plug / Pillar

5. A. ~~Bankin~~ Bankin ~~Pn~~ Pn set in ~~conc/rock~~ conc/rock has been ~~placed~~ placed / found, bearing ~~332°~~ 332° M from ~~Mast/Plug~~ Mast/Plug / Pillar

6. A. ~~S.S.M.~~ S.S.M. set in conc/ ~~rock~~ rock has been ~~placed~~ placed / found, bearing ~~341°~~ 341° M from ~~Mast/Plug~~ Mast/Plug / Pillar

7. A. ~~S.S.M.~~ S.S.M. set in conc/ ~~rock~~ rock has been ~~placed~~ placed / found, bearing ~~341°~~ 341° M from ~~Mast/Plug~~ Mast/Plug / Pillar

8. Action required: ~~None~~ None

STANDPOINT: Roof Top Pillar S.S.M.

Mark	Direction	Horiz. Distance	Height Difference	Mark	Direction	Horiz. Distance	Height Difference
Goldsweeth (P)	0° 00' 00"	✓	above standard	Goldsweeth (P)	0° 00' 00"	✓	above standard
Bankin (Pillar)	117° 05' 10"	✓	above standard	Bankin (Pillar)	117° 04' 28"	✓	above standard
Bronze Pn	173° 56' 37"	✓	above standard	Bronze Pn	165° 11' 22"	✓	above standard
S.T./S.M.	181° 06' 54"	✓	above standard	S.T./S.M.	179° 53' 42"	✓	above standard
Bellfield (Pillar)	182° 26' 46"	✓	above standard	Bellfield (Pillar)	269° 39' 10"	✓	above standard
	269° 38' 36"	✓	above standard	Roof Top Obs. Pillar	2° 21' 56"	✓	above standard


Prepared by:

Checked:


Noted on U.T.M. Card

Checked

S4 2733-1

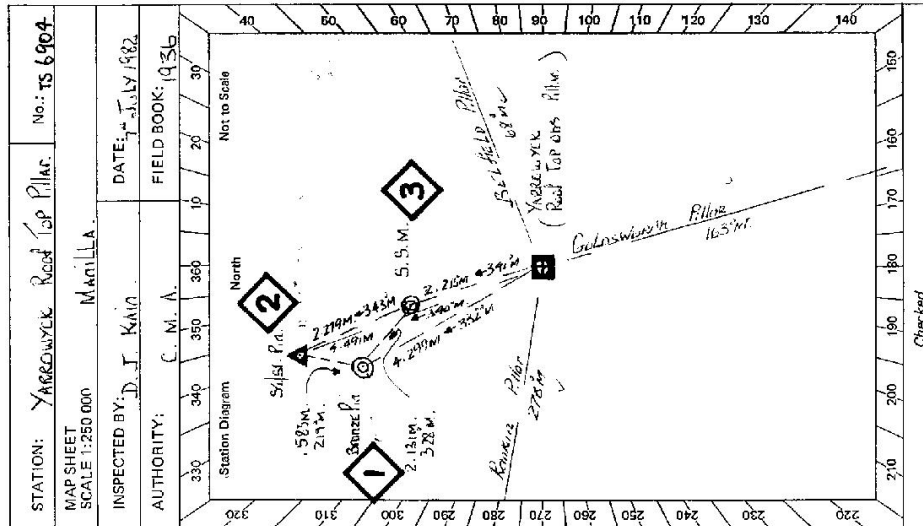

21-2733-2 D. West, Government Printer

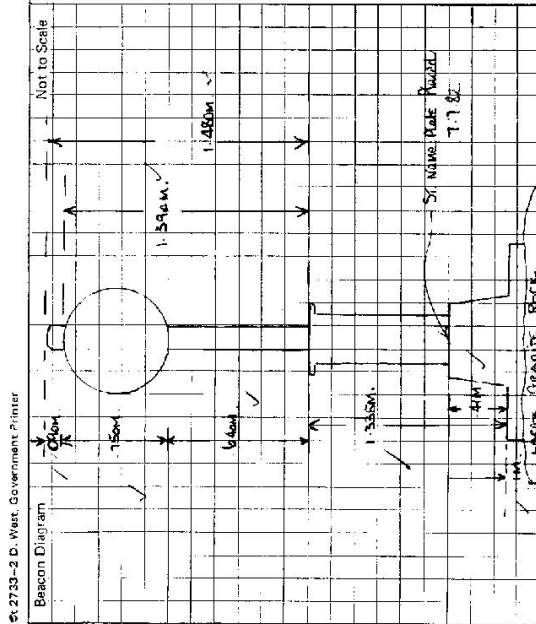

This section to be completed by officer constructing pillar.

Original station mark found/~~not found~~.

Description of mark: 5/5/5 Pin  
Pin  
 Original beacon found/~~not found~~.  
0.02 above Granite Rock  
1.75m above G.L.

Description of beacon: Pole, cones & discsHeight Top of Vane to Top Mark: 3.172 m.Height of mark: 0.30 m. 4 above G.L. (5/5 Pin)Diameter of Vane: 1.012 m.Original Beacon ~~has~~ been destroyed by me.STATION YANOWICK ROOF-Top Obs. Pillar TS 6904Access Owner: Mr. Alan DicksonAddress: Ben DinglePhone: TS 5536ACCESS 7/7/1982Owner's Name: R.S. & F.S. MarshallAddress: WoodstockPhone: TS 5529Access Report of 22.3.1982 was found ~~unsuitable~~Access Route: Feature south along Faulkner Street.Access Point: Post Office heading south along Faulkner Street.Access Direction: Turn Right into McLennan Street.Access Distance: Turn Left after passing under Railway Bridge.Access Time: Turn Right towards Bundarra, Inverell.Access Notes: Cross Inverell Creek.Access Remarks: Concrete bridge over Borealong Creek.Access Status: Turn Right into Property Ben Dingle ahead for about 2 kms.Access Details: (Woodstock is straight ahead for about 2 kms.)Access Location: Cross Grid. Gates on R.H.S. house (Access owner).Access Method: Double wooden gates on R.H.S. house (Access owner).Access Time: Through fence opening in old wire fence on L.H.S. of oldAccess Distance: Through fence opening in old wire fence on L.H.S. of oldAccess Direction: Concrete block Davey follow fence up lane to left.Access Status: Take Right Fork in tracks.Access Remarks: Through old wooden gate.Access Details: Through old wooden gate.Access Location: Take Vee's left at fence corner.Access Method: Leave vehicle at old timber fence.Access Time: Walk up street overAccess Distance: Penic then Veer Right at saddle then to Trip.Access Direction: About one hour walk with light load to station.Access Status: Record of StationAccess Details: Date