

CENTRAL MAPPING AUTHORITY

GEODETTIC SURVEY OF N.S.W.

GEODETTIC STATION RECONNAISSANCE and MAINTENANCE REPORT

Description:

1. Cleared by lances bearing: 330m to 160m ✓ South 62m ✓ 50m to 62m ✓ 165m to 145m ✓ 10m to 50m ✓ 10m Trig. Mast  
Note: Cross out word or words which do not apply

2. Mast & Vanes have been painted white & black respectively. ✓  
 3. The ~~stone~~ pillar was ~~replaced~~ ~~constructed~~ on 1st July 1982, dimensions now being:  
 Description of mark: Steel Pipe should be explicit, e.g. S/Steel Pillar Plate, Steel plug, Brass plug, Bolt, G.I. Pipe

Height of mark: 1.295 m. <sup>above</sup> 1.525 m. <sup>above</sup> G.L.  
 Height of Top Vanes to Top Mark/Pillar plate: 1.430 m. Diameter of Vanes (vertical): 0.755 m.

Height of Cairn: ..... m. Diameter of Cairn: ..... m. Name Plate found/not ~~found~~/placed.  
 NOTE: ORIGINAL GAUPE FOUND DESTROYED ✓  
 Length of Mast: ..... m. (approximate if not unplied)

4. A Brass Trig Plug set in conc/rock has been placed/found, bearing: .....°M from Mast/Plug/Pillar  
 5. A SS.M set in conc/rock has been placed/found, bearing: 217°M from ~~Mast~~/Mast/Pillar  
 6. A Copper Nail set in conc/rock has been placed/~~found~~, bearing: 3°M from ~~Mast~~/Mast/Pillar

7. A ..... set in conc/rock has been placed/found, bearing: .....°M from Mast/Plug/Pillar  
 8. Action required: PLEASE NOTE: Conc Obs Pillar has been RACED OVER BRASS TRIG PLUG


STANDPOINT: BRASS TRIG PLUG      STANDPOINT: CONC OBS PILLAR

Mark	Direction	Horiz. Distance	Height Difference	Direction	Horiz. Distance	Height Difference
RAZORBACK CSO	00 00		above standpt.	0 00 00		above standpt.
NATTAI CSO	58 00 00		above standpt.	58 00 00		above standpt.
SS.M	97 44 20	3.649	below standpt.	97 40 50	3.605	below standpt.
HARRIS M.H.	218 34 00		above standpt.	218 33 40		above standpt.
COPPER NAIL	243 50 40	5.045	below standpt.	243 55 00	5.047	below standpt.

Prepared by: P. Potts 26-7-82.      Checked: AS 27-7-82

Checked

Sr 2733-1

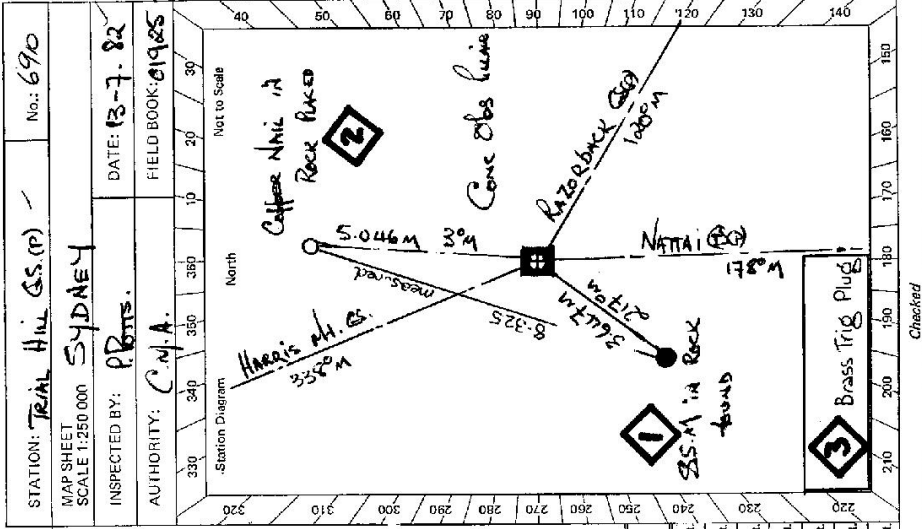

STATION: TRIAL HILL CSO ✓      No.: 690  
 MAP SHEET SYDNEY  
 SCALE 1:250,000  
 INSPECTED BY: P. POTTS      DATE: 13-7-82  
 AUTHORITY: C.M.A.      FIELD BOOK: 01905

STATION **TRIAL HILL (SP)** TS 6910


Owner's Name: **CROWN LAND PROCLAIMED**  
 Current Occupant: **RANGER M/R ARTHUR BRADLEY**  
 Address: **THE OAKS**  
 Phone: **096 571111**

ACCESS

Access Report of 13/7/1988 was found suitable/unsuitable.

FEATURE

KM 0.00 **POST OFFICE 'THE OAKS' TRAVEL SOUTH WEST ON JOHN STREET**  
 0.21 **TOWARDS 'DARDALE', 'BURRABORANG VALLEY'; 'NARRAI'**  
 5.94 **TURN RIGHT SIEN 'DARDALE'**  
 7.21 **PASS 'DARDALE' POST OFFICE ON RIGHT**  
 8.48 **TURN RIGHT SIEN 'DARDALE' & BEIMSTONE COLLIERY**  
 10.17 **TURN RIGHT SIEN 'BEIMSTONE COLLIERY'**  
 17.88 **TAKE LEFT FORK SIEN 'BEIMSTONE NO.1.'**  
 18.36 **TURN LEFT OPPOSITE 'BEIMSTONE NO.1. COLLIERY'**  
 18.49 **TURN RIGHT ONTO 'N10B GRANIEL ROAD'**  
 18.66 **CONCRETE WATER TANK**  
 20.97 **PASS 'N10L TRACK' ON RIGHT**  
 23.32 **TURN LEFT - PASS BY 10M ON RIGHT**  
 24.14 **TURN RIGHT ONTO 'N10 N TRACK'**  
 24.58 **TRIAL HILL (SP)**

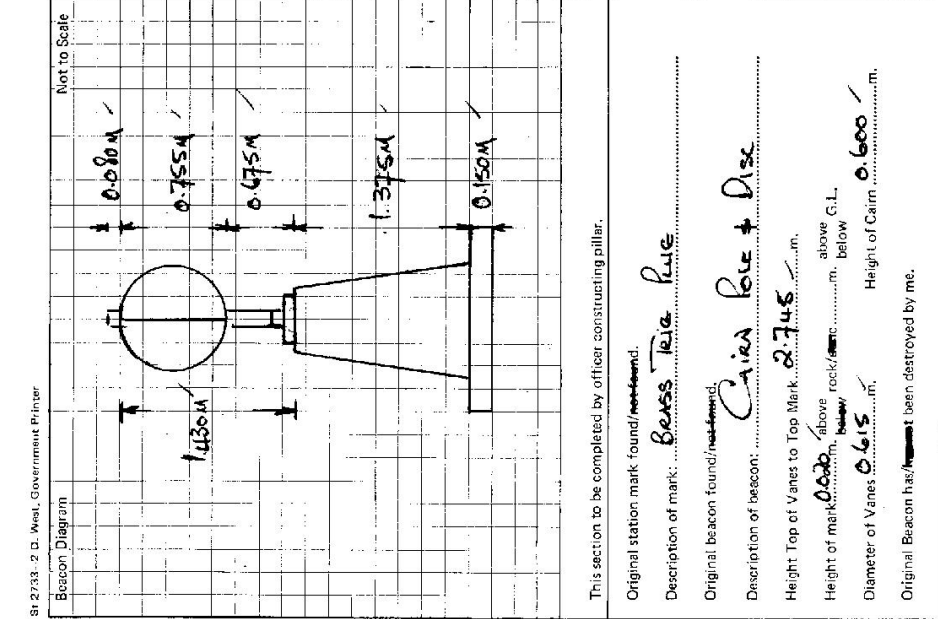

This section to be completed by officer constructing pillar.

Original station mark found/~~not found~~.

Description of mark: **Stainless Trig. Pole**

Original beacon found/~~not found~~.

Description of beacon: **Cairn Pole + Disc**

Height Top of Vanes to Top Mark: **2.745** m.

Height of mark: **0.600** m. above G.L. **0.600** m. below

Diameter of Vanes: **0.615** m. Height of Cairn: **0.600** m.

Original Beacon has/~~has not~~ been destroyed by me.

Date	Record of Station