

CENTRAL MAPPING AUTHORITY

GEODETIC SURVEY OF A.S.W.

GEODETIC STATION RECONNAISSANCE and MAINTENANCE REPORT

Description:

1. Cleared by James bearing **NEU** Note: Cross out word or words which do not apply
2. Mast & Vanes have been painted white & black respectively.
3. The station/pillar was unpiled/not unpiled/constructed on **577A**, dimensions now being:

Description of mark..... should be explicit, e.g., S/Steel **M**lar Plate, Steel plug, Brass plug, Bolt, G.I. Pipe

Height of mark.....m. <sup>above</sup> rock/rock **19** Mark is..... <sup>above</sup> **19** G.L.

Height of Top Vanes to Top Mark/Pillar plate.....m. Diameter of Vanes (vertical).....m.

Height of Cairn.....m. Diameter of Cairn.....m. Name Plate found/not found/placed.

Length of Mast.....m. (approximate if not unpiled)

4. A..... set in conc/rock has been placed/found, bearing.....° M from Mast/Plug/Pillar

5. A..... set in conc/rock has been placed/found, bearing.....° M from Mast/Plug/Pillar

6. A..... set in conc/rock has been placed/found, bearing.....° M from Mast/Plug/Pillar

7. A..... set in conc/rock has been placed/found, bearing.....° M from Mast/Plug/Pillar

8. Action required: **Construct pillar + witness marks**

STANDPOINT:

Mark	Direction	Horiz. Distance	Height Difference	Mark	Direction	Horiz. Distance	Height Difference
COONBARI	17°20'	26km	above standpt				above standpt
BULL MOUNTAIN	33°01'	22km	above standpt				above standpt
TOLCUMBER	50°00'	26km	above standpt				above standpt
GUNNIBLE	93°45'	13km	above standpt				above standpt
GUNNEDAN	189°01'	9km	above standpt				above standpt
GROOGLINDARDI	282°20'	14km	above standpt				above standpt
BIMBARONG	323°50'	13km	above standpt				above standpt

Prepared by: **C. J. M620**

Checked:

Noted on U.T.M. Card

SF 2733-1

STATION: **PILATUS** No.: **6916**


MAP SHEET SCALE 1:250 000

INSPECTED BY: **D. MOSS**

DATE: **19.7.82**

AUTHORITY: **C.M.A**

FIELD BOOK: **AB 2001**

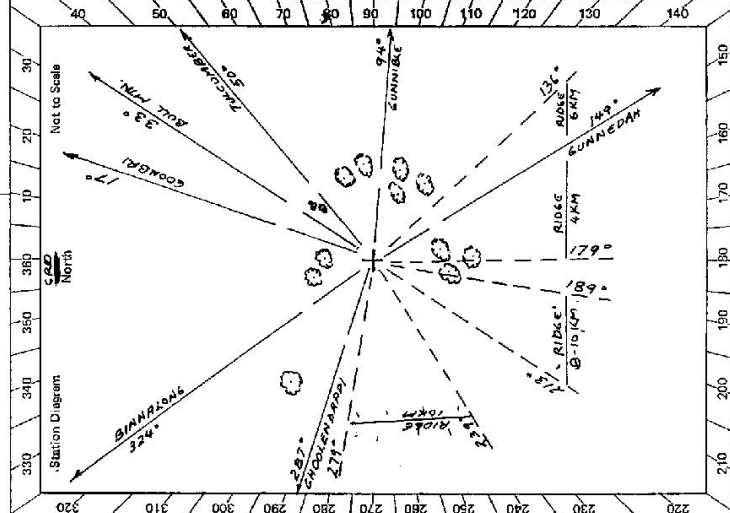

Checked





