




STATION **DRUID (P) TS 6917**

LEASEE'S  
 Owner's Name: **J.B. & MC. TAMBOA**  
 Address: **"YAMBARCOONA"**  
 Phone: **BRE 315**  
 Current Occupant:  
 Address:  
 Phone:

**ACCESS**

Access Report of 17.8.19 was found suitable/unsuitable.

- 0.00 PO BREWARRINA HEAD WEST ON BATHURST ST.
- 0.4 ROYAL HIT ON LEFT GRID
- 1.5 GRID
- 4.35 AIR FIELD ON LEFT
- 6.85 END OF BITUMEN GRID
- 10.15 CROSS CHANNEL GRID
- 12.9 GRID
- 16.4 GRID
- 18.8 B 80 (SIGN) GRID
- 21.2 GRID
- 25.8 GRID
- 27.35 B 70 (SIGN) GRID
- 29.0 GRID
- 29.5 GRID
- 30.5 BACK OF SIGN BAY 30 AND BACK OF CAUSEWAY SIGN TURN RIGHT AND HEAD UP TOWARDS HILL ON FAINT TRACK
- 31.4 DRUID GS

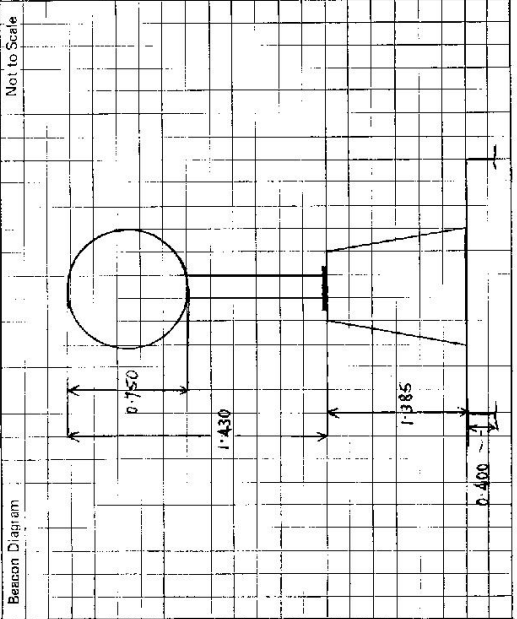

Beacon Diagram

Not to Scale

This section to be completed by officer constructing pillar.

Original station mark found/net-found.  
 Description of mark: **BRASS TRIG. PLUG**  
 Original beacon found/net-found.  
 Description of beacon: **CAIRN POLE & DISC**  
 Height Top of Vanes to Top Mark: **2.560** m.  
 Height of mark: **0.400** m. above rock/ceac. below  
 Diameter of Vanes: **0.750** m. Height of Cairn: **1.500** m.  
 Original Beacon has/has not been destroyed by me.

**Record of Station**

Date

31.4

DRUID GS

CENTRAL MAPPING AUTHORITY

GEODETIC SURVEY OF N.S.W.

GEODETIC STATION RECONNAISSANCE and MAINTENANCE REPORT

Description:

- Cleared by lanes bearing  $55^{\circ}-760^{\circ}$ ,  $707^{\circ}-230^{\circ}$ ,  $705^{\circ}-333^{\circ}$ . Note: Cross out word or words which do not apply
- Mast & Vanes have been painted white & black respectively. See M.G. Foid's Report of 17.8.82
- The station/pillar was unpiled/not unpiled/constructed on ..... 19..... dimensions now being:

Description of mark.....should be explicit, e.g., S/Steel Pillar Plate, Steel plug, Brass plug, Bolt, G.I. Pipe

Height of mark.....m. above rock/concrete; Mark is.....m. above G.L.

Height of Top Vanes to Top Mark/Pillar plate.....m. Diameter of Vanes (vertical).....m.

Height of Cairn.....m. Diameter of Cairn.....m. Name Plate found/not found/placed.

Length of Mast.....m. (approximate if not unpiled)

- A.....set in conc/rock has been placed/found, bearing.....°M from Mast/Plug/Pillar
- A.....set in conc/rock has been placed/found, bearing.....°M from Mast/Plug/Pillar
- A.....set in conc/rock has been placed/found, bearing.....°M from Mast/Plug/Pillar
- A.....set in conc/rock has been placed/found, bearing.....°M from Mast/Plug/Pillar

Action required: Name plate to be placed

STANDPOINT: Concrete Pillar

STANDPOINT: Trig Plug in code.

Mark	Direction	Horiz. Distance	Height Difference	Mark	Direction	Horiz. Distance	Height Difference
BENDEMEER Trig Plug	$0^{\circ} 00' 00''$	3.152	1.652 above	BENDEMEER Plug	$0^{\circ} 00' 00''$	3.100	1.500 above
Drill Hole in Rock	$178^{\circ} 28' 70''$	2.200	1.680 below	Drill Hole in Rock	$56^{\circ} 29' 30''$	4.122	0.187 above
SSM in Rock	$182^{\circ} 03' 20''$	3.159	0.254 below	Drill Hole in Rock	$51^{\circ} 51'$	5.061	0.189 below
Astro Pillar	$236^{\circ} 17' 00''$	3.100	1.500 above	Astro Pillar	$12^{\circ} 08'$	2.867	1.244 above
Drill Hole in Rock	$223^{\circ} 58' 20''$	13.734	1.751 below	Concrete Pillar	$710^{\circ} 12' 10''$	0.229	0.251 below
Copper nail R.M.1	$257^{\circ} 41'$	6.513	1.762 above	Copper nail R.M.2	$774^{\circ} 57' 30''$	3.781	0.202 below
Copper nail R.M.2	$355^{\circ} 00' 30''$	5.768	2.618 below	Copper nail R.M.3	$15^{\circ} 34' 50''$	7.741	0.202 below
			above				above
			below				below
			above				above
			below				below
			above				above
			below				below

Prepared by: I. N. Robins


Checked: J. ...

Noted on U.T.M. Card

19/10/82

Checked: ...

8: 2743-1

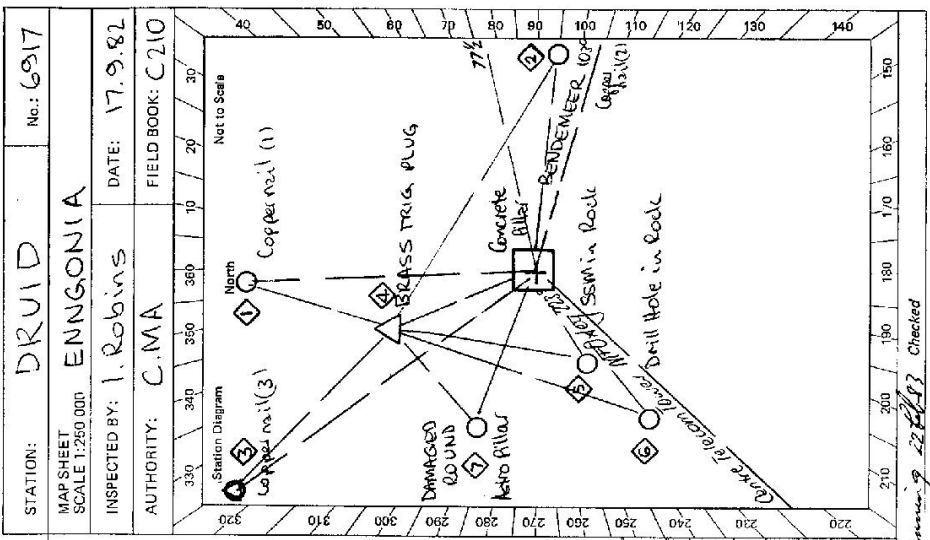


STATION: DRUID No.: 6917

MAP SHEET SCALE 1:250,000 ENNGONIA

INSPECTED BY: I. Robins DATE: 17.9.82

AUTHORITY: C.M.A. FIELD BOOK: C210

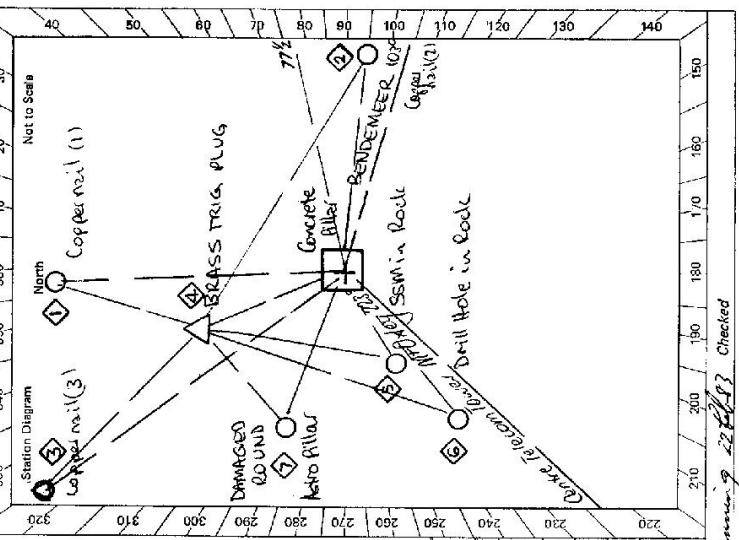

64.2735-2 D. West, Government Printer	STATION <b>DRUID G.S. 136917</b>	<table border="1" style="width: 100%; border-collapse: collapse;"> <tr> <td style="width: 30%;">                             Owner's Name: .....                              Address: .....                              Phone: .....                         </td> <td style="width: 30%;">                             Current Occupant: .....                              Address: .....                              Phone: .....                         </td> <td style="width: 40%; vertical-align: top;">                             Access Report of <u>17.9.1982</u> was found suitable/unsuitable.   <b>See Mr. G. Ford's access of 17-8-82.</b> </td> </tr> </table>	Owner's Name: ..... Address: ..... Phone: .....	Current Occupant: ..... Address: ..... Phone: .....	Access Report of <u>17.9.1982</u> was found suitable/unsuitable.  <b>See Mr. G. Ford's access of 17-8-82.</b>
Owner's Name: ..... Address: ..... Phone: .....	Current Occupant: ..... Address: ..... Phone: .....	Access Report of <u>17.9.1982</u> was found suitable/unsuitable.  <b>See Mr. G. Ford's access of 17-8-82.</b>			
Beacon Diagram <span style="float: right;">Not to Scale</span>		<table border="1" style="width: 100%; border-collapse: collapse;"> <tr> <td style="width: 100%; height: 150px; vertical-align: middle; text-align: center;">                             SEE MR G. FORD'S REPORT OF 17/8/82                         </td> </tr> </table>	SEE MR G. FORD'S REPORT OF 17/8/82		
SEE MR G. FORD'S REPORT OF 17/8/82					
This section to be completed by officer constructing pillar. Original station mark found/not found.		Description of mark: <b>SEE ABOVE</b>			
Original beacon found/not found.		Description of beacon: .....			
Height Top of Vanes to Top Mark ..... m.		Height of mark: ..... m. <span style="margin-left: 20px;">above G.L.</span> <span style="margin-left: 20px;">below</span>			
Diameter of Vanes ..... m.		Height of Cairn: ..... m.			
Original Beacon has/had not been destroyed by me.		Date: <b>17.9.82</b> Record of Station: <b>Connections Measured I.W. Robinson, T.S.</b>			

**LAND INFORMATION CENTRE**

GEODETIC SURVEY OF N.S.W.

**GEODETIC STATION RECONNAISSANCE and MAINTENANCE REPORT**

**Description:**

1. Cleared by lanes bearing 52°N - 225°M 305°N - 335°M 305°N - 335°M from Trig. Mast  
 Note: Cross out word or words which do not apply

2. Mast & Vanes have been painted white & black respectively. ✓

3. The station/pillar was unpiled/not unpiled/constructed on ..... 19 ..... m, dimensions now being:

Description of mark..... should be explicit, e.g., S/Steel Pillar Plate, Steel plug, Brass plug, Bolt, G.I. Pipe

Height of mark.....m. <sup>above</sup> rock/concrete; Mark is.....m. <sup>above</sup> <sub>below</sub> G.L.

Height of Top Vanes to Top Mark/Pillar plate .....m. Diameter of Vanes (vertical).....m.

Height of Cairn.....m. Diameter of Cairn.....m. Name Plate found/not found/placed.

Length of Mast .....m. (approximate if not unpiled)

4. A..... set in conc./rock has been placed/found, bearing.....°M from Mast/Plug/Pillar

5. A..... set in conc./rock has been placed/found, bearing.....°M from Mast/Plug/Pillar

6. A..... set in conc./rock has been placed/found, bearing.....°M from Mast/Plug/Pillar

7. A..... set in conc./rock has been placed/found, bearing.....°M from Mast/Plug/Pillar

8. Action required:.....

**STANDPOINT:**

Mark	Direction	Horiz. Distance	Height Difference	Mark	Direction	Horiz. Distance	Height Difference
			above standpt.				above standpt.
			below				below
			above standpt.				above standpt.
			below				below
Prepared by: S. P. 13/1/90 Checked: [Signature] Noted on U.T.M. Card

STATION: DRUID (P) TS No.: 6917  
 MAP SHEET SCALE 1:250 000 ENNGONIA  
 INSPECTED BY: G. FORD DATE: 1/11/90  
 AUTHORITY: L. I. C. FIELD BOOK: 1951

Station Diagram

Not to Scale

COPPER NAIL 1 FD  
 COPPER NAIL 2 FD  
 COPPER NAIL 3 FD  
 SSM FD  
 DRILL HOLE FD  
 BRASS TRIG PLUG FD

ALL IN ROCK

CAN SEE: MCIRA HILL & TOWER.  
 BENDMEER HILL  
 TOWARDS BREWARRINA

STATION CLEARED FOR G.P.S. USE  
 " PAINTED.

320 330 340 1500

Checked

<p>STATION <b>DRUID (P) TS 6917</b></p>	<p>Owner's Name: <b>J.B. * M.C. TAYLOR</b>                  Address: <b>"YAMBACCOONA"</b>  <b>068 7832 EXCHANGE THEN EXT 315</b>                  Phone: <b>068 744901</b></p> <p>Current Occupant: .....                  Address: .....                  Phone: .....</p> <p style="text-align: center;"><u>ACCESS</u></p> <p>Access Report of <b>11/11/1990</b> was found suitable/unsuitable.</p> <p><b>0.00 P.O. BREWARRINA HEAD WEST ALONG BATHURST ST TOWARDS BOURNE</b></p> <p><b>1.54 GRID</b></p> <p><b>4.87 PASS ROAD TO AIRPORT ON LEFT</b></p> <p><b>26.20 LANE ON RIGHT AT WHITE MAILBOX TO OWNERS PROPERTY "YAMBACCOONA"</b></p> <p><b>30.50 TURN RIGHT ONTO TRACK TOWARDS TOWER</b></p> <p><b>30.90 AT TELCOM TOWER TURN LEFT</b></p> <p><b>30.93 MEET FAINT TRACK FOLLOW UP TO RIGHT</b></p> <p><b>31.31 D RUID TRIG</b></p> <p style="text-align: center;"><b>[AWD FROM 30.93]</b></p> <p style="text-align: center;"><b>35-40 MINS FROM BREWARRINA.</b></p> <p style="text-align: center;"><b>[ADVANCE BOOKING FOR ACCOMMODATION ADVISED BREWARRINA]</b></p>										
<p>Beacon Diagram</p> <p style="text-align: right;">Not to Scale</p>	<p>This section to be completed by officer constructing pillar.</p> <p>Original station mark found/not found. ....</p> <p>Description of mark: .....</p> <p>Original beacon found/not found. ....</p> <p>Description of beacon: .....</p> <p>Height Top of Vane to Top Mark.....ft.</p> <p>Height of mark.....m. above G.L. below</p> <p style="padding-left: 100px;">rocks/conc.....m. below</p> <p>Diameter of Vane.....m. Height of Cairn.....m.</p> <p>Original Beacon has/has not been destroyed by me.</p>										
	<table border="1" style="width: 100%; border-collapse: collapse;"> <thead> <tr> <th style="width: 50%;">Date</th> <th style="width: 50%;">Record of Station</th> </tr> </thead> <tbody> <tr> <td> </td> <td> </td> </tr> <tr> <td> </td> <td> </td> </tr> <tr> <td> </td> <td> </td> </tr> <tr> <td> </td> <td> </td> </tr> </tbody> </table>	Date	Record of Station								
Date	Record of Station										