

CENTRAL MAPPING AUTHORITY


GEODETIC SURVEY OF N.S.W.
 GEODETIC STATION RECONNAISSANCE and MAINTENANCE REPORT

STATION: **BULLANGINYA (Proposed)** No: **6924**

MAP SHEET SCALE 1:250 000 **SERILDERIE**

INSPECTED BY: **K. HADDEN** DATE: **22-7-82**

AUTHORITY: **C.M.A.** FIELD BOOK: **C174**

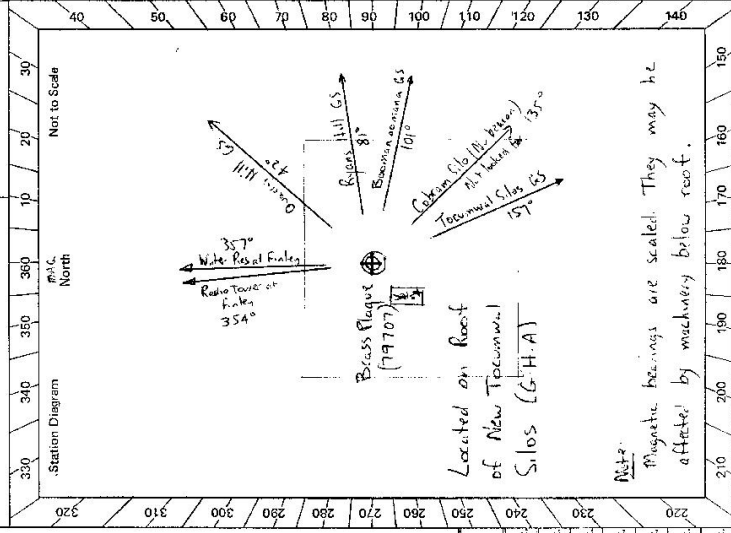

- Description:
- Cleared by lances bearing..... *Note: Cross out word or words which do not apply*..... from Trig. Mast
 - Mast & Vanes have been painted white & black respectively.
 - The station/pillar was unpiled/not unpiled/constructed on..... 19....., dimensions now being: Description of mark..... should be explicit, e.g., S/Steel Pillar Plate, Steel plug, Brass plug, Bolt, G.I. Pipe
 Height of mark.....m. above rock/concrete; Mark is.....m. above G.L.
 Height of Top Vanes to Top Mark/Pillar plate.....m. Diameter of Vanes (vertical).....m.
 Height of Cairn.....m. Diameter of Cairn.....m. Name Plate found/not found/placed.
 Length of Mast.....m. (approximate if not unpiled)
 - A.....set in conc/rock has been placed/found, bearing.....°M from Mast/Plug/Pillar
 - A.....set in conc/rock has been placed/found, bearing.....°M from Mast/Plug/Pillar
 - A.....set in conc/rock has been placed/found, bearing.....°M from Mast/Plug/Pillar
 - A.....set in conc/rock has been placed/found, bearing.....°M from Mast/Plug/Pillar
 - Action required: *Construction of Roof Top Steel Pillar (if approved by C.H.A)*

STANDPOINT:			
Mark	Direction	Horiz. Distance	Height Difference
			above standpt.
			below standpt.
			above standpt.
			below standpt.
Prepared by: **K.S. Huddlestone** 30-7-82
 Noted on U.T.M. Card
 Checked

6: 2723--2 D. West, Government Printer

STATION BULLANGUNYA (Passive) 6924

Beacon Diagram	Not to Scale
No Beacon	

Owner's Name: G.A. Harris, Hamilton, Authority of N.S.W. Current Occupant:
 Address: Silo Road
 Phone: Tocumwal
 Phone:
 ACCESS

Access Report of 24.7.1982 was found suitable/unsuitable.

Note: If silo not operating then keys will have to be obtained from G.H.A at Narrandera

Located on G.H.A Silo located in Silo Road Tocumwal.

This section to be completed by officer constructing pillar.

Original station mark found/not found.

Description of mark:

Original beacon found/not found.

Description of beacon

Height Top of Vanes to Top Mark

Height of mark

Diameter of Vanes

Original Beacon has/has not been destroyed by me.

Date	Record of Station

GEODETTIC SURVEY OF N.S.W.

CENTRAL MAPPING AUTHORITY

GEODETTIC STATION RECONNAISSANCE and MAINTENANCE REPORT

- Description: **360 M** / Note: Cross out word or words which do not apply
1. Cleared by lanes bearing..... from Trig. Mast
2. Mast & Vanes have been painted white & black respectively. -
3. The ~~station~~/pillar was ~~unplaced~~/reconstructed on **3rd September 82**, dimensions now being: **Boortop Pine** should be explicit, e.g., S/Steel Pillar Plate, Steel plug, Brass plug, Bolt, G.I. Pipe
- Description of mark..... **Boortop Pine** should be explicit, e.g., S/Steel Pillar Plate, Steel plug, Brass plug, Bolt, G.I. Pipe
- Height of mark..... **1.310 m** above ~~rock/concrete~~ / **1.470 m** above ~~rock/concrete~~ / **Concrete Roofs**
- Height of Top Vanes to Top ~~rock/concrete~~ / **0.900 m** / **0.750 m** Diameter of Vanes (vertical).....
- Height of Cairn..... m. Diameter of Cairn..... m. Name Plate found/not ~~found~~/placed.
- Length of Mast..... m. (approximate if not unplaced)
4. **TRIG MAST (BRASS ROSE)** set in conc/rock has been ~~placed~~/found, bearing..... **57° M** from ~~rock/concrete~~/Pillar
5. **Copper Nail** set in conc/rock has been placed/~~found~~, bearing..... **3° M** from ~~rock/concrete~~/Pillar
6. **A**..... set in conc/rock has been placed/~~found~~, bearing..... **° M** from Mast/Plug/Pillar
7. **A**..... set in conc/rock has been placed/~~found~~, bearing..... **° M** from Mast/Plug/Pillar
8. Action required:.....

STANDPOINT: Boortop Pine		STANDPOINT: TRIG MAST 79707	
Mark	Direction	Horiz. Distance	Height Difference
Ryans Hill ESP	0 00 00		above standpt.
Cobram Sino	54 32 20		above standpt.
Copper Nail	279 26 46	2.846	7.440 above standpt.
TRIG 79707	327 24 50	2.579	1.474 above standpt.
			below
			below
Prepared by: **Phane 14 September 1982** / **21/9/82** signed on U.T.M. Card

S.2733-1

STATION: **BULLANSINYA G.I.(P)** No.: **6924**

MAP SHEET SCALE 1:250 000

INSPECTED BY: **PHTS** DATE: **13.9.82**

AUTHORITY: **C.M.A.** FIELD BOOK: **1668**

Station Diagram

Not to Scale

Checked

STATION **BULLANGENYA G.S.P.** 6924

Current Occupant: **GRAIN HANDLING**
 Address: **AMERINDIA GRAIN CORP**
 Phone: **080-834114**

Quarry Name: **LOCATED ON TOCUMNAL SILO**
 Address: **UNDER CONTROL OF**
 Phone:

ACCESS

Access Report of 12/1/1982 was found suitable/unsuitable.


- K.M. 0.00 **RAIL OFFICE TOCUMNAL HEAD WEST**
- 0.20 **TURN RIGHT SIEN MELLEBOURNE**
- 0.26 **STRAIGHT AHEAD**
- 0.90 **CROSS RAILWAY INTO SILO ROAD SIGN FULLY**
- 1.56 **TURN RIGHT TOCUMNAL SILO G.M.A. of N.S.W.**
- 2.36 **TOCUMNAL SILO - BULLANGENYA G.S.P. ON FOOT OF SILO**
- 2.61 **KEY FROM HARRANDRA.**

16/7/92

*NOTE FOR ACCESS TELEPHONE

MR KEITH GILL GRAIN HANDLING AUTHORITY
 WARRGA WARRGA

[Signature]

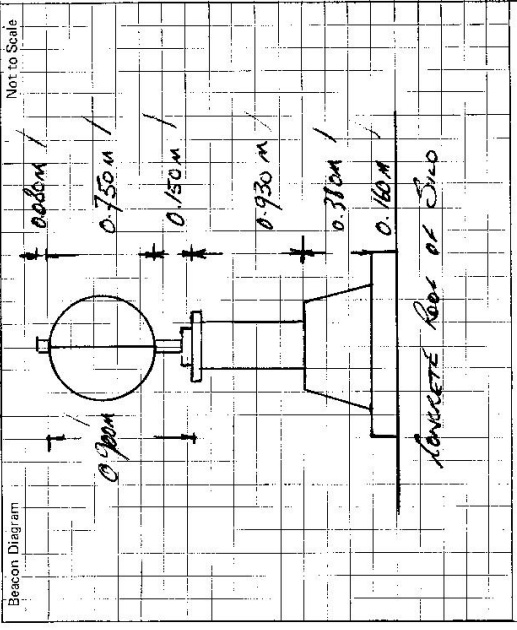

Beacon Diagram Not to Scale

This section to be completed by officer constructing pillar.

Original station mark found/not found.

Description of mark:

Original beacon found/not found.

Description of beacon:

Height Top of Vane to Top Mark:m.

Height of mark:m. above G.L. /m. below

Diameter of Vane:m. Height of Cairn:m.

Original Beacon has/has not been destroyed by me.

Date	Record of Station

LAND INFORMATION CENTRE **GEODETIC SURVEY OF S.S.W.**

GEODETIC STATION, RECONNAISSANCE and MAINTENANCE REPORT

STATION: BULLANG INYA (P) **No.:** 6924

MAP SHEET **1:100000 BERRIGAN**

SCALE 1:250 000 **DATE:** 29 July 1992

INSPECTED BY: J. SUTTON **FIELD BOOK:** Z10B

AUTHORITY: LIC

Station Diagram
Located on Roof of
100mm x 150mm Silo

Description:
 Note: Cross out word or words which do not apply
 1. Cleared by trees/bearing..... Full 260° Visibility..... from Trig. Mast

2. Mast & Vanes have been painted white & black respectively.

3. The station/pillar was unplaced/removed on 29th July 1992, dimensions now being:
 S/Steel Pillar
 Description of mark..... should be explicit, e.g., S/Steel Pillar Plate, Steel plug, Brass plug, Bolt, G.I. Pipe

Height of mark..... 1.475 m above rock/concrete; Mark is..... above G.L.

Height of Top Vanes to Top Mast/Pillar plate..... 0.900 m. Diameter of Vanes (vertical)..... 0.150 m.

Height of Cairn..... m. Diameter of Cairn..... m. Name Plate found/.....

Length of Mast..... 1.0 m. (approximate if not implied)

4. A Brass Plate 15719107 set in conc/..... has been placed/..... M. from Mast/Pillar

5. A Brass A.C. Nail..... set in conc/..... bearing..... M. from Mast/Pillar

6. A..... set in conc/rock has been placed/..... M. from Mast/Pillar

7. A..... set in conc/rock has been placed/..... M. from Mast/Pillar

8. Action required: Nil


STANDPOINT: BULLANG INYA (P)				STANDPOINT: Brass Triangle Survey Cu Nail			
Mark	Direction	Horiz. Distance	Height Difference	Mark	Direction	Horiz. Distance	Height Difference
Cobram Silo	0° 00' 00"	2.844	1.466	Cobram Silo	0° 00' 00"	2.844	1.468
Brass Triangle	72° 32' 48"	2.844	1.466	Bullanginya (P)	42° 33' 18"	2.844	1.468
Brass Plate 15719107	272° 49' 30"	2.578	1.472	Brass Plate 15719107	345° 09' 35"	2.217	0.004
Standpoint: Brass Plate 15719107	0° 00' 00"	15.719107	Standpoint: Brass Plate 15719107	0° 00' 00"	15.719107
Bullanginya (P)	92° 50' 45"	2.577	1.474	Bullanginya (P)	92° 50' 45"	2.577	1.474
Brass Triangle	165° 08' 12"	2.217	0.000	Brass Triangle	165° 08' 12"	2.217	0.000

Prepared by: J. Sutton 6.8.92 Checked: M. 10/9/2

Note on U.T.M. Grid

2723-2 D West, Government Printer

Beacon Diagram: Not to Scale

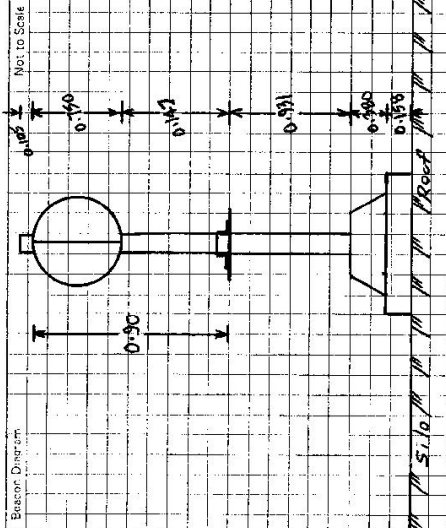

STATION **BULLANGINYA (P) 6924**

Owner's Name: **GRAIN CORP NSW**
 Address: **Mentworth Street**
WAGGA WAGGA

Contact: **Les Smith**
 Address: **Mentworth Street**
WAGGA WAGGA
 Phone: **(069) 211 231**

ACCESS: **29-7-1992**

Access Report of **29-7-92** was found **unsuitable**.

km.
 0.0 From Tocumwal Post Office head West along Deniliquin Street.
 0.20 Turn right into Murray Street.
 0.26 Turn left into Deniliquin Street.
 0.75 At roundabout, go straight ahead.
 1.00 Cross railway lines.
 1.55 Turn right along Silo Road.
 2.40 Go through locked gate near silos. Follow road, passing weighbridge on left.
 2.65 At silo base. Access is through locked silo door and up stairs (4 mins). Go through manhole to Trigon roof.

This section to be completed by officer constructing pillar.

Original station mark found/not found.

Description of mark:

Original beacon found/not found.

Description of beacon:

Height: Top of Vane to Top Markm.
 Height of markm. above rock/groundm. below
 Diameter of Vanem. Height of Galv.m.
 Original Beacon has/has not been destroyed by fire.

Date	Record of Station