

TS 6927

CENTRAL MAPPING AUTHORITY

GEODETTIC SURVEY OF N.S.W.
GEODETTIC STATION RECONNAISSANCE and MAINTENANCE REPORT

STATION: SNOWDEN

No.: 4421

MAP SHEET
SCALE 1:250 000


TAMWORTH

INSPECTED BY: G.C. HANNA

DATE: 19/1/79

AUTHORITY:

FIELD BOOK:

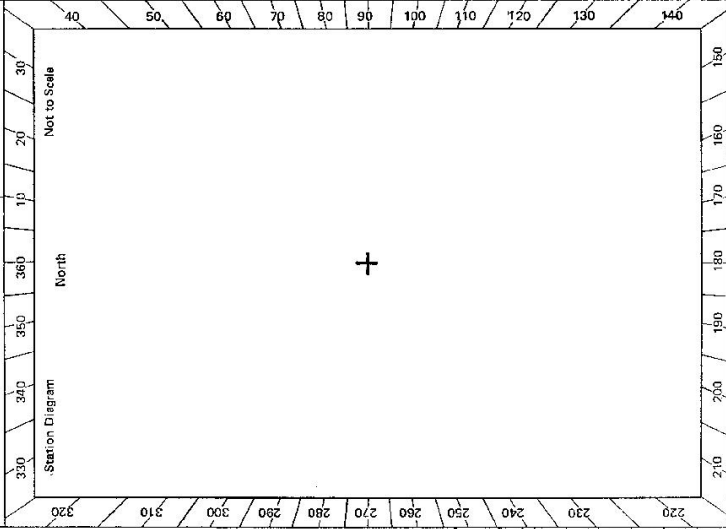

Description:

Note: Cross out word or words which do not apply

1. Cleared by lanes bearing..... from Trig. Mast
2. Mast & Vanes have been painted white & black respectively.
3. The station/pillar was unpiled/not unpiled/constructed on.....19....., dimensions now being:
Description of mark..... should be explicit, e.g., S/Steel Pillar Plate, Steel plug, Brass plug, Bolt, G.I. Pipe
Height of mark.....m. ^{above} rock/concrete; Mark is.....m. ^{above} G.L.
Height of Top Vanes to Top Mark/Pillar plate.....m. Diameter of Vanes (vertical).....m.
Height of Cairn.....m. Diameter of Cairn.....m. Name Plate found/not found/placed.
Length of Mast.....m. (approximate if not unpiled)
4. A..... set in conc/rock has been placed/found, bearing.....°M from Mast/Plug/Pillar
5. A..... set in conc/rock has been placed/found, bearing.....°M from Mast/Plug/Pillar
6. A..... set in conc/rock has been placed/found, bearing.....°M from Mast/Plug/Pillar
7. A..... set in conc/rock has been placed/found, bearing.....°M from Mast/Plug/Pillar
8. Action required:.....

STANDPOINT:			
Mark	Direction	Horiz. Distance	Height Difference
			above standpt
			below
			above standpt
			below
Prepared by: 44 2/1/79 Checked: 44 2/1/79 Agreed on U.T.M. Card

ST 2733-1

Checked

GS

STATION SNOWDEN TS 6927	<table border="1" style="width: 100%; border-collapse: collapse;"> <tr> <td style="width: 50%; vertical-align: top;"> Owner's Name: Address: Phone: Access Report of 12/11/1977 was found suitable/unsuitable. </td> <td style="width: 50%; vertical-align: top;"> Current Occupant: Address: Phone: See also Wablabadah 2034-1-N </td> </tr> </table> <div style="text-align: center;"> <p style="text-align: center;">Not to Scale Cairn, mast & vanes still in good condition 360 vision. 2 minute walk to trig</p> </div>	Owner's Name: Address: Phone: Access Report of 12/11/1977 was found suitable/unsuitable.	Current Occupant: Address: Phone: See also Wablabadah 2034-1-N
Owner's Name: Address: Phone: Access Report of 12/11/1977 was found suitable/unsuitable.	Current Occupant: Address: Phone: See also Wablabadah 2034-1-N		
Beacon Diagram Not to Scale [Grid area for diagram]	This section to be completed by officer constructing pillar. Original station mark found/not found. Description of mark: Original beacon found/not found. Description of beacon: Height Top of Vanes to Top Markm. Height of markm. above G.L.m. below Diameter of Vanesm. Height of Cairnm. Original Beacon has/has not been destroyed by me.		
Date	Record of Station		

GEODETIC SURVEY OF N.S.W.

CENTRAL MAPPING AUTHORITY


GEODETIC STATION RECONNAISSANCE and MAINTENANCE REPORT

STATION: **SNOWDEN (P)** No.: **6927**

MAP SHEET SCALE 1:250 000 **TAMWORTH**

INSPECTED BY: **G FORD** DATE: **6-9-82**

AUTHORITY: **CMA** FIELD BOOK: **1929**

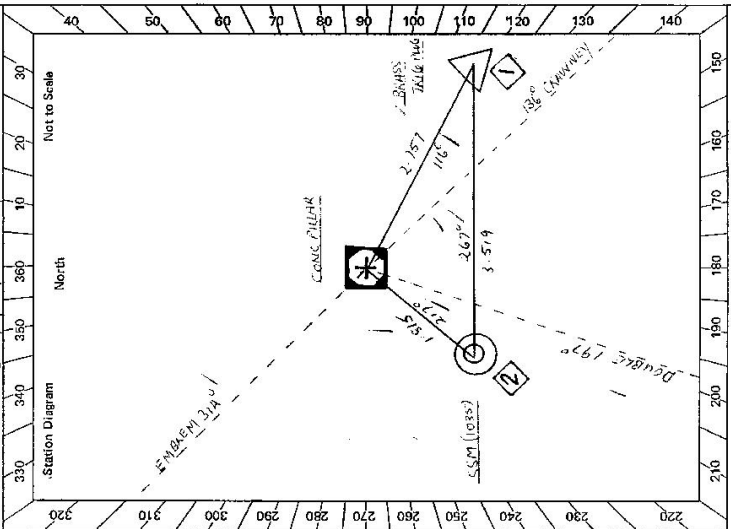

- Description:
- Cleared by lanes bearing 387° / 116° / 116° / 326° / 326° / 326° from Trig. Mast. Note: Cross out word or words which do not apply
 - Mast & Vanes have been painted white & black respectively.
 - The station/pillar was ~~unplaced~~ ~~not unplaced~~ / constructed on 4.79 m, dimensions now being: 19.82 m.
 - Description of mark: ~~SSM~~ ~~TRIG PLUG~~ should be explicit, e.g., S/Steel Pillar Plate, Steel Plug, Brass Plug, Bolt, G.I. Pipe
 - Height of mark 1.365 m. ^{above} ~~below~~ rock/concrete; Mark is 1.445 m. ^{above} ~~below~~ G.L.
 - Height of Top Vanes to Top Mark/Pillar plate 1.436 m. Diameter of Vanes (vertical) $0.75C$ m.
 - Height of Cairn 0 m. Diameter of Cairn 0 m. Name Plate ~~found~~ / ~~not found~~ / placed.
 - Length of Mast 0 m. (approximate if not unplaced)
 - A. ~~BRASS~~ ~~TRIG PLUG~~ set in ~~concrete~~ / rock has been ~~placed~~ / found, bearing 116° M from Mast/Plug/Pillar
 - A. ~~SSM~~ ~~1635~~ set in ~~conc~~ / ~~rock~~ has been ~~placed~~ / found, bearing 217° M from Mast/Plug/Pillar
 - A. 0 set in ~~conc~~ / ~~rock~~ has been ~~placed~~ / found, bearing 0° M from Mast/Plug/Pillar
 - A. 0 set in ~~conc~~ / ~~rock~~ has been ~~placed~~ / found, bearing 0° M from Mast/Plug/Pillar
 - Action required: ~~MARKS~~ ~~PLATE~~ ~~TO~~ ~~BE~~ ~~PLACED~~.

STANDPOINT: CONC PILLAR			STANDPOINT: TRIG PLUG			
Mark	Direction	Horiz. Distance	Height Difference	Direction	Horiz. Distance	Height Difference
CRAWNEY (P)	CC CC		above standpt.	CC CC		above standpt.
DOUBLE (P)	CC CC		above standpt.	CC CC		above standpt.
SSM 1635	EA MA AC	1.815	above standpt.	EA MA AC	3.519	above standpt.
EMBLEM (P)	177 12 AG		above standpt.	CONC PILLAR	1.613	above standpt.
TRIG PLUG	343 A1 AC	2.757	above standpt.	EMBLEM (P)	177 12 AC	above standpt.
			below standpt.			below standpt.
			below standpt.			below standpt.

Prepared by: *[Signature]* Checked: *[Signature]* 21/9/82 - Noted on U.T.M. Card

G

STATION **SNOWDEN** (P) **TS 6927**


Owner's Name: **MR H.G. GOLLAND**
 Address: **5 SWAPS ST OUIRINDI**
 Phone: **46 16 27**

Current Occupant:
 Address:
 Phone:

ACCESS

Access Report of 19.15.1982 was found suitable/unavailable.

- 0.0 WALLABDAH PO HEAD TOWARDS NEW ENGLAND WAY ✓
- 0.11 TURN LEFT TOWARDS TAMWORTH ✓
- 0.89 TURN RIGHT "WALLABDAH CREEK ROAD" ✓
- 6.23 TURN LEFT AND OVER GRID ✓
- 7.31 GRID ✓
- 8.82 GATE ✓
- 9.07 CONC CAUSEWAY ✓
- 9.69 TURN LEFT AT LARGE GUM (SP 84 220-214 ELEC COMM) ✓
- 9.75 FORD ✓
- 10.63 GATE ✓
- 11.19 GATE ✓
- 11.85 THROUGH GATE - TRACK VEERS LEFT UP RIDGE ✓
- 13.73 GATE ✓
- 13.95 GATE ✓
- 14.10 GATE ✓
- 14.68 GATE THEN TURN RIGHT DOWN ONTO OLD TRACK AROUND NORTH SIDE OF HILL ✓
- 15.10 WIRE GATE ✓
- 15.64 SNOWDEN GS ✓

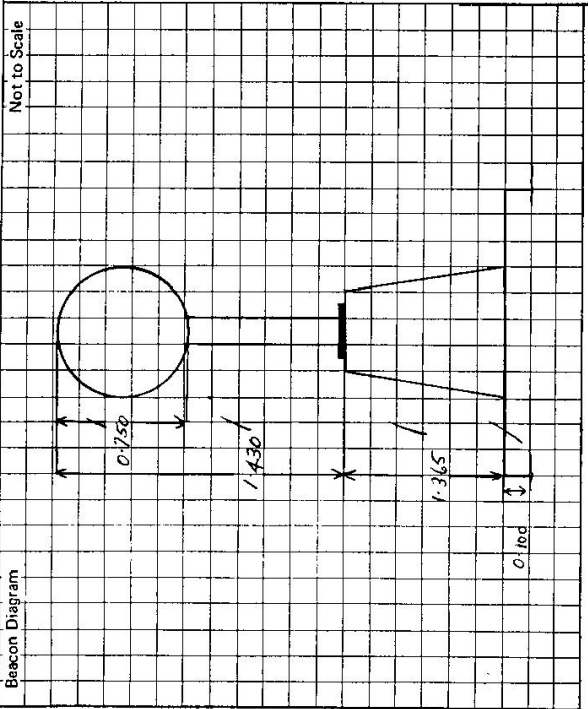

This section to be completed by officer constructing pillar.

Original station mark found/~~not found~~.

Description of mark: **BRASS TRIG. PLUG**

Original beacon found/~~not found~~.

Description of beacon: **CAIRN POLE w/ DISC**

Height Top of Vanes to Top Mark: **3.630** m.

Height of mark: **0.030** m. above G.L. below

Diameter of Vanes: **1.000** m. Height of Cairn: **1.500** m.

Original Beacon has/~~has not~~ been destroyed by me.

Date	Record of Station