

TS 6928
No.: 2288

CENTRAL MAPPING AUTHORITY
GEODETTIC SURVEY OF N.S.W.

GEODETTIC STATION RECONNAISSANCE and MAINTENANCE REPORT

STATION: RYAN'S HILL
MAP SHEET SCALE 1:250 000
INSPECTED BY: J. FANNING
AUTHORITY: C.M.A.
DATE: 22-7-82
FIELD BOOK: C 145

Description:
1. Cleared by lanes bearing.....
2. Mast & Vanes have been painted white & black respectively.
3. The station/pillar was ~~erected~~ ^{constructed} on.....
Description of mark.....
Height of mark.....
Height of Top Vanes to Top Mark/Pillar plate.....
Height of Cairn.....
Length of Mast.....
4. A.....
5. A.....
6. A.....
7. A.....
8. Action required:.....



STANDPOINT:


Mark	Direction	Horiz. Distance	Height Difference	Mark	Direction	Horiz. Distance	Height Difference
			above standpt				above standpt
			below				below
			above standpt				above standpt
			below				below
Prepared by: K. J. H. H. H. H.
Checked:
Noted on U.T.M. Card

STATION: KYANS Hill G.S.P. No.: 12928

MAP SHEET SCALE 1:250 000
INSPECTED BY: P. BOTS DATE: 13.9.82

AUTHORITY: C.M.A. FIELD BOOK: 1668

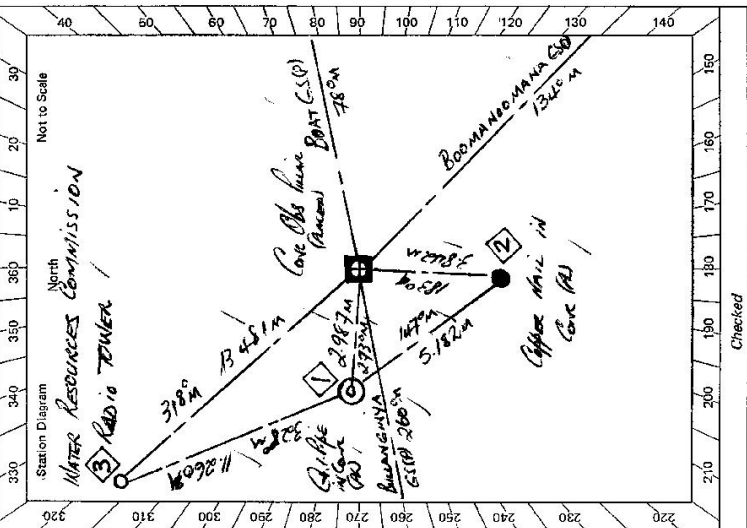

CENTRAL MAPPING AUTHORITY
GEODETTIC SURVEY OF M.S.W.
GEODETTIC STATION RECONNAISSANCE and MAINTENANCE REPORT

- Description: *Note: Circles out word or words which do not apply*
- Cleared by lanes bearing... Bearing 175.2, 217.6, 239.6, 245.6, 252.6, 258.6 from Trig. Mast
 - Mast & Vanes have been painted white & black respectively. ✓
 - The ~~station~~ pillar was ~~replaced~~ replaced / constructed on... 9th September 82, dimensions now being: Sp. Pipe 1.385 m above ~~rock~~ / concrete; Mark is 1.535 m above G.L.
 - Description of mark... Sp. Pipe should be explicit, e.g., S/Steel Pillar Plate, Steel plug, Brass plug, Bolt, G.I. Pipe
 - Height of mark... 1.385 m above ~~rock~~ / concrete; Mark is 1.535 m above G.L.
 - Height of Top Vanes to Top ~~mark~~ / Pillar plate... 1415 m. Diameter of Vanes (vertical) 0.750 m.
 - Height of Cairn... m. Diameter of Cairn... m. Name Plate found/not ~~found~~ / placed.
 - Length of Mast... m. (approximate if not unpled)
 - A... G.I. Pipe set in conc/rock has been placed/~~found~~, bearing 273 °M from ~~mark~~ / Pillar
 - A... Coffee Nail set in conc/rock has been placed/~~found~~, bearing 183 °M from ~~mark~~ / Pillar
 - A... set in conc/rock has been placed/~~found~~, bearing... °M from Mast/Plug/Pillar
 - A... set in conc/rock has been placed/~~found~~, bearing... °M from Mast/Plug/Pillar
 - Action required:.....

STANDPOINT: <u>Cairn Obs. Line</u>			STANDPOINT: <u>G.I. Pipe</u>			
Mark	Direction	Horiz. Distance	Height Difference	Direction	Horiz. Distance	Height Difference
<u>BOONANNO MANA</u>	<u>0 00 00</u>		above standpt.	<u>0 00 00</u>		above standpt.
<u>Coffee Nail</u>	<u>51 27 00</u>	<u>3842</u>	<u>763</u> above standpt.	<u>16 39 00</u>	<u>5182</u>	<u>0 01</u> above standpt.
<u>BULLANGINYA</u>	<u>01 08 10</u>		below	<u>01 31 08 00</u>		below
<u>G.I. Pipe</u>	<u>149 23 40</u>	<u>2986</u>	<u>7549</u> above standpt.	<u>196 14 00</u>	<u>11260</u>	<u>0 20 3</u> above standpt.
<u>Radio Tower</u>	<u>187 01 20</u>	<u>1348</u>	<u>7749</u> above standpt.	<u>304 32 50</u>		<u>1549</u> above standpt.
<u>Bolt G.S.P.</u>	<u>304 32 46</u>		below	<u>329 24 10</u>	<u>2986</u>	<u>1549</u> above standpt.

Prepared by: P. BOTS 16th September 1982
Checked: [Signature] 21/9/82 Noted on U.T.M. Card

6

SI 2733-2 D. West, Government Printer

STATION RYANS HILL (S.S.0) IS 6928

Owner's Name: **Mr. F.A. RYAN**
 Address: **CASHEL**
P.O. Box 4 BERRIGAN
BOYANNA RD 2215
 Phone:


Current Occupant: **MATER RESOURCES**
 Address: **COMMISSION**
FINLAY
 Phone: **83-1244**

ACCESS

Access Report of 31.9.1982 was found suitable/unsuitable.

APPROXIMATE

KM	Access
0.00	POST OFFICE DOCUMENTAL HEAD WEST TOWARDS FINLAY
0.20	TURN RIGHT
0.26	PASS ROAD ON LEFT SIGN MELBOURNE
1.69	TURN RIGHT SIGN "THE RYANS ROAD"
3.32	PASS ROAD ON RIGHT
7.43	TURN RIGHT "THE BOYS ROAD"
12.42	TURN LEFT "FINISHED ROAD"
12.47	TURN RIGHT "MELROSE ROAD"
23.02	TURN LEFT ONTO BERRIGAN ROAD
23.11	CROSS MULWALA CANAL
23.69	TURN RIGHT INTO "CRAIGS ROAD"
29.32	TURN RIGHT "BLACK BARRETT ROAD"
32.67	TURN RIGHT INTO "CASHEL" THROUGH DOUBLE IRON GATES
33.88	KEEPS RIGHT THROUGH GATEWAY OWNER HOUSE TO LEFT MR RYAN
34.29	IRON GATE
34.32	TURN LEFT THROUGH IRON GATE
34.49	RYANS HILL (S.S.0)

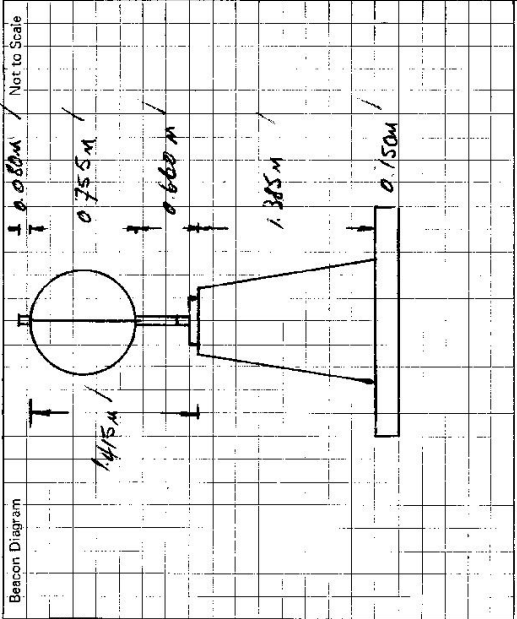

This section to be completed by officer constructing pillar.

Original station mark found/not found.

Description of mark:

Original beacon found/not found.

Description of beacon:

Height Top of Vanes to Top Markm.

Height of markm. above G.L.
 below

Diameter of Vanesm. Height of Cairnm.

Original Beacon has/has not been destroyed by me.

Date	Record of Station

ST 2733-2 C. West, Government Printer

	Not to Scale																						
<div style="border-bottom: 1px solid black; padding-bottom: 5px;"> <p style="font-size: small;">Beacon Diagram</p> <p style="font-size: x-small;">This section to be completed by officer constructing chart.</p> <p>Original station mark found/not found:</p> <p>Description of mark:</p> <p>Original Beacon found/not found:</p> <p>Description of Beacon:</p> <p>Height Top of Vanes to Top Mark: m.</p> <p>Height of mark: m. above rock/cone m. below G.L.</p> <p>Diameter of Vanes: m. Height of Cairn: m.</p> <p>Original Beacon has/has not been destroyed by me.</p> </div>	<p style="text-align: right; font-weight: bold; font-size: large;">TS 6928</p> <p style="text-align: right; border: 1px solid black; padding: 2px;">STATION RYAN'S HILL (P)</p> <p>EA. RYAN <small>"CASHIEL" (Box 4) Back BAROOGA ROAD BERREAN Phone: 03 5876 2215</small></p> <p style="text-align: right; font-size: small;">Current Occupant: Address: Phone: ACCESS 29-7-1997</p> <p style="font-size: x-small;">Access Report of .../.../19... was found suitable/unsuitable.</p> <p>Direction</p> <table style="width: 100%; border-collapse: collapse;"> <tr> <td style="width: 15%;">0.0</td> <td>BAROOGA HOTEL HEAD NORTH TOWARDS BERREAN</td> </tr> <tr> <td>2.0</td> <td>TURN RIGHT TOWARDS MULLWALA / CORROONA</td> </tr> <tr> <td>10.8</td> <td>TURN LEFT INTO "BACK BAROOGA ROAD</td> </tr> <tr> <td>19.1</td> <td>CROSS MULLWALA CANAL</td> </tr> <tr> <td>20.6</td> <td>TURN RIGHT</td> </tr> <tr> <td>20.9</td> <td>TURN LEFT</td> </tr> <tr> <td>24.4</td> <td>TURN LEFT INTO "CASHIEL" (THROUGH GATE)</td> </tr> <tr> <td>25.6</td> <td>TAKE RIGHT FORK (TOWARDS HOUSE ON LEFT)</td> </tr> <tr> <td>26.05</td> <td>THROUGH GATE</td> </tr> <tr> <td>26.1</td> <td>THROUGH GATE ON LEFT. HEAD TO TRIG.</td> </tr> <tr> <td>26.2</td> <td>RYAN'S HILL BILLAR</td> </tr> </table>	0.0	BAROOGA HOTEL HEAD NORTH TOWARDS BERREAN	2.0	TURN RIGHT TOWARDS MULLWALA / CORROONA	10.8	TURN LEFT INTO "BACK BAROOGA ROAD	19.1	CROSS MULLWALA CANAL	20.6	TURN RIGHT	20.9	TURN LEFT	24.4	TURN LEFT INTO "CASHIEL" (THROUGH GATE)	25.6	TAKE RIGHT FORK (TOWARDS HOUSE ON LEFT)	26.05	THROUGH GATE	26.1	THROUGH GATE ON LEFT. HEAD TO TRIG.	26.2	RYAN'S HILL BILLAR
0.0	BAROOGA HOTEL HEAD NORTH TOWARDS BERREAN																						
2.0	TURN RIGHT TOWARDS MULLWALA / CORROONA																						
10.8	TURN LEFT INTO "BACK BAROOGA ROAD																						
19.1	CROSS MULLWALA CANAL																						
20.6	TURN RIGHT																						
20.9	TURN LEFT																						
24.4	TURN LEFT INTO "CASHIEL" (THROUGH GATE)																						
25.6	TAKE RIGHT FORK (TOWARDS HOUSE ON LEFT)																						
26.05	THROUGH GATE																						
26.1	THROUGH GATE ON LEFT. HEAD TO TRIG.																						
26.2	RYAN'S HILL BILLAR																						