

8:

STATION 111105274 Reef top observation Pillar **TS 6932**

Access Location: Agricultural Experiments
Contact: C. C. Conwell, Street, Sydney
Address: Mr. P. W. ...
Phone: ...

Owner's Name: ...
Address: ...
Phone: ...


ACCESS

Access Report of 30/3/19. Was found suitable/unavailable.
FEATURE:
 Mullaley Pear Office via Oxley Highway, travel toward Camabarabran.
 Turn Left onto sealed Road Signposts Coolah 4.5 PREMIER.
 Turn Right onto Gravel Road Signposts, Nonesi Road, Nyuna No.
 Over steel Grid.
 Cross New Road being constructed - Look to Mullaley.
 Over steel Grid.
 Over concrete roadway.
 Over steel Grid.
 Over concrete roadway.
 Over steel Grid.
 Over concrete roadway.
 Take Left Turn. "Mount Nambi" travel past Tennis Courts (Access
 Turn Left into Property. "Mount Nambi" take track to left along sides
 of house on your R.H.S.)
 Forward Hill.
 Through open ferns windpump on your L.H.S.
 Through open ferns above sheep gully follow detour track around
 to your right.
 Small Gully crossing, follow track.
 Gully crossing, follow track that travels around to Southern end
 of hill and then up very steep rocky roughly bulldozed
 grass
 far as possible by vehicle. Seen in under easy walk to station. Dr. ...
 Clear entry. Ninth would possibly be required last Section of vehicle ...

0.00	23.74
0.22	23.86
13.52	25.44
13.76	25.87
13.01	21.19
16.43	
17.92	
18.77	
19.64	
20.40	
21.41	
22.12	
22.47	
22.74	
23.34	

Date 21-19

8: 2733-2 D. West, Government Printer

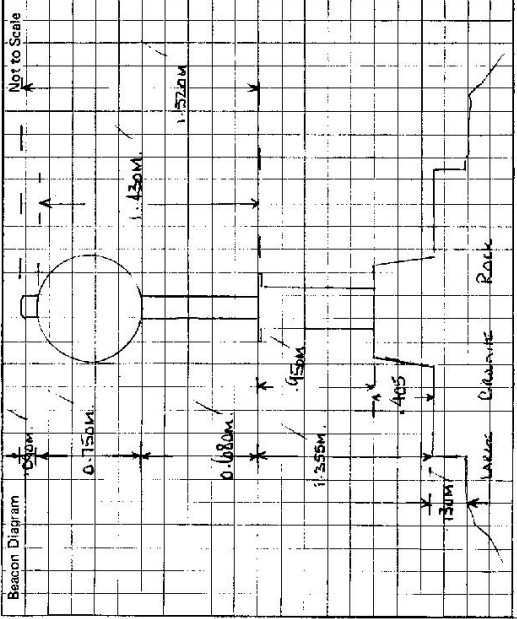

This section to be completed by officer constructing pillar.

Original station mark found/~~not found~~.

Description of mark: ~~Brass~~ pin /

Original beacon found/~~not found~~.

Description of beacon: Pole, Cairns and discs /

Height Top of Vanes to Top Mark: 3.56 / m.

Height of mark: 0.60 m above rock/above m. below G.L. /

Diameter of Vanes: 0.16 m. Height of Cairn: 1.57 m.

Original Beacon has/~~has not~~ been destroyed by me.