


STATION: COOMEALLA No. TS 6937

MAP SHEET SCALE 1:250 000 7329 MILDURA

INSPECTED BY: G.M. HICKS DATE: MARCH 1987

AUTHORITY: D.M.R. FIELD BOOK: 0292, 485, Pg. 1211

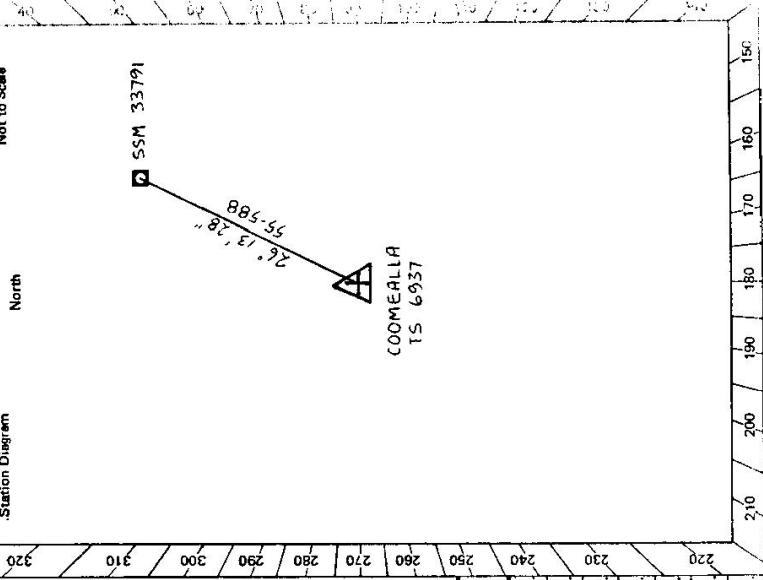

CENTRAL MAPPING AUTHORITY
GEODETTIC SURVEY OF N.S.W.
GEODETTIC STATION RECONNAISSANCE and MAINTENANCE REPORT

Description: *Note: Cross out word or words which do not apply*

1. ~~Steered by laser-bearing~~ ~~from Top of Mast~~
2. ~~Mast & Vane have been painted white & black respectively.~~
3. The station/pillar was ~~erected/not erected~~/constructed on ~~19.5.5...~~ dimensions ~~now being~~.
Description of mark: Triangulation plaque in concrete. ~~Steel plug-Dress plug-Bolt-Clamp Pipe~~
~~Height of mark~~ ~~above/below~~ G.L. Mark is ~~0.1~~ m. ~~above/below~~ G.L.
~~Height of Top Vane to Top Mark/Pillar plate~~ ~~Diameter of Vane (vertical)~~
~~Height of Gains~~ ~~Diameter of Gains~~ ~~Name Plate found/not found/lost~~
~~Length of Mast~~ ~~(approximate if not applied)~~
4. An ~~aluminum~~ ~~plate~~ set in conc/rock has been placed/~~found~~, bearing ~~19~~ ° M from Mast/Plug/Pillar
5. A ~~set in conc/rock~~ has been placed/~~found~~, bearing ~~...~~ ° M from Mast/Plug/Pillar
6. A ~~set in conc/rock~~ has been placed/~~found~~, bearing ~~...~~ ° M from Mast/Plug/Pillar
7. A ~~set in conc/rock~~ has been placed/~~found~~, bearing ~~...~~ ° M from Mast/Plug/Pillar
8. Action required: ~~...~~

STANDPOINT:		COOMEALLA TS 6937		STANDPOINT:			
Mark	Direction	Horiz. Distance	Height Difference	Mark	Direction	Horiz. Distance	Height Difference
SSM 33791	26 13 28	55.588	0.6				
			above standpt.				above standpt.
			below				below
			above standpt.				above standpt.
			below				below
			above standpt.				above standpt.
			below				below
			above standpt.				above standpt.
			below				below

Prepared by:
Checked:
Noted on U.T.M. Card

