

CENTRAL MAPPING AUTHORITY

GEODETIC SURVEY OF N.S.W.

GEODETIC STATION RECONNAISSANCE and MAINTENANCE REPORT

Description: 360° / Note: *Cross out word or words which do not apply*
 Cleared by lances bearing..... from Trig. Mast

2. Mast & Vanes have been painted white & black respectively.
 3. The ~~station~~ pillar ~~was replaced/emptied~~/constructed on 10th November 98, dimensions now being:

Description of mark: Steel Pillar Plate, S/Steel Pillar Plate, Steel plug, Brass plug, Bolt, G.I. Pipe
 Height of mark..... 1.385 m. above ~~rock~~/concrete; Mark is 1.565 m. above G.L.

Height of Top Vanes to Top ~~mark~~/Pillar plate 1.416 m. Diameter of Vanes (vertical) 0.750 m.

Height of Cairn..... m. Diameter of Cairn..... m. Name Plate ~~found~~/not found/placed.

Length of Mast..... m. (approximate if not unplied)

4. G.I. Pipe..... set in conc ~~hook~~ has been placed ~~found~~, bearing 30 °M from Mast/~~Plug~~/Pillar

5. Copper Nail..... set in conc ~~hook~~ has been placed ~~found~~, bearing 237 °M from Mast/~~Plug~~/Pillar

6. A..... set in conc/rock has been placed ~~found~~, bearing..... °M from Mast/~~Plug~~/Pillar

7. A..... set in conc/rock has been placed ~~found~~, bearing..... °M from Mast/~~Plug~~/Pillar

8. Action required.....

STANDPOINT: Steel Pillar Plate


Mark	Direction	Horiz. Distance	Height Difference	Mark	Direction	Horiz. Distance	Height Difference
BAAN CS	0 00 00		above standpt.	BAAN CS	0 00 00		above standpt.
Copper Nail	66 02 40	2.748	1.656 above standpt.	SK PILLAR PLATE	39 55 20	3.506	1.511 above standpt.
G.I. PIPE	219 56 35	3.504	1.507 above standpt.	COPPER NAIL	51 22 00	6.092	0.144 below
KAPITAR CS (P)	232 51 15		above standpt.	KAPITAR CS (P)	232 51 05		above standpt.
EULAH CS	242 42 55		above standpt.	EULAH CS	242 42 55		above standpt.
			above standpt.				above standpt.
			below				below

STANDPOINT: G.I. PIPE in Conc.

Mark	Direction	Horiz. Distance	Height Difference
			above standpt.
			above standpt.
			below

Prepared by: [Signature] Checked: [Signature] Noted on U.T.M. Card 20/11/02

Sr 2733-1

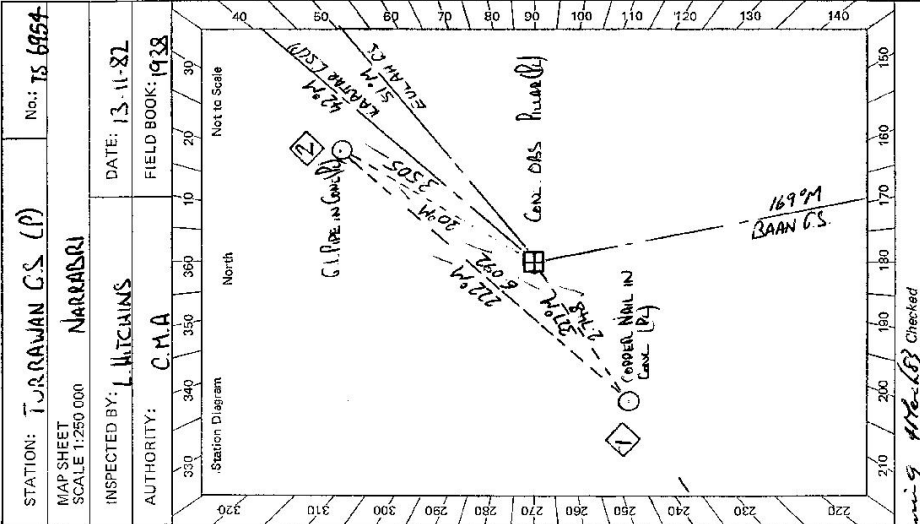

STATION: TURRAWAN CS (P) No: TS 6954

MAP SHEET SCALE 1:250 000 NARRADRRI

INSPECTED BY: L. HITCHINS DATE: 13-11-82

AUTHORITY: C.M.A. FIELD BOOK: 1938

Checked: [Signature]

SF 2753-2 D. West, Government Printer

STATION TURAWAN C.S (P) TS 6954	Owner's Name: A. J. C. McLEOD Address: ROSEVALE TURAWAN WA 6100 Phone: 97 3135	Current Occupant: Address: Phone: ACCESS 13-11-1982	Access Report of 20.6.1982 was found unsuitable unsuitable . MARGARITI O HEAD STH ALONG NEWELL HIGHWAY TOWARDS CAJAMARANAN TURN LEFT TOWARDS GANNEDAH TURN RIGHT TO CROSS RLY. AT TURAWAN SIGNING. CROSS RAILWAY LINES. TURN LEFT AT T INTERSECTION 3KM TURN RIGHT SIGN ROSEVALE 3KM THROUGH WHITE DOUBLE IRON GATES PASS HILL CREST ON RIGHT STRAIGHT AHEAD THROUGH DOUBLE IRON GATES SIGN "ROSE VALE" THROUGH WHITE DOUBLE IRON GATES TAKE TRACK TO RIGHT PASS SHED ON LEFT THROUGH WIDE GATE + FOLLOW FAINT TRACK WEST ACROSS BRIDGE VEERING SLIGHTLY RIGHT BEARING 185°M TURN RIGHT ONTO RUSHED TRACK AND HEAD TOWARDS HILL VEER RIGHT UP STEEP MARCH TO TRC. TURAWAN C.S (P)
Beacon Diagram 		Date Record of Station	
This section to be completed by officer constructing pillar. Original station mark found /not found.		Description of mark: Original beacon found /not found.	
Description of beacon: Height Top of Vanes to Top Markm. Height of markm. above G.L. below Diameter of Vanesm. Height of Cairnm. Original Beacon has /has not been destroyed by me.		Date Record of Station	