

CENTRAL MAPPING AUTHORITY
Department of Lands

Trigonometrical Survey of N.S.W.

RECONNAISSANCE and MAINTENANCE REPORT

STATION **CARABOBALA TS 7011**

This Trig. Station has been:-

Note: Cross out word or words which do not apply

1. Completely cleared to permit 360° vision to surrounding Trigs.

2. Cleared by lines bearing..... from Trig. Mast

3. Trig. Mast & Vanes have been painted white & black respectively.

4. The Trig. was unpiled/not unpiled, dimensions now being: Original Station Mark found (not found)

Description of mark..... should be explicit, e.g. Steel plug, Brass plug, Bolt, G.I. Pipe

Height of mark..... m above below rock/concrete..... m above below G.L.

Height of Top Vanes to Top Mark..... m. Diameter of Vanes (vertical)..... m.

Height of Cairn..... m. Diameter of Cairn..... m.

Length of Mast..... m (approximate if not unpiled)

5. A..... set in conc/rock has been placed..... m. bearing..... °M from Trig. Mast

6. A..... set in conc/soil has been placed..... m. bearing..... °M from Trig. Mast

7. A..... set in conc/soil has been placed..... m. bearing..... °M from Trig. Mast

8. A..... set in conc/rock has been placed..... m. bearing..... °M from Trig. Mast

9. Connection..... to..... m. bearing..... °M

10. Connection..... to..... m. bearing..... °M

11. Connection..... to..... m. bearing..... °M


12. Connection..... to..... m. bearing..... °M

13. Diff. Ht. is..... m. above below

14. Diff. Ht. is..... m. above below

15. Diff. Ht. is..... m. above below

16. Diff. Ht. is..... m. above below

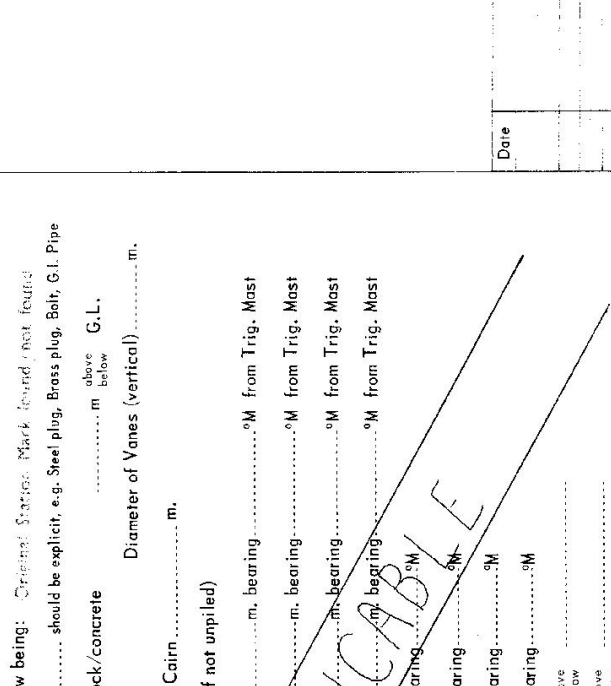

Co: **HUME** Ph: **THUGGA**

Map Sheet: **HOLBROOK** No: **8326 - N**

Inspected by: **G. C. Hanna** Date: **10/8/76**

Authority: **C. M. A.** Field Book: **-**

Beacon Diagram Not to Scale

Date..... Record of Station.....

Prepared by:..... Checked:..... Noted on U.T.M. Card

Checked


STATION CARABOBALA TS-7011

Current Occupant:
 Address:
 Owners Name:
 Address:

Access 10-8-1976

Note :- Station mark not found
 Diagram not to scale


No clearing required Almost 360° vision except for small hill
 600 metres N.W. of trig position.

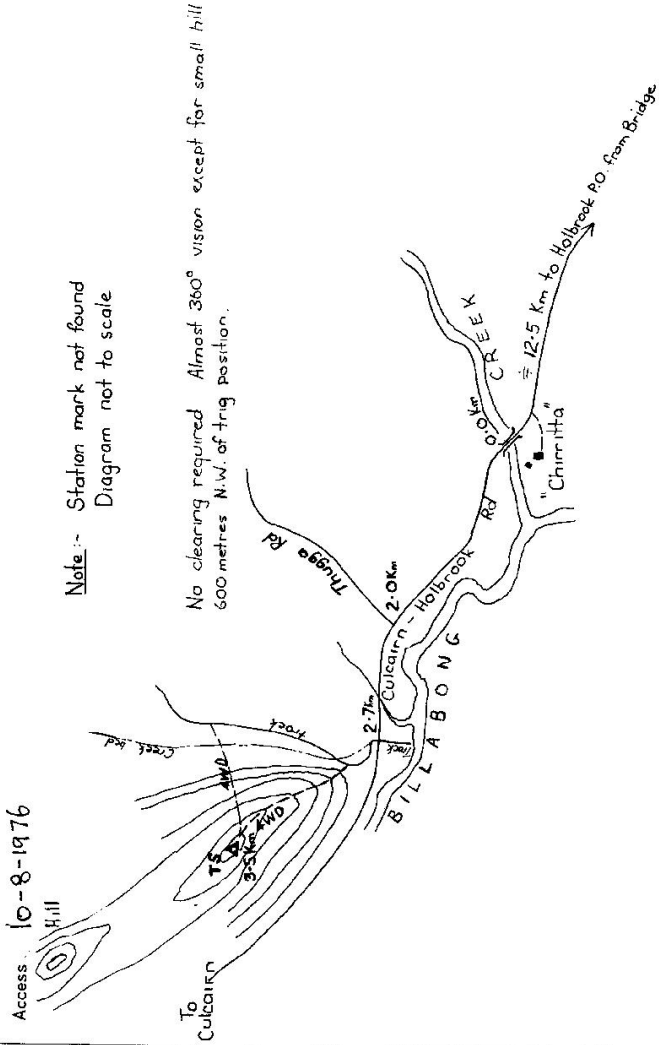

Not to Scale

Station Diagram

North

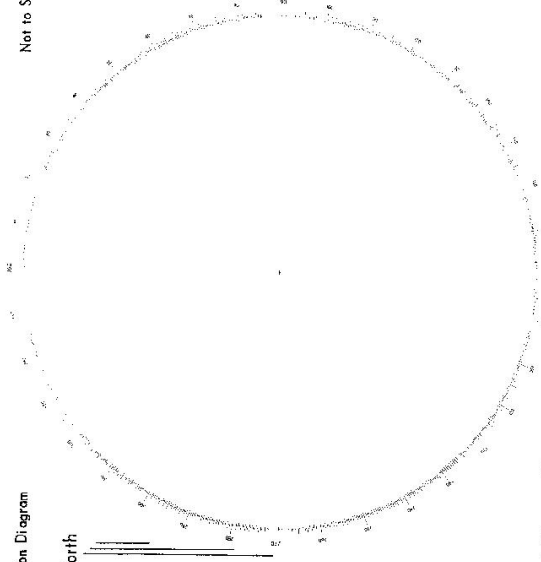

List of Observed Directions:-

Standpoint:		
Station	Direction	Station
Standpoint:		
Station	Direction	Station

CENTRAL MAPPING AUTHORITY
Department of Lands

Trigonometrical Survey of N.S.W.

RECONNAISSANCE and MAINTENANCE REPORT

This Trig. Station has been:-


Note: Cross out word or words which do not apply

- 1. Completely cleared to permit 360° vision to surrounding Trigs.
- 2. Cleared by lanes bearing..... from Trig. Mast
- 3. Trig. Mast & Vanes have been painted white & black respectively.
- 4. The Trig. was unpiled/not unpiled, dimensions now being: Original Station ~~Not Found~~, not found

Description of mark..... should be explicit, e.g. Steel plug, Brass plug, Bolt, G.I. Pipe

Height of mark..... m ^{above} rock/concrete m ^{below} G.L.
 Height of Top Vanes to Top Mark..... m. Diameter of Vanes (vertical)..... m.
 Height of Cairn..... m. Diameter of Cairn..... m.

- Length of Mast..... m. (approximate if not unpiled)
- 5. A..... set in conc/rock has been placed..... m ^{bearing} ~~°M~~ from Trig. Mast
 - 6. A..... set in conc/soil has been placed..... m ^{bearing} ~~°M~~ from Trig. Mast
 - 7. A..... set in conc/soil has been placed..... m ^{bearing} ~~°M~~ from Trig. Mast
 - 8. A..... set in conc/rock has been placed..... m ^{bearing} ~~°M~~ from Trig. Mast

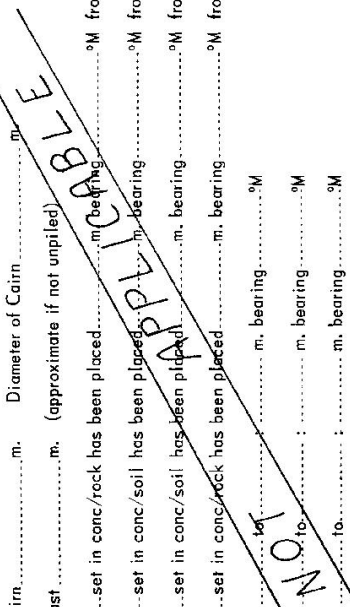

- 9. Connection..... to..... m. bearing..... ~~°M~~
- 10. Connection..... to..... m. bearing..... ~~°M~~
- 11. Connection..... to..... m. bearing..... ~~°M~~
- 12. Connection..... to..... m. bearing..... ~~°M~~

- 13. Diff. Ht. is..... m. ^{above} below
- 14. Diff. Ht. is..... m. ^{above} below
- 15. Diff. Ht. is..... m. ^{above} below
- 16. Diff. Ht. is..... m. ^{above} below

Prepared by:

Checked:

Noted on U.T.M. Card

7-4-88

STATION	CARABOBALA	TS-7011
Co:	Hume	Ph: Thugga
Map Sheet:	Holbrook	No: 8324-N
Inspected by:	G. Hanna	Date: 11/10/76
Authority	Field Book:	
Beacon Diagram	Not to Scale	

Date	Record of Station

Checked

GEODETTIC STATION RECONNAISSANCE and MAINTENANCE REPORT

STATION: **CARBOBALA** No.: **7011**

MAP SHEET SCALE 1:100 000 **WAGGA WAGGA** **HOLBROOK**

SCALE 1:250 000 **WAGGA WAGGA**

INSPECTED BY: **J. Sutton** DATE: **19-11-88**

AUTHORITY: **CMA** FIELD BOOK: **---**

Not to Scale

Station Diagram

MAG North

PEDDLES 348°M

207°M

219°M

232°M

269°M

298°M

2.5 102°M

Rock Cairn 0.8m high

174°M

158°M

Description:

- 1. Cleared by lanes bearing... **207°M - 158°M**, **174°M**, **758°M**, **269°M**, **282°M**, from Trig. Mast **791°M - 298°M**
- 2. Mast & Vanes have been painted white & black respectively.

3. The station ~~was~~ **was** ~~was~~ not unplied/~~concrete~~ on **19th Nov 1988**, dimensions now being:

Description of mark **R.A.S. Plug** should be explicit, e.g., S/Steel Pillar Plate, Steel plug, Brass plug, Bolt, G.I. Pipe

Height of mark.....m. above rock/concrete; Mark is.....m. above G.L.

Height of Top Vanes to Top Mark/Pillar plate.....m. Diameter of Vanes (vertical).....m.

Height of Cairn.....m. Diameter of Cairn.....m. Name Plate found/not found/placed.

Length of Mast.....m. (approximate if not unplied)

- 4. A. **R.A.S. Plug** set in conc/~~mark~~ has been ~~placed~~ found, bearing **1152°** ^{stone pad} from Mast/~~plug/pillar~~
- 5. A. **Rock Cairn** set in conc/~~rock~~ has been placed ~~found~~ bearing **107°** from Mast/~~plug/pillar~~, **75m** distant

6. A.....set in conc/rock has been placed/ found, bearing.....°M from Mast/Plug/Pillar

7. A.....set in conc/rock has been placed/ found, bearing.....°M from Mast/Plug/Pillar

8. Action required: **Nil**

STANDPOINT:

Mark	Direction	Horiz. Distance	Height Difference	Mark	Direction	Horiz. Distance	Height Difference
			above standpt.				above standpt.
			below standpt.				below standpt.
			above standpt.				above standpt.
			below standpt.				below standpt.
Prepared by: **J. Sutton** 3.2.89

Checked: **J. Sutton** Noted on U.T.M. Card

