


IS 7027  
 STATION: **RUSCALA G.S.**  
 MAP SHEET  
 SCALE 1:250 000  
 INSPECTED BY: **L. NITCUMINS**  
 AUTHORITY: **C.M.A.**  
 No.: **3980**  
 DATE: **16.3.82**  
 FIELD BOOK: **01935**

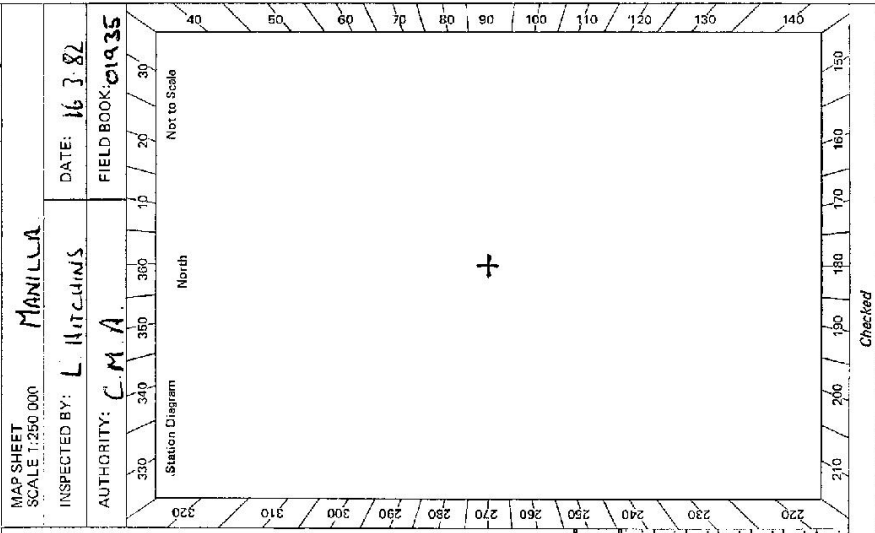

CENTRAL MAPPING AUTHORITY  
 GEODETIC SURVEY OF N.S.W.  
 GEODETIC STATION RECONNAISSANCE and MAINTENANCE REPORT

Description:  
 Cleared by lanes bearing **360°** with **SPARS SCATTERED PLATES** from Trig. Mast  
 Mast & Vanes have been painted white & black respectively.  
 The station ~~marker~~ was ~~unplaced~~ not unplaced/~~constructed~~ on **16-3-1982**, dimensions now being:  
 Description of mark..... should be explicit, e.g., S/Steel Pillar Plate, Steel plug, Brass plug, Bolt, G.I. Pipe  
 Height of mark.....m. above rock/concrete; Mark is.....m. above G.L.  
 Height of Top Vanes to Top Mark/Pillar plate.....m. Diameter of Vanes (vertical).....m.  
 Height of Cairn.....m. Diameter of Cairn.....m. Name Plate found/not found/placed.  
 Length of Mast.....m. (approximate if not unplaced)  
 A..... set in conc/rock has been placed/found, bearing.....° M  
 A..... **S.S.M.** set in conc/rock has been placed/found, bearing...**273**° M from Mast/~~the~~ Pillar  
 A..... set in conc/rock has been placed/found, bearing.....° M from Mast/Plug/Pillar  
 A..... set in conc/rock has been placed/found, bearing.....° M from Mast/Plug/Pillar  
 Action required: **CONC. PILLAR. 1 HOUR. CAPERAINS,**.....

STANDPOINT:				STANDPOINT:			
Mark	Direction	Horiz. Distance	Height Difference	Mark	Direction	Horiz. Distance	Height Difference
			above standpt. below				above standpt. below
			above standpt. below				above standpt. below
Prepared by: **J.C. Hill**  
 Checked: **J.C. Hill**  
 Noted on U.T.M. Card

St. 2733-2 D. West, Government Printer Beacon Diagram Not to Scale	STATION <b>RUSCALA C.S TS 7027</b> Owner's Name: <b>MARGOACK ENTERPRISES</b> Address: <b>MIR. HT. HARRIS</b> <b>WONGCALA, VIA BARBARA</b> Phone: <b>93311566 (067)</b> ACCESS Access Report of 16/2/1987 was found suitable/unsuitable. 0-00 BARBARA PO HEAD SOUTH. 0-14 TURN RIGHT SIGN 'REVALLYN ROAD' 20-50 TURN LEFT SIGN 'MT LINDSAY, HORTON FALLS' 24-89 27.03 29.63 CROSS GRIDS 31-20 PASS ROAD ON RIGHT SIGN 'LONNYEN, HORTON FALLS' 37-57 CROSS GRID 40-75 CROSS GRID 41-10 PASS ROAD ON RIGHT SIGN 'LOTSWOLD' 43-84 PASS ROAD ON LEFT SIGN 'WIRRAWEE, VIOLET DALE' 45-16 GRID SIGN 'WONGCALA' 46-72 TURN RIGHT AND DRIVE UP TO SADDLE 47-16 MT SADDLE TURN RIGHT AND MAKE OWN WAY TO TRIC. OWNERS PROPERTY AND HOUSE FURTHER DOWN ROAD ON RIGHT 'WONGCALA'	Owner's Name: <b>MR. M. HARRIS</b> Address: <b>BARBARA</b> Phone: <b>93311566</b> STATION <b>RUSCALA C.S TS 7027</b> Owner's Name: <b>MR. S.S. M. KIRO</b> Address: <b>BARBARA</b> Phone: <b>93311566</b>
This section to be completed by officer constructing pillar. Original station mark found/not found.		Date <b>4/10</b> Record of Station
Description of mark: ..... Original beacon found/not found. Description of beacon: ..... Height Top of Varies to Top Mark .....m. Height of mark .....m. above G.L. below Diameter of Varies .....m. Height of Cairn .....m. Original Beacon has/has not been destroyed by me.		

CENTRAL MAPPING AUTHORITY

GEODETIC SURVEY OF N.S.W.

GEODETIC STATION RECONNAISSANCE and MAINTENANCE REPORT


- Description:
- Cleared by lanes bearing  $360^\circ$  / Note: Cross out word or words which do not apply from Trig. Mast
  - Mast & Vanes have been painted white & black respectively, ✓
  - The ~~station~~ pillar was ~~reconstructed~~ constructed on 11th FEB, 1983, dimensions now being: Description of mark Pillar Plate should be explicit, e.g., S/Steel Pillar Plate, Steel plug, Brass plug, Bolt, G.I. Pipe Height of mark 2.365 m. above ~~rock~~ concrete; Mark is 5.05 m. above G.L.
  - Height of Top Vanes to Top ~~Mast~~ Pillar plate 4.42 m. Diameter of Vanes (vertical) 75.5 m.
  - Height of Cairn 0 m. Diameter of Cairn 0 m. Name Plate ~~found~~ found placed.
  - Length of Mast 0 m. (~~approximately~~)
  - SPANNING STEEL PLATE set in conc/rock has been ~~placed~~ found, bearing 193 M from ~~Mast~~ Pillar
  - S.S.M. set in conc/rock has been ~~placed~~ found, bearing 225 M from ~~Mast~~ Pillar
  - A set in conc/rock has been placed/round, bearing 0 M from Mast/Plug/Pillar
  - A set in conc/rock has been placed/round, bearing 0 M from Mast/Plug/Pillar

Action required: Pillar Plate STANDPOINT: Spanness Size Tall Pl.

Mark	Direction	Horiz. Distance	Height Difference	Mark	Direction	Horiz. Distance	Height Difference
KARUTTA (P)	0 00 00		above standpt.	KARUTTA (P)	0 00 00		above standpt.
TALUEZA (P)	147 14 15	3 8 54	below standpt.	Pillar Plate	68 10 35	3 8 58	above standpt.
SPANNING STEEL PL.	248 11 35	3 8 54	below standpt.	TALUEZA (P)	147 12 25		above standpt.
S.S.M.	277 49 00	5 0 66	below standpt.	S.S.M.	325 51 25	2 5 63	above standpt.
KARUTTA Tower (P)	355 44 25		above standpt.	KARUTTA Tower (P)	355 15 00		above standpt.
			below standpt.				below standpt.
			below standpt.				below standpt.

Prepared by: SP/10/15 Checked: SP/10/15

Sr 2733-1

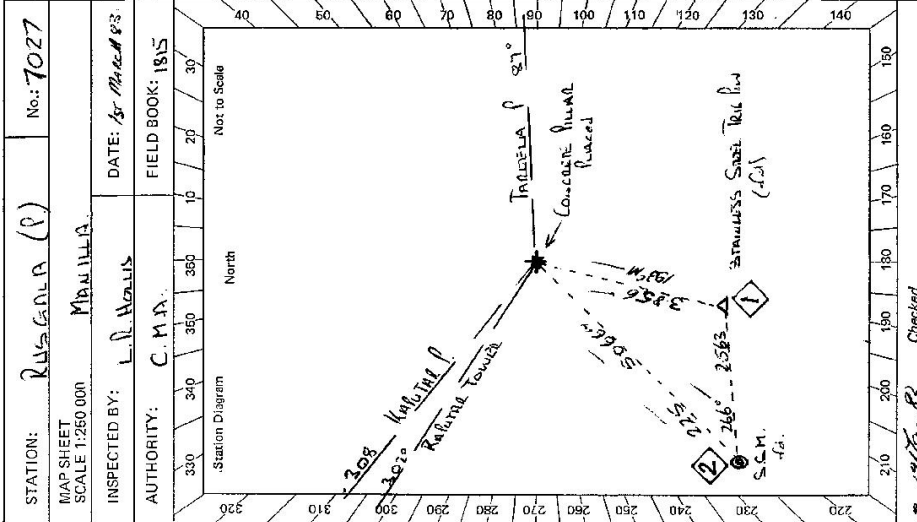

Checked: SP/10/15 Noted on U.T.M. Card

CS

STATION <b>RUS LINA (P) TS 7027</b>	Owner's Name: <b>Mr. Tim Harris</b> Address: <b>1400272K GARDENIA ST</b> Phone: <b>087 331 456</b>	Current Occupant: Address: Phone:	ACCESS Access Report of 1/3/1983 was found suitable/unsuitable. Features 11-00 BARRABA RD HERRON CRY. 0-14 TULLY RD SWD "TEWALU RD" 20-50 TULLY LEFT SWD "M LINDSAY HORSE FIELDS" 27-03, 27-95, 29-63, GAID'S "HORSE FIELDS" PASS ROAD ON RIGHT "OCEAN MEN" 40-75, GAID'S "GATEWOOD" PASS RD ON R.H.S "WARRIEWEE" 45-50 ROAD L.S. SWD "VIOLET DALE" ROAD SWD "WONGARA" TULLY RIGHT & DRIVE UP INTO SADDLE THENCE TULLY RIGHT TO TULLY ROAD "DASMANA ES" Note: OWNER MR TIM HARRIS LIVES FURTHER DOWN RD AT BOTTOM OF HILL
Beacon Diagram Not to Scale 	This section to be completed by officer constructing pillar. Original station mark found/ <del>was</del> Description of mark: <b>STATION MARKS SET BY TULLY P.W.</b> Original beacon found/ <del>was</del> Description of beacon: <b>Central Pill &amp; Poles</b> Height Top of Vanes to Top Mark: <b>3.03</b> m. Height of mark: <b>0.32</b> m. above <del>mark</del> / <b>conc.</b> <b>41.1</b> m. below Diameter of Vanes: <b>1.01</b> m. Height of Cairn: <b>41.1</b> m. Original Beacon has <del>been</del> been destroyed by me.		
			Date Record of Station