

CENTRAL MAPPING AUTHORITY

GEODETIC SURVEY OF N.S.W.

## GEODETIC STATION RECONNAISSANCE and MAINTENANCE REPORT

## Description:

1. Cleared by lanes bearing..... Not ..... Crossed ..... Note: Cross out word or words which do not apply

2. Mast &amp; Vanes have been painted white &amp; black respectively. .... from Trig. Mast

3. The station/pillar was unpiled/not unpiled/constructed on..... 19....., dimensions now being:

Description of mark..... should be explicit, e.g., S/Steel Pillar Plate, Steel plug, Brass plug, Bolt, G.I. Pipe

Height of mark.....m. above below rock/concrete; Mark is.....m. above below G.L.

Height of Top Vanes to Top Mark/Pillar plate .....m. Diameter of Vanes (vertical).....m.

Height of Cairn.....m. Diameter of Cairn.....m. Name Plate found/not found/placed.

Length of Mast .....m. (approximate if not unpiled)

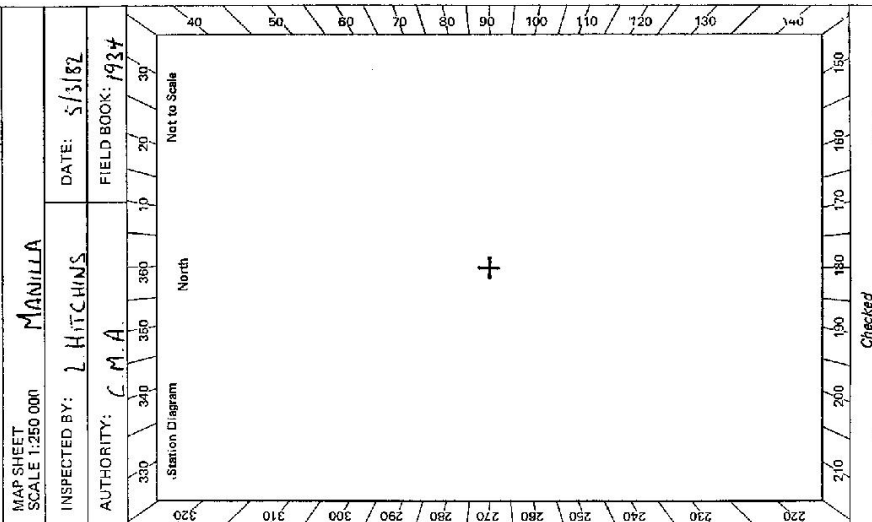
4. A..... S.S.M. ..... set in conc/rock has been placed/found, bearing..... 316.....°M from Mast/Plug/Pillar5. A..... set in conc/rock has been placed/found, bearing.....°M from Mast/Plug/Pillar6. A..... set in conc/rock has been placed/found, bearing.....°M from Mast/Plug/Pillar7. A..... set in conc/rock has been placed/found, bearing.....°M from Mast/Plug/Pillar8. Action required: WALK TO CONC. PILLAR IF POSS. REPAIRS. CLEANING 2 TO 3 DAYS + POISONING  
SHOW OWNERS DANGER EXTENT OF CLEANING. RESUME COMMENCING  
STANDPOINT:

Mark	Direction	Horiz. Distance	Height Difference	Mark	Direction	Horiz. Distance	Height Difference
			above standpt.				above standpt.
			below standpt.				below standpt.
			above standpt.				above standpt.
			below standpt.				below standpt.
Prepared by: SL HillChecked: SL Hill Noted on U.T.M. Card

SI 2733-1

Checked

STATION: MYOLA G.S.  
MAP SHEET  
SCALE 1:250 000  
INSPECTED BY: L. HITCHINS  
AUTHORITY: C.M.A.  
DATE: 5/3/82  
FIELD BOOK: 1934  
No.: 3301

Ss.2733-2 D. West Government Printer

STATION MYOLA GS. TS 7037	
<p>Owner's Name: <u>MR. R.R. FARRAR</u></p> <p>Address: <u>P.O. Box 123 G.P.O. SWDNEY</u></p> <p>Phone: <u>PA 820118</u></p> <p>Current Occupant: <u>MR. FARRAR'S DAUGHTER</u></p> <p>Address: <u>"APPLE OAK" VIA BARRABA</u></p> <p>Phone: <u>PA 820118</u></p> <p>ACCESS <u>5-3-1982</u></p> <p>Access Report of <u>4/4/1982</u> was found suitable/unavailable.</p> <p><u>O.D. BARRABA P.O. HEAD SOUTH</u></p> <p><u>0 25 TURN RIGHT TREVALLYN 4.8 VIA HORTON GAP</u></p> <p><u>6.16 TURN LEFT SIGN "BARRINDI 14 BANGON 20"</u></p> <p><u>24 21 CROSS CONC BRIDGE</u></p> <p><u>25.57 TURN RIGHT SIGN "SPON KOP"</u></p> <p><u>27 02 IRON GATE</u></p> <p><u>28.46 PASS "SPON KOP" HOMESTEAD ON LEFT</u></p> <p><u>29.15 IRON GATE</u></p> <p><u>30.97 GATE SIGN "SPON KOP"</u></p> <p><u>31 09 TURN RIGHT SIGN "APPLE OAK"</u></p> <p><u>31 73 GATE</u></p> <p><u>32 01 THROUGH IRON GATE ON RIGHT KEEP FENCE + OWNERS HOUSE</u></p> <p><u>ON LEFT CALL IN AND SEE OWNER.</u></p> <p><u>32.14 THROUGH IRON GATE + TURN RIGHT KEEP FENCE ON RIGHT</u></p> <p><u>32.48 IRON GATE KEEP FENCE TO RIGHT</u></p> <p><u>32.93 IRON GATE FOLLOW TRACK BACK TO RIGHT</u></p> <p><u>33.03 TURN LEFT OFF TRACK AND MAKE OWN WAY UP STEEP ROCKY RIDGE</u></p> <p><u>33 11 TOP OF ROCKY CLIMB (MAY NEED WINCH WITH LOAD) THEN TURN</u></p> <p><u>LEFT AND FOLLOW FLAT AREA TO BASE OF TRIG</u></p> <p><u>33 49 STOP TRUCK MYOLA GS 5 MIN WALK WITH LOAD ON RIGHT</u></p> <p><u>4WD</u></p>	<p>Beacon Diagram</p> <p>Not to Scale</p> <p>This section to be completed by officer constructing pillar.</p> <p>Original station mark found/not found.</p> <p>Description of mark: .....</p> <p>Original beacon found/not found.</p> <p>Description of beacon: .....</p> <p>Height Top of Varies to Top Mark .....m.</p> <p>Height of mark: .....m. above G.L. below</p> <p>Diameter of Varies .....m. Height of Cairn .....m.</p> <p>Original Beacon has/has not been destroyed by me.</p>

Record of Station

Date

## CENTRAL MAPPING AUTHORITY

## GEODETTIC STATION RECONNAISSANCE and MAINTENANCE REPORT

## Description:

1. Cleared by lanes bearing  $042.115^\circ$ ,  $222.20^\circ$ ,  $293.46^\circ$ ,  $322.2^\circ$  from Trig. Mast

2. Mast & Vanes have been painted white & black respectively.

3. The station/pillar was ~~unpublished~~ constructed on  $18.3$  dimensions now being:

Description of mark  $2.7$  ~~above~~ ~~below~~ ~~concrete~~ should be explicit, e.g. S/Steel Pillar Plate, Steel plug, Brass plug, Bolt, G.I. Pipe

Height of mark  $1.370$  m. ~~above~~ ~~below~~ ~~concrete~~ Mark is  $2.026$  m. ~~above~~ ~~below~~ G.L.

Height of Top Vanes to Top Mast/Pillar plate  $1.390$  m. Diameter of Vanes (vertical)  $7.50$  m.

Height of Cairn ~~.....~~ m. Diameter of Cairn ~~.....~~ m. Name Plate ~~found~~ ~~placed~~ ~~found~~ placed.

Length of Mast ~~.....~~ m. ~~(specify material if not supplied)~~

4. A. ~~S/S~~ ~~Steel~~ ~~Pillar~~ set in conc/rock has been ~~placed~~ ~~found~~, bearing  $222.2^\circ$  M from Mast/~~Brass~~/~~Pillar~~

5. A. ~~S. S. M.~~ set in conc/rock has been ~~placed~~ ~~found~~, bearing  $245.5^\circ$  M from Mast/~~Brass~~/~~Pillar~~

6. A. ~~.....~~ set in conc/rock has been placed/ found, bearing ~~.....~~ M from Mast/~~Brass~~/~~Pillar~~

7. A. ~~.....~~ set in conc/rock has been placed/ found, bearing ~~.....~~ M from Mast/~~Brass~~/~~Pillar~~

8. Action required: ~~.....~~

STANDPOINT: ~~Pillar 12472~~ STANDPOINT: ~~SHAWLESS STEEL TAIL PL.~~

Mark	Direction	Horiz. Distance	Height Difference	Mark	Direction	Horiz. Distance	Height Difference
B4420 (P)	0 00 00	1	above standpt	B4420 (P)	0 00 00	1	above standpt
L46000 (P)	71 30 25	1	above standpt	S.S.M. 1124	62 09 55	2325	0.310
T44222 (P)	44 11 30	1	above standpt	L46000 (P)	71 31 20	1	above standpt
S/S222 Tail Pl.	335 23 00	5.874	1.855	T44222 (P)	44 11 40	1	above standpt
S.S.M. 1124	856 32 20	6.438	2.168	Pillar Plate	155 21 20	5875	1.855
			above standpt				below standpt
			below				below

Prepared by:

Checked:

Noted on U.T.M. Card

Checked

STATION: M401A(?) No.: 7037

MAP SHEET

SCALE 1:250 000

INSPECTED BY: M. D. HALLS

DATE: 22-3-1983

FIELD BOOK: 01550

AUTHORITY: L. D. HALLS

Station Diagram

North

Not to Scale

322°

249° B4420 P

250° 6' 24" 38' 41"

250° 32' 20"

250° 32' 20"

[illegible]