

CENTRAL MAPPING AUTHORITY

GEODETIC SURVEY OF N.S.W.  
 GEODETIC STATION RECONNAISSANCE and MAINTENANCE REPORT

Description:

1. Cleared by lanes bearing. *Note: Cross out word or words which do not apply*

2. Mast & Vanes have been painted white & black respectively.

3. The station/pillar was unpiled/not unpiled/constructed on.....19....., dimensions now being:

Description of mark.....should be explicit, e.g., S/Steel Pillar Plate, Steel plug, Brass plug, Bolt, G.I. Pipe

Height of mark.....m. <sup>above</sup>/<sub>below</sub> rock/concrete; Mark is.....m. <sup>above</sup>/<sub>below</sub> G.L.

Height of Top Vanes to Top Mark/Pillar plate .....m. Diameter of Vanes (vertical).....m.

Height of Cairn.....m. Diameter of Cairn.....m. Name Plate found/not found/placed.

Length of Mast.....m. (approximate if not unpiled)

4. A.....set in conc/rock has been placed/found, bearing.....°M from Mast/Plug/Pillar

5. A.....set in conc/rock has been placed/found, bearing.....°M from Mast/Plug/Pillar

6. A.....set in conc/rock has been placed/found, bearing.....°M from Mast/Plug/Pillar

7. A.....set in conc/rock has been placed/found, bearing.....°M from Mast/Plug/Pillar

8. Action required:.....

STANDPOINT:

STANDPOINT:

Mark	Direction	Horiz. Distance	Height Difference	Mark	Direction	Horiz. Distance	Height Difference
			above standpt.				above standpt.
			below standpt.				below standpt.
			above standpt.				above standpt.
			below standpt.				below standpt.
Prepared by: *G. Hanna*

4/12/78

Checked: *G. Hanna*

Noted on U.T.M. Card

St 2733-1

STATION: CANA No.: 7043  
 MAP SHEET SCALE 1:250 000 TAMWORTH  
 INSPECTED BY: G.C. HANNA DATE: 25/10/78  
 AUTHORITY: C.M.A. FIELD BOOK:



STATION: CANA GS (P) No.: 7043  
 MAP SHEET SCALE 1:250 000 TAMWORTH  
 INSPECTED BY: L. HITCHINS DATE: 20.4.83  
 AUTHORITY: Z. M. A. FIELD BOOK: 01937

CENTRAL MAPPING AUTHORITY  
 GEODETIC SURVEY OF N.S.W.  
 GEODETIC STATION RECONNAISSANCE and MAINTENANCE REPORT

- Description: *Note: Cross out word or words which do not apply*
1. Cleared by lanes bearing 360° from Trig. Mast
  2. Mast & Vanes have been painted white & black respectively.
  3. The station/pillar was ~~used~~ replaced / constructed on 18th April 1983, dimensions now being: 1.923 above G.L.  
 Description of mark: Steel Pillar Plate, should be explicit, e.g., S/Steel Pillar Plate, Steel plug, Brass plug, Bolt, G.I. Pipe  
 Height of mark: 1.390 m. 1.540 m. above rock/concrete; Mark is 1.540 m. above G.L.  
 Height of Top Vanes to Top Mark/Pillar plate: 1.390 m. Diameter of Vanes (vertical): 0.750 m.  
 Height of Cairn: ..... m. Diameter of Cairn: ..... m. Name Plate ~~found~~ found / placed.  
 Length of Mast: ..... m. (approximate if not unplied)
  4. A. BRASS TRIG PIN set in conc/rock has been ~~placed~~ found, bearing 155° M from Mast/Plug/Pillar
  5. A. S.S.M. No. 157 set in conc/rock has been ~~placed~~ found, bearing 72° M from Mast/Plug/Pillar
  6. A. .... set in conc/rock has been placed/ found, bearing .....° M from Mast/Plug/Pillar
  7. A. .... set in conc/rock has been placed/ found, bearing .....° M from Mast/Plug/Pillar
  8. Action required: .....

STANDPOINT: BRASS TRIG PIN		STANDPOINT: S.S. PILLAR PLATE				
Mark	Direction	Horiz. Distance	Height Difference	Direction	Horiz. Distance	Height Difference
GREENFELL GS (P)	0 00 00			GREENFELL GS (P)	0 00 00	above standpt.
S.S. PILLAR PL	38 46 30	3960	1394	BRASS TRIG PIN	218 47 30	above standpt.
S.S.M. No 157	327 41 30	4179	0.142	S.S.M. No 157	275 25 10	below standpt.
TRECANTLE GS (P)	338 19 35			TRECANTLE GS (P)	338 19 45	above standpt.
						above standpt.
						above standpt.
						above standpt.
						below standpt.
						below standpt.

Prepared by: [Signature] Checked: [Signature] Noted on U.T.M. Card [Signature]

SI 2733 - 2 D. West, Government Printer

STATION **CANA (S.O)** TS **7043**

ACCESS OWNER AND OWNER OF LAND **SUBLEADING TR. ON HILL SIDE**

Address: **MR D SIMMONS HITCHNER PL**

Address: **"MILLERS" BARNSIDE ROAD, CARRIBROOK**

Phone: **687179**

OWNER OF LAND **SUBLEADING TR. ON SH. SIDE**

MR IAN MCINNES "CANA" WENNS CREEK PHONE **687072**

ACCESS

ACCESS Report of 19/1/1981 was found suitable for **Access**

C-00 WENNS CREEK PD HEAD TOWARDS TOWN

D 90 CROSS RAILWAY - TAKE RIGHT FORK TOWARDS TOWN

2 77 TURN LEFT ONTO BARNSIDE ROAD SIGN "SNEEZA"

10 95 PASS ACCESS OWNERS HOUSE ON LEFT

11 59 PASS THROUGH DOUBLE IRON GATES ON LEFT AND THEN TO RIGHT (FENANT HOUSE IS THROUGH OTHER GATE)

11 64 THROUGH GATE AND TURN LEFT

11 72 TURN LEFT AROUND FENCE CORNER

11 78 CROSS GULLY AND FOLLOW PAINT TRACK UP HILL

12 05 PASS THROUGH STEEL GATE AND TURN RIGHT - DRIVE UP HILL WITH FENCE ON RHS

12 10 LEAVE FENCE AND FOLLOW DOZED TRACK TO YOUR LEFT

12 66 FOLLOW TRACK AROUND TO LEFT

12 78 THROUGH GATE FOLLOW TRACK

13 52 THROUGH STEEL GATE FOLLOW TRACK

13 69 TURN LEFT OFF TRACK AND DRIVE TO TRIG.


13 74 CANACK (P)

Owner's Name: **"BIG RESERVE"**

Address: **No 49357**

**PALUSH CREEK, CARRIBROOK**

Phone: **687179**

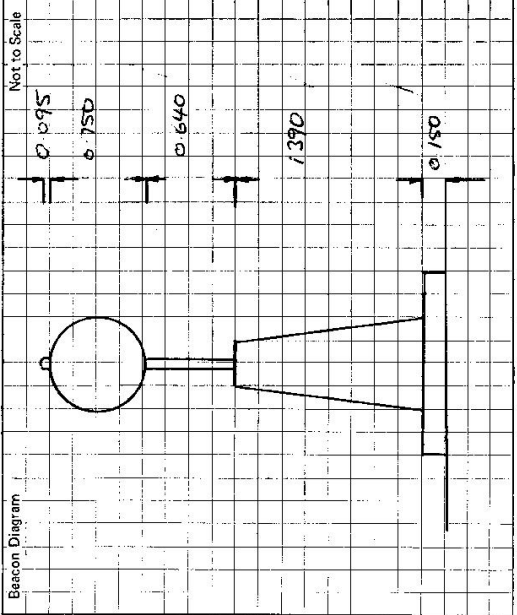

This section to be completed by officer constructing pillar.

Original station mark found/~~last found~~.

Description of mark: **BURNE YOUNG PIN**

Original beacon found/~~last found~~.

Description of beacon: **CAIRN, POLE, DISCS**

Height Top of Vanes to Top Mark: **3.643** m.

Height of mark **0.07** m. above ~~below~~ **0.100** m. above ~~below~~ G.L.

Diameter of Vanes: **0.900** m. Height of Cairn: **1.870** m.

Original Beacon has ~~been~~ been destroyed by me.

Date	Record of Station