

CENTRAL MAPPING AUTHORITY

GEODETIC SURVEY OF M.S.W.

GEODETIC STATION RECONNAISSANCE and MAINTENANCE REPORT

Description:

1. Cleared by lanes bearing **360° with SCATTERED TREES**. *Note: Cross out word or words which do not apply*

2. Mast & Vanes have been painted white & black respectively.

3. The station/pillar was unpiled/not unpiled/constructed on 19....., dimensions now being:

Description of mark.....should be explicit, e.g., S/Steel Pillar Plate, Steel plug, Brass plug, Bolt, G.I. Pipe

Height of mark.....m. ^{above} rock/concrete; Mark is.....m. ^{above} G.L.

Height of Top Vanes to Top Mark/Pillar plate.....m. Diameter of Vanes (vertical).....m.

Height of Cairn.....m. Diameter of Cairn.....m. Name Plate found/not found/placed.

Length of Mast.....m. (approximate if not unpiled)

4. A.....set in conc/rock has been placed/found, bearing.....° M from Mast/Plug/Pillar

5. A.....set in conc/rock has been placed/found, bearing.....° M from Mast/Plug/Pillar

6. A.....set in conc/rock has been placed/found, bearing.....° M from Mast/Plug/Pillar

7. A.....set in conc/rock has been placed/found, bearing.....° M from Mast/Plug/Pillar

8. Action required **2 WAS CLEANING, CONST. CONC. PILLAR**.....

STANDPOINT:

STANDPOINT:

Mark	Direction	Horiz. Distance	Height Difference	Mark	Direction	Horiz. Distance	Height Difference
			above standpt.				above standpt.
			below				below
			above standpt.				above standpt.
			below				below
Prepared by: *[Signature]*

Checked: *[Signature]*

Noted on U.T.M. Card

ST 2733-1

STATION: **BELMORE C.S.** No: **7045** No: **847**

MAP SHEET SCALE 1:250 000 **MANILLA**

INSPECTED BY: **L. HITCHINS** DATE: **22-3-82**

AUTHORITY: **C.M.A.** FIELD BOOK: **D1935**

Station Diagram

Not to Scale

CENTRAL MAPPING AUTHORITY

GEODETTIC SURVEY OF N.S.W.

GEODETTIC STATION RECONNAISSANCE and MAINTENANCE REPORT


Description:

1. Cleared by lanes bearing..... *136*..... *136*..... from Trig. Mast
Note: Cross out word or words which do not apply
2. Mast & Vanes have been painted white & black respectively. ✓
3. The ~~station~~/pillar was ~~constructed~~/constructed on..... *5.74 M.A. 19.8.3.*, dimensions now being:
Description of mark *S.S. Brass Plate* could be explicit, e.g., S/Steel Pillar Plate, Steel plug, Brass plug, Bolt, G.I. Pipe
Height of mark..... *1.36*.....m. ^{above} ~~rock~~/concrete; Mark is..... *1.46*.....m. ^{above} G.L.
Height of Top Vanes to Top ~~mark~~/Pillar plate..... *1.40*.....m. Diameter of Vanes (vertical)..... *7.50*.....m.
Height of Cairn..... *1.00*.....m. Diameter of Cairn..... *1.00*.....m. Name Plate ~~found~~/placed.
Length of Mast..... *1.44*.....m. (~~approximate~~)
4. A..... *Brass. Plug*..... set in conc/rock has been ~~placed~~/found, bearing..... *145*.....°M from ~~mark~~/Pillar
5. A..... *S.S. M.*..... set in conc/rock has been ~~placed~~/found, bearing..... *226*.....°M from ~~mark~~/Pillar
6. A..... set in conc/rock has been placed/found, bearing.....°M from Mast/Plug/Pillar
7. A..... set in conc/rock has been placed/found, bearing.....°M from Mast/Plug/Pillar
8. Action required:..... *1.44*.....

STANDPOINT:	Mark	Direction	Horiz. Distance	Height Difference	Direction	Horiz. Distance	Height Difference
<i>Brass Plate</i>	<i>Newry (P)</i>	<i>0 00 00</i>	<i>0 00 00</i>	<i>above standpt.</i>	<i>Brass Tab. Plug</i>	<i>0 00 00</i>	<i>above standpt.</i>
	<i>S.S. M</i>	<i>27 40 00</i>	<i>4.080</i>	<i>below standpt.</i>		<i>55 19 30</i>	<i>below standpt.</i>
	<i>Hobden (P)</i>	<i>55 19 00</i>	<i>1.495</i>	<i>below standpt.</i>		<i>141 37 40</i>	<i>below standpt.</i>
	<i>Brass Plug</i>	<i>62 42 35</i>	<i>4.075</i>	<i>below standpt.</i>		<i>242 42 30</i>	<i>above standpt.</i>
	<i>Myola (P)</i>	<i>141 35 30</i>	<i>2.454</i>	<i>below standpt.</i>		<i>315 22 20</i>	<i>below standpt.</i>
				<i>above standpt.</i>			<i>above standpt.</i>
				<i>below standpt.</i>			<i>below standpt.</i>

STANDPOINT: *Brass Tab. Plug*
 Prepared by: *L. R. Harris* Checked: *12/8/83* Noted on U.T.M. Card

ST 2733-1

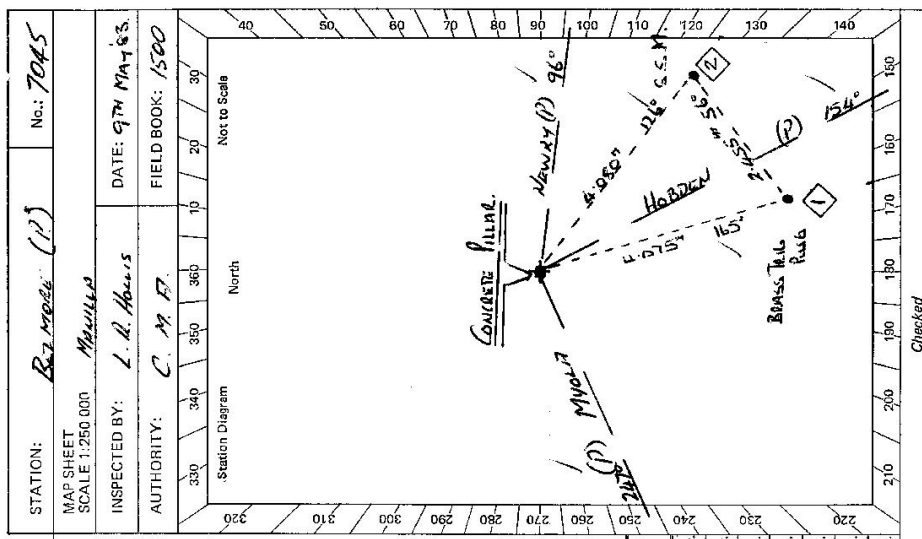

Checked

GEODETIC SURVEY OF A.S.W

CENTRAL MAPPING AUTHORITY


GEODETIC STATION RECONNAISSANCE and MAINTENANCE REPORT

STATION: BELMORE * No.: 7045

MAP SHEET SCALE 1:250 000 MANILLA

INSPECTED BY: D. Kinlyside DATE: 17-11-83

AUTHORITY: CMA FIELD BOOK: C.305

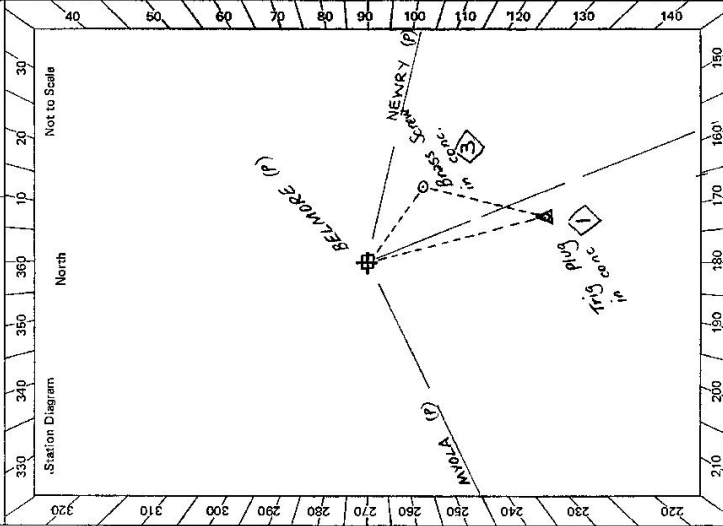

- Description:
- Note: Cross out word or words which do not apply
- Cleared by lanes bearing..... from Trig. Mast
 - Mast & Vanes have been painted white & black respectively.
 - The station/pillar was unpiled/not unpiled/constructed on..... 19....., dimensions now being:
 - Description of mark..... should be explicit, e.g., S/Steel Pillar Plate, Steel plug, Brass plug, Bolt, G.I. Pipe
 - Height of mark.....m. above rock/concrete; Mark is.....m. above below G.L.
 - Height of Top Vanes to Top Mark/Pillar plate.....m. Diameter of Vanes (vertical).....m.
 - Height of Cairn.....m. Diameter of Cairn.....m. Name Plate found/not found/placed.
 - Length of Mast.....m. (approximate if not unpiled)
 - A. TRIG. PLUG (1) set in conc./rock has been placed/found, bearing..... 165.....° M from Mast/Plug/Pillar
 - A. BRASS SCREW (2) set in conc./rock has been placed/found, bearing..... 204.....° M from Mast/Plug/Pillar
 - A. SSM (2) set in conc./rock has been placed/found, bearing..... 126.....° M from Mast/Plug/Pillar
 - A..... set in conc./rock has been placed/found, bearing.....° M from Mast/Plug/Pillar
 - Action required.....

STANDPOINT: Pillar Plate			STANDPOINT: Brass Screw in conc.		
Mark	Direction	Horiz. Distance	Mark	Direction	Horiz. Distance
NEWRY (P)	0 00 00		NEWRY (P)	0 00 00	
Brass Screw in conc.	23 44 59	2.608	HOB DEN (P)	55 19 23	
HOB DEN (P)	55 18 45	1.414	Trig. Plug in conc.	101 24 06	2.622
Trig. Plug in conc.	62 42 58	4.074	MYOLA (P)	141 36 34	
MYOLA (P)	141 35 35	1.317	Pillar Plate	203 44 06	2.605


Checked on U.T.M. Card

Checked by: A.S.W. 7/12/83

Prepared by: A.S.W. 6-12-83

en-2733-2 D. West, Government Printer

Beacon Diagram

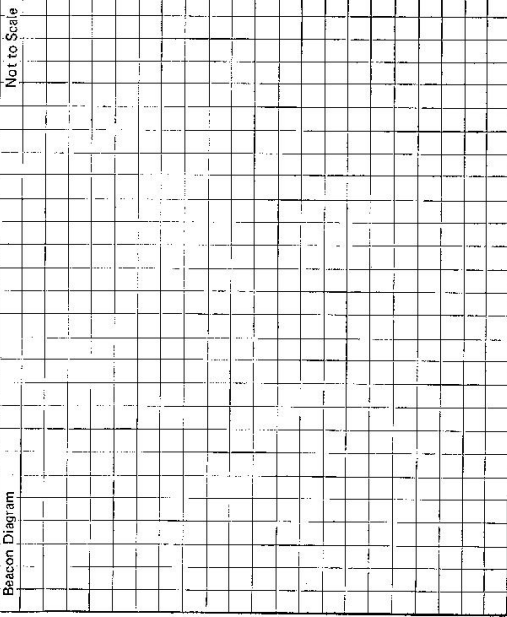

This section to be completed by officer constructing pillar.

Original station mark found/not found.

Description of mark:

Original beacon found/not found.

Description of beacon:

Height Top of Vanes to Top Mark.....m.

Height of mark.....m. above rock/conc.....m. below G.L.

Diameter of Vanes.....m. Height of Cairn.....m.

Original Beacon has/has not been destroyed by me.

STATION

BEAUMORE - 7045

Owner's Name:

Address:

Phone:

ACCESS

Access Report of...../...../19.....was found suitable/unsuitable.

Current Occupant:

Address:

Phone:

Date

Record of Station