

CENTRAL MAPPING AUTHORITY

GEODETIC SURVEY OF N.S.W.

GEODETIC STATION RECONNAISSANCE and MAINTENANCE REPORT

STATION: **BROWN**


MAP SHEET SCALE 1:250 000 TAMWORTH

INSPECTED BY: **G. C. HANNA** DATE: **6/2/79**

AUTHORITY: **C.M.A** FIELD BOOK:

TS: 7052
No.: 1483

- Description:
- Note: Cross out words or words which do not apply*
- Cleared by lances bearing..... from Trig. Mast
 - Mast & Vanes have been painted white & black respectively.
 - The station/pillar was unpiled/not unpiled/constructed on..... 19....., dimensions now being:
Description of mark..... should be explicit, e.g., S/Steel Pillar Plate, Steel plug/Brass plug, Bolt, G.I. Pipe
 - Height of mark.....m. above rock/concrete; Mark is.....m. above G.L.
 - Height of Top Vanes to Top Mark/Pillar plate.....m. Diameter of Vanes (vertical).....m.
 - Height of Cairn.....m. Diameter of Cairn.....m. Name Plate found/not found/placed.
 - Length of Mast.....m. (approximate if not unpiled)
 - A..... set in conc/rock has been placed/found, bearing.....° M from Mast/Plug/Pillar
 - A..... set in conc/rock has been placed/found, bearing.....° M from Mast/Plug/Pillar
 - A..... set in conc/rock has been placed/found, bearing.....° M from Mast/Plug/Pillar
 - A..... set in conc/rock has been placed/found, bearing.....° M from Mast/Plug/Pillar
 - Action required:.....

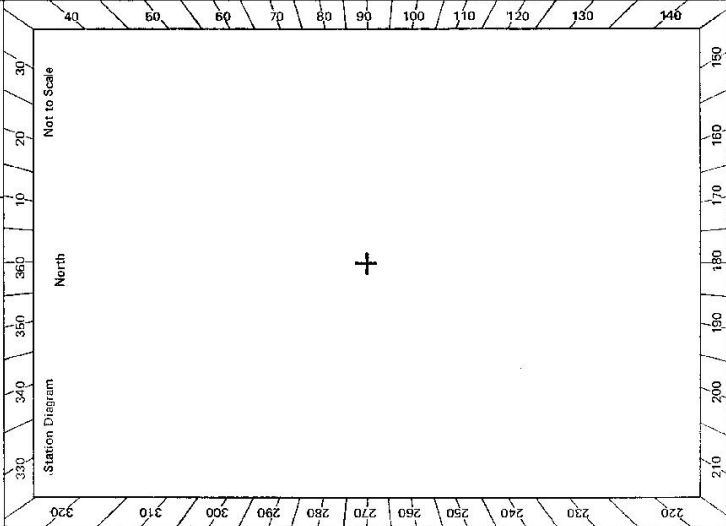

STANDPOINT:			
Mark	Direction	Horiz. Distance	Height Difference
			above standpt.
			below standpt.
			above standpt.
			below standpt.
Prepared by: *G. Hanna* 14/3/79 Checked: *VA* Noted on U.T.M. Card

St 2793-2 D. West, Government Printer

STATION **BROWN** 7052


Owner's Name:
 Address:
 Phone:

Current Occupant:
 Address:
 Phone:

Access Report of 6/12/1979 was found suitable/unsuitable.

Curlewais 11km

ACCESS

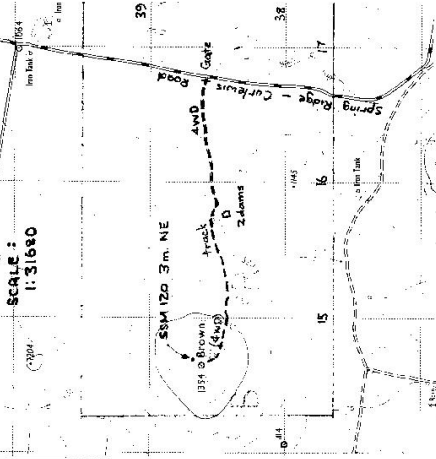

C. M. S. V. fd Most leaning
 360 vision

For access see Goran 1:31680 8935-N-S

Beacon Diagram

Not to Scale

This section to be completed by officer constructing pillar.

Original station mark found/not found.

Description of mark:

Original beacon found/not found.

Description of beacon:

Height Top of Vane to Top Mark:m.

Height of mark:m. above G.L.
 below

Diameter of Vane:m.

Original Beacon has/has not been destroyed by me.

Date

Record of Station

GEODETTIC SURVEY OF A.S.W.

CENTRAL MAPPING AUTHORITY

GEODETTIC STATION RECONNAISSANCE and MAINTENANCE REPORT

STATION: Brown G.S. No.: 7052-183

MAP SHEET SCALE 1:250 000 TAMBOURCH

INSPECTED BY: DAVID J. KAIT DATE: 27 March 1982

AUTHORITY: C.M.A. FIELD BOOK: 01932

- Description: 185 357 m / Note: Cross out word or words which do not apply
For Total clearance - one hour one man with chain saw & brush hook.
2. Mast & Vanes have been painted white & black respectively.
3. The station/pillar was unpiled/not unpiled/concreted on 27 March 1982, dimensions now being: 1.9 m x 1.9 m x 1.9 m
- Description of mark: Steel Pillar Plate, Steel plug, Brass plug, Bolt, G.I. Pipe should be explicit, e.g., S/Steel Pillar Plate, Steel plug, Brass plug, Bolt, G.I. Pipe
- Height of mark: 1.9 m above rock/concrete; Mark is 1.9 m above G.L.
- Height of Top Vanes to Steel Plate: 4.3 m. Diameter of Vanes (vertical): 1.0 m.
- Height of Cairn: 1.2 m. Diameter of Cairn: 1.3 m. Name Plate: found/not found/found.
- Length of Mast: 4.3 m. (approximate if not unpiled)
4. A. S.S.M. No. 120 set in conc/rock has been found/found, bearing: 120° M from Mast/Plug/Pillar
5. A. set in conc/rock has been placed/found, bearing: 260° M from Mast/Plug/Pillar
6. A. set in conc/rock has been placed/found, bearing: 226° M from Mast/Plug/Pillar
7. A. set in conc/rock has been placed/found, bearing: 183° M from Mast/Plug/Pillar
8. Action required: Clearance to Plate Concrete & Installation of Pillar

STANDPOINT:				STANDPOINT:			
Mark	Direction	Horiz. Distance	Height Difference	Mark	Direction	Horiz. Distance	Height Difference
			above standpt.				above standpt.
			below standpt.				below standpt.
			above standpt.				above standpt.
			below standpt.				below standpt.

Prepared by: D. KAIT Checked: John 4/82 Noted on U.T.M. Card

STATION Brown Geostatic Station 7052

Owner's Name: Daniel Math Pky Ltd
 P.O. Box: 5
 Address: Maori Brook N.S.W. 2354
 Phone: Contact Mr. Jim Joyce Phone Limbin 21. Phone: ACCESS 27-3-1982

Current Occupant:
 Address:
 Access Report of 6/2/1979 was found ~~unsuitable~~ unsuitable.
KLMs
 0.0 Coleman Post Office FEATRE TRAVEL WEST TOWARD TAMBAR SPRINGS, SPRING RIDGE.
 2.91 END OF SEALED ROAD.
 8.92 TAKE LEFT FORK IN GRADUAL RANDE, SIGNPOST 'B SPRING RIDGE' PASS ENTRANCE TO 'CALALA HOMESTEAD' ON YOUR L.H.S.
 9.79 OVER CONCRETE CAUSWAY.
 10.21 PASS GRADUAL RANDE ON YOUR R.H.S.
 11.22 THROUGH IRON GATE ON YOUR R.H.S. FOLLOW TRACK WESTERLY ACCESS Paddock.
 12.52 UNDERNEATH DAM, KEEP FOLLOWING FAINT TRACK UNDERNEATH DAM WALL AROUND TO MOUTH OF DAM, TRAVEL TOWARD SINGLE BLAZED PINE TREE.
 13.47 SINGLE BLAZED PINE TREE FROM HERE MAKE OWN WAY WESTERLY ACCESS Paddock, THEN UP SLOPE.
 14.68 Brown G.S.

et: 2732 2 D. West. Government Printer

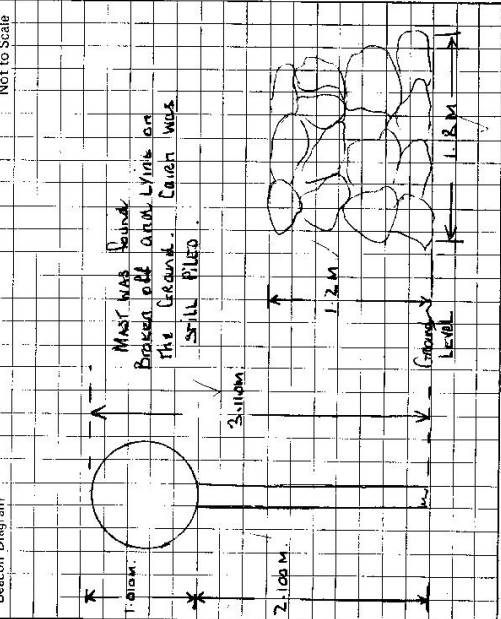

This section to be completed by officer constructing pillar.

Original station mark ~~found~~/not found.

Description of mark:

Original beacon found/not found.

Description of beacon:

Height Top of Vane to Top Mark:m.

Height of mark:m. above G.L. below rock/conc.

Diameter of Vane:m. Height of Cairn:m.

Original Beacon has/has not been destroyed by me.

Date	Record of Station

CENTRAL MAPPING AUTHORITY

GEODETIC SURVEY OF N.S.W.

GEODETIC STATION RECONNAISSANCE and MAINTENANCE REPORT

Description:

Note: Cross out word or words which do not apply


- Cleared by lances bearing $40^{\circ} - 181^{\circ} M$ ✓ $187^{\circ} - 2^{\circ} M$ ✓ $6^{\circ} - 36^{\circ} M$ ✓ from Trig. Mast
- Mast & Vanes have been painted white & black respectively.
- The ~~station~~ pillar was ~~replaced~~/constructed on $19^{\circ} April 1983$ ✓, dimensions now being:
Description of mark ~~S/S~~ Pillar Plate should be explicit, e.g., S/Steel Pillar Plate, Steel plug, Brass plug, Bolt, G.I. Pipe
Height of mark 1.360 m. above ~~rock~~ concrete; Mark is 1.480 m. above G.L.
Height of Top Vanes to ~~Top Mark~~ Pillar plate 1.475 m. Diameter of Vanes (vertical) 7.50 m.
Height of Cairn 0 m. Diameter of Cairn 0 m. Name Plate ~~located~~ placed $20 - 4 - 1983$
Length of Mast 1.575 m. (~~approximately 1.5 m~~)
- A. Brass Bolt set in conc/rock has been ~~placed~~ found, bearing $359^{\circ} M$ from ~~Mast/Plug/Pillar~~
- A. S.S.M No. 120 set in conc/rock has been ~~placed~~ found, bearing $123^{\circ} M$ from Mast/Plug/Pillar
- A. set in conc/rock has been ~~placed~~ found, bearing $173^{\circ} M$ from Mast/Plug/Pillar
- A. set in conc/rock has been ~~placed~~ found, bearing $281^{\circ} M$ from Mast/Plug/Pillar
- Action required:

STANDPOINT: Concrete observation Pillar			STANDPOINT: Brass Trig. Bolt				
Mark	Direction	Horiz. Distance	Height Difference	Mark	Direction	Horiz. Distance	Height Difference
Tally Ho Rt (P)	$0^{\circ} 00' 00''$ ✓	0.00	above standpt.	Tally Ho Rt (P)	$0^{\circ} 00' 00''$ ✓	0.00	above standpt.
Trig G.S.	$89^{\circ} 24' 14''$ ✓	3.603	above standpt.	Trig G.S.	$89^{\circ} 24' 46''$ ✓	4.065	above standpt.
Brass Bolt	$101^{\circ} 16' 42''$ ✓	1.490	above standpt.	S.S.M No. 120	$123^{\circ} 57' 48''$ ✓	0.053	above standpt.
S.S.M No. 120	$113^{\circ} 18' 24''$ ✓	1.519	above standpt.	Conc. obs Pillar	$281^{\circ} 17' 36''$ ✓	3.604	above standpt.
Codanbilla Conc (P)	$281^{\circ} 36' 46''$ ✓	1.54	above standpt.	Codanbilla Conc (P)	$281^{\circ} 37' 27''$ ✓	1.487	above standpt.
Bandatem Rt (P)	$347^{\circ} 08' 11''$ ✓	3.47	above standpt.	Bandatem Rt (P)	$347^{\circ} 08' 34''$ ✓	3.47	above standpt.

Prepared by: D. Kain

Checked: Noted on U.T.M. Card

SR 2733-1

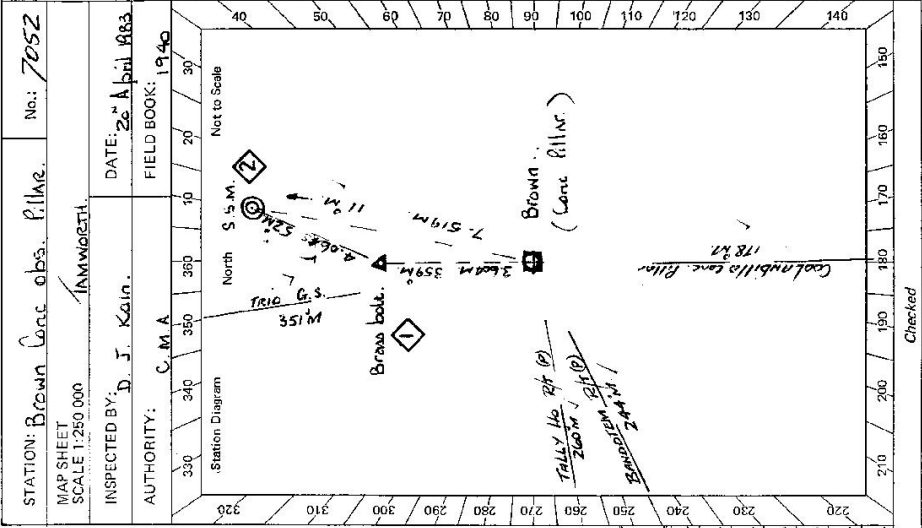

STATION: Brown Conc obs. Pillar. No.: 7052

MAP SHEET SCALE 1:250 000

INSPECTED BY: D. J. Kain. DATE: 20 April 1983

AUTHORITY: C.M.A. FIELD BOOK: 1940


Checked

STATION **Brown Concrete observation Pillar** 20-4-1983

Owner's Name: **FREEHOLD LAND DANGLEMAN PTY LTD**
 Address: **PO Box 5, Nambour, QLD 4559**
 Phone: **(07) 5441 1111**
 Contact: **Mr. Jim Joyce**
 Access Report of 27/3/1982 was found suitable/unsuitable.

Current Occupant:
 Address:
 Phone:

ACCESS FEATURE
 0.00 **Curlewis Post (Office, Travel West TOWN, TAMBOR SPRINGS, SPRING RIDGE**
 3.91 **END OF SEALED ROAD**
 8.92 **TAKE LEFT FURK IN GRAVEL ROADS, SIGNPOST, 18 SPRING RIDGE**
 9.79 **PASS ENTRANCE TO CALALA HOMESTEAD ON YOUR L.H.S**
 10.21 **OVER CONCRETE CAUSEWAY**
 11.22 **PASS GRAVEL ROAD ON YOUR R.H.S Follow TOWNCE WESTERLY**
 12.52 **Through IRON GATE ON YOUR R.H.S Follow TOWNCE WESTERLY**
 13.47 **UNDER BOTTOM WALL OF DAM, KEEP FOLLOWING FAINT TRACK**
 13.70 **UNDERNEATH DAM WALL GROUND TO MOUTH OF DAM, THEN TRAVEL TOWARD SINGLE BLAZED PINE TREE**
 14.68 **AT SINGLE BLAZED PINE TREE, FROM HERE MAKE OWN WAY WESTERLY ACROSS PADDOCKS THEN UP SLIGHT SLOPE. Brown Concrete observation Pillar.**

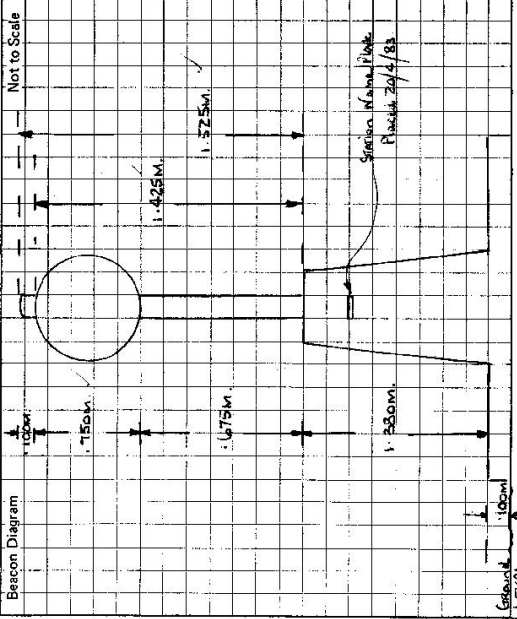

This section to be completed by officer constructing pillar.

Original station mark found/~~not found~~.

Description of mark: **Keystone, Iron, Brass, Bolt**

Original beacon found/~~not found~~.

Description of beacon: **Pole, Calala, 6, 0.1502**

Height Top of Vanes to Top Mark: **2.8350** m.

Height of mark: **0.200** m. **above G.L. below**

Diameter of Vanes: **1.010** m. **Height of Cairn: 1.870** m.

Original Beacon has/~~has not~~ been destroyed by ms.

Date	Record of Station