

GEODETIC SURVEY OF N.S.W.

CENTRAL MAPPING AUTHORITY

GEODETIC STATION RECONNAISSANCE and MAINTENANCE REPORT

Description:

- Note: Cross out word or words which do not apply
- Cleared by lanes bearing..... from Trig. Mast
 - Mast & Vanes have been painted white & black respectively.
 - The station/pillar was unpiled/not unpiled/constructed on..... 19....., dimensions now being:
 Description of mark..... should be explicit, e.g. S/Steel Pillar Plate, Steel plug, Brass plug, Bolt, G.I. Pipe
 Height of mark.....m, above below rock/concrete; Mark is.....m, above below G.L.
 Height of Top Vanes to Top Mark/Pillar platem. Diameter of Vanes (vertical).....m.
 Height of Cairn.....m. Diameter of Cairn.....m. Name plate found/not found/placed.
 Length of Mast.....m. (approximate if not unpiled)
 - A.....set in conc/rock has been placed/found, bearing.....° M from Mast/Plug/Pillar
 - A.....set in conc/rock has been placed/found, bearing.....° M from Mast/Plug/Pillar
 - A.....set in conc/rock has been placed/found, bearing.....° M from Mast/Plug/Pillar
 - A.....set in conc/rock has been placed/found, bearing.....° M from Mast/Plug/Pillar
 - Action required: Find Cairn

STANDPOINT:

Mark	Direction	Horiz. Distance	Height Difference	Mark	Direction	Horiz. Distance	Height Difference
			above standpt				above standpt
			below standpt				below standpt
			above standpt				above standpt
			below standpt				below standpt
Prepared by: D. Gayer

Checked: 1/7 Noted on U.T.M. Card

SI 2733-1

STATION: **GOSFERS T.S.** No: **7056**

MAP SHEET SCALE 1:250 000 **SYDNEY 4**

INSPECTED BY: **G. JONES** DATE: **20-5-83**


AUTHORITY: **CMA** FIELD BOOK: **04880**

CENTRAL MAPPING AUTHORITY
 GEODETIC SURVEY OF NSW: Batch Id: 13916
 GEODETIC STATION RECONNAISSANCE and MAINTENANCE REPORT

Description: *360° N*
 1. Cleared by lanes bearing..... *360° N*..... Note: Cross out word or words which do not apply
 2. Mast & Vanes have been painted white & black respectively. ✓
 3. The station/pillar was unpiled/~~not painted/observed~~ on *26th July 1984*, dimensions now being:
 Description of mark: *7.5. Pillars. Brass* could be explicit, e.g., S/Steel Pillar Plate, Steel plug, Brass plug, Bolt, G.I. Pipe
 Height of mark..... *1.36*.....m. above rock/concrete; Mark is *1530*.....m. above G.L.
 Height of Top Vanes to Top Mark/Pillar plate..... *1465*.....m. Diameter of Vanes (vertical)..... *0.750*.....m.
 Height of Cairn.....m. Diameter of Cairn.....m. Name Plate found/~~not found~~/placed.
 Length of Mast.....m. (approximate if not unpiled)
 4. A *G.I. Pipe (conc. base)* in conc/~~rock~~ has been ~~placed~~/found, bearing..... *17*.....°M from ~~Mark~~/~~rock~~/Pillar
 5. A *Copper Nail*.....set in conc/~~rock~~ has been placed/~~not found~~, bearing..... *280*.....°M from ~~Mark~~/~~rock~~/Pillar
 6. A.....set in conc/~~rock~~ has been placed/~~not found~~, bearing.....°M from Mast/Plug/Pillar
 7. A.....set in conc/~~rock~~ has been placed/~~not found~~, bearing.....°M from Mast/Plug/Pillar
 8. Action required:.....

Mark	Direction	Horiz. Distance	Height Difference	Mark	Direction	Horiz. Distance	Height Difference
<i>TRYPAN GSG</i>	<i>0 00 00</i>			<i>TRYPAN GSG</i>	<i>0 00 00</i>		
<i>Copper Nail</i>	<i>359 29 40</i>	<i>4.589</i>	<i>2.129</i>	<i>Copper Nail</i>	<i>02 43 30</i>	<i>6.331</i>	<i>0.859</i>
<i>G.I. PIPE</i>	<i>01 08 40</i>	<i>1.765</i>	<i>1.269</i>	<i>Conc Obs Pillar</i>	<i>12 30</i>	<i>1.765</i>	<i>1.269</i>
<i>CONCRETE MAST GSG</i>	<i>369 55 00</i>			<i>CONCRETE MAST GSG</i>	<i>089 55 20</i>		

STANDPOINT: *Conc Obs Pillar*
 STATION: *G.I. PIPE*
 Prepared by: *P. Batts* 12.84
 Checked: *P. Batts* Noted on U.T.M. Card

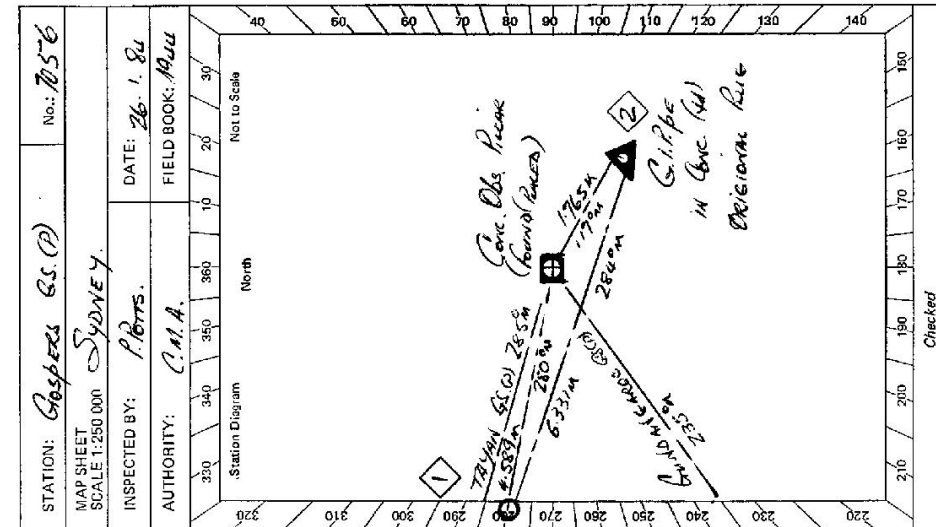

STATION: *GOSPELS G.S. (P)* No.: *7056*
 MAP SHEET SCALE 1:250 000
 INSPECTED BY: *P. Batts* DATE: *26.1.84*
 AUTHORITY: *C.M.A.* FIELD BOOK: *MWU*

7056M G.S. (P) 28.5m
 4.589m
 280°M
 6.331m
 284°M
 17.65m
 17°M
 G.I. PIPE
 Conc. Obs Pillar
 Conc. Obs Pillar
 11 Conc. (H)
 ORIGINAL RISE
 25.55m
 285°M
 285°M
 285°M

SI 2735-2 D. West, Government Printer

STATION


Coastal 5501 TS 7056

Owner's Name: *WILSONI*
 Address: *14710/148 FERRIS*
 Phone:

Current Occupant: *Access & Land Owner*
 Address: *Mt. C. 6.00M KIRK*
 Phone: *08-92005*
CLANNA 796210

ACCESS

Access Report of *26.1.1984* was found suitable/unsuitable.

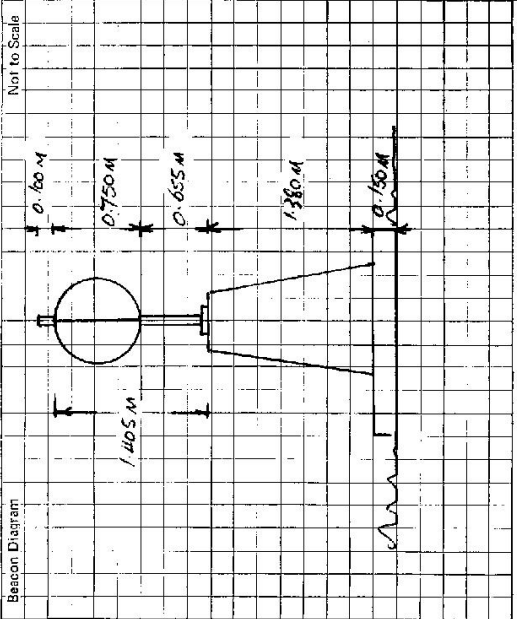

This section to be completed by officer constructing pillar.

Original station mark found/~~not found~~.

Description of mark: *C.I.P.A.*

Original beacon ~~found~~/not found.

Description of beacon:

Height Top of Vanes to Top Mark:m.

Height of mark:m. above below G.L.
 rock/conc.m. below

Diameter of Vanesm. Height of Cairnm.

Original Beacon has/has not been destroyed by me.

Date	Record of Station