

CENTRAL MAPPING AUTHORITY

GEODETTIC SURVEY OF N.S.W.

GEODETTIC STATION RECONNAISSANCE and MAINTENANCE REPORT

Description:

1. Cleared by Janes bearing.....
 Note: Cross out word or words which do not apply
 from Trig. Mast

2. Mast & Vanes have been painted white & black respectively.

3. The station/pillar was unpiled/not unpiled/constructed on....., dimensions now being:

Description of mark.....should be explicit, e.g., S/Steel Pillar Plate, Steel plug, Brass plug, Bolt, G.I. Pipe

Height of mark.....m. above rock/concrete; Mark is.....m. above G.L.

Height of Top Vanes to Top Mark/Pillar plate.....m. Diameter of Vanes (vertical).....m.

Height of Cairn.....m. Diameter of Cairn.....m. Name Plate found/not found/placed.

Length of Mast.....m. (approximate if not unpiled)

4. A.....set in conc/rock has been placed/found, bearing.....° M from Mast/Plug/Pillar

5. A.....set in conc/rock has been placed/found, bearing.....° M from Mast/Plug/Pillar

6. A.....set in conc/rock has been placed/found, bearing.....° M from Mast/Plug/Pillar

7. A.....set in conc/rock has been placed/found, bearing.....° M from Mast/Plug/Pillar

8. Action required:.....

STANDPOINT:

STANDPOINT:

Mark	Direction	Horiz. Distance	Height Difference	Mark	Direction	Horiz. Distance	Height Difference
			above standpt				above standpt
			below				below
			above standpt				above standpt
			below				below
Prepared by:

Checked:

Noted on U.T.M. Card

Checked


St 2733-1

STATION: BALLANYA G.S. No.: 706

MAP SHEET SCALE 1:250 000 HOLLOWSONG G.S.


INSPECTED BY: M.L. Morrison DATE: 27/10/78

AUTHORITY: C.M.A. FIELD BOOK: 1710

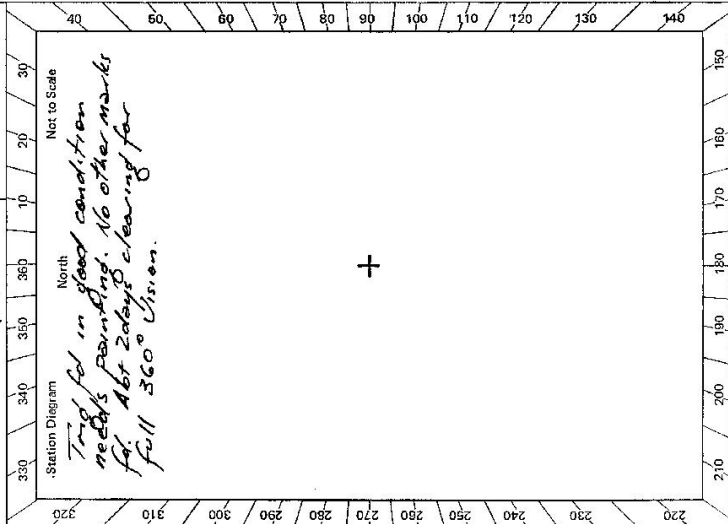

St 2733-2 D. West, Government Printer

Beacon Diagram

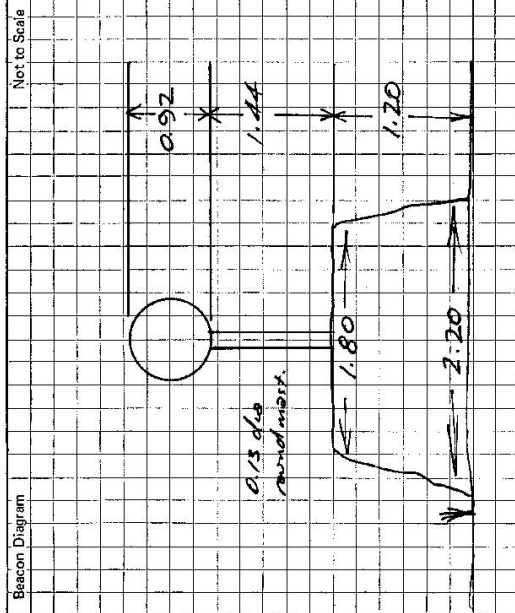

This section to be completed by officer constructing pillar.

Original station mark found/not found.

Description of mark:

Original beacon found/not found.

Description of beacon:

Height Top of Vanes to Top Mark.....m.

Height of mark.....m. above G.L. below

Diameter of Vanesm. Height of Cairnm.

Original Beacon has/has not been destroyed by me.

STATION

Ballanyra G.S.

706

Owner's Name:

Address:

Phone:

Current Occupant:

Address:

Phone:

ACCESS

Access Report of 21.12.1978 was found suitable/unusable.

Km

0.00

1.10

6.30

9.65

9.75

9.85

9.90

10.05

10.50

Direction.

Marulan Rd. Head north along Hwy.

Turn right Sign 'Tollong' Sanderson 34 Moss Vale 52.

Turn right Sign 'Long Point Lookout Picnic Area 6'

Turn left into property 'GLEN PEBBLE'.

Pass house on left.

Wire gate just past house on left.

Wire gate, straight ahead up faint track into timber

Gateway Vaer right up spur.

Ballanyra G.S.

Date

Record of Station

Integral Survey of N.S.W.

Department of Lands

RECONNAISSANCE and MAINTENANCE REPORT

This Trig. Station has been:-

Note: Cross out word or words which do not apply

1. Completely cleared to permit 360° vision to surrounding Trigs.
2. Cleared by lines bearing 42° M, 150° M & 305° M from Trig. Mast
3. Trig. Mast & Vanes have been painted white & black respectively.
4. The Trig. was unpiled/~~not unpiled~~, dimensions now being:

Description of mark Brass Plug should be explicit, e.g. Steel plug, Brass plug, Bolt, Concrete Pillar

Height of mark 0.04 m above rock/concrete 0.04 m above G.L.

Height of Top Vanes to Top Mark/Top pillar plate 4.15 m Diameter of Vanes (vertical) 0.00 m.

Height of Cairn 1.8 m. Diameter of Cairn m.

Length of Mast A 1 m. (approximate if not unpiled)

5. A set in conc/rock has been placed/fd m. bearing °M from Trig. Mast/pillar
6. A set in conc/soil has been placed/fd m. bearing °M from Trig. Mast/pillar
7. A set in conc/soil has been placed/fd m. bearing °M from Trig. Mast/pillar
8. A set in conc/rock has been placed/fd m. bearing °M from Trig. Mast/pillar

9. Connection to m. bearing °M

10. Connection to m. bearing °M

11. Connection to m. bearing °M

12. Connection to m. bearing °M

13. Diff. Hr. is m. above below

14. Diff. Hr. is m. above below

15. Diff. Hr. is m. above below

16. Diff. Hr. is m. above below

Prepared by: H. G. HELSHAMChecked: P. R. HARRISON

STATION TS 706 BALLANTRA

Co: CAMDEN

Map Sheet: WINGELLO

No: 8928-IV-3

Inspected by: H. G. HELSHAM


Date: 28-08-80

Authority INTEGRATION SURVEY

Field Book: 1A61/10

Beacon Diagram

Not to Scale

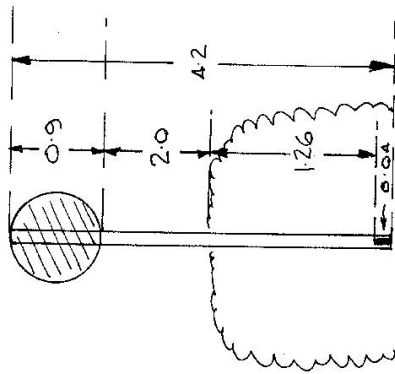

Date 28/08/80

Record of Station

VISITED BY H. G. HELSHAM I.S.B.

GS 24

ST 2733-2 D. West, Government Printer

STATION		BALLANYA	706
Owner's Name: <u>TR 13962</u>	Current Occupant: <u>MR G.E. CAMPBELL</u>		
Address:	Address: <u>"GLEN PEBBLE"</u>		
Phone:	Phone: <u>(048) 57 0286</u>		
ACCESS			
Access Report of <u>28/08/1989</u> was found <u>unsuitable</u> (unsuitable).			
Km	Feature		
0.0	From TALLONG RLY STN DRIVE TOWARDS MAROLAN		
2.0	TURN LEFT ALONG ROAD TO "LONGPOINT LOOKOUT"		
5.32	TURN LEFT THROUGH IRON GATE ~ SIGN "GLEN PEBBLE"		
5.45	PASS HOUSE ON LEFT		
5.52	TURN LEFT THROUGH GATE		
5.59	PASS GATEWAY ON LEFT ~ HEAD N E TO FENCE AND FOLLOW FENCE UP HILL		
5.75	PASS THROUGH WIRE GATE ~ FOLLOW FAINT TRACK		
5.85	CROSS GULLY		
6.05	AT TOP OF SPUR TURN RIGHT AND FOLLOW SPUR TO TRIG		
6.37	"BALLANYA" TRIG		
Date			
Record of Station			

Beacon Diagram		Not to Scale
<p style="text-align: center;"><i>CAIRN, POLE & DISCS IN REASONABLE CONDITION</i></p>		

This section to be completed by officer constructing pillar.	
Original station mark found/not found.	
Description of mark:	
Original beacon found/not found.	
Description of beacon:	
Height Top of Vanes to Top Markm.
Height of markm. above G.L. below
Diameter of Vanesm. Height of Cairn
Original Beacon has/has not been destroyed by me.	