


TS 7067
No: 1407

STATION: CARLTON
MAP SHEET SCALE 1:250 000
INSPECTED BY: A. GARSIDE
DATE: 25-5-81
AUTHORITY: C.M.A.
FIELD BOOK: 1987

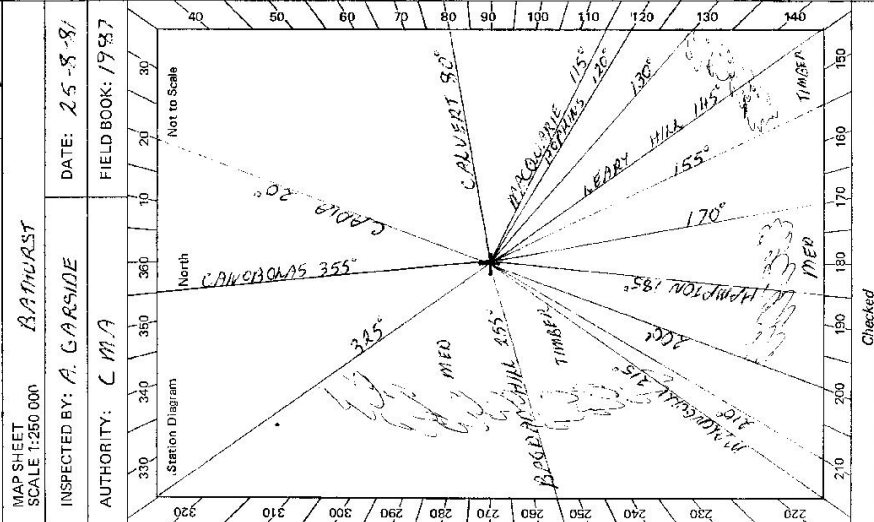

CENTRAL MAPPING AUTHORITY
GEODETTIC SURVEY OF NSW
GEODETTIC STATION RECONNAISSANCE and MAINTENANCE REPORT

Description:
1. Cleared by lanes bearing $325^\circ-130'$ $155^\circ-170'$ $100^\circ-210'$ from Trig. Mast
Note: Cross out word or words which do not apply
2. Mast & Vanes have been painted white & black respectively.
3. The station/pillar was unspliced/not unspliced/constructed on $2.5-9$ 19.3 dimensions now being:
Description of mark.....should be explicit, e.g., S/Steel Pillar Plate, Steel plug, Brass plug, Bolt, G.I. Pipe
Height of mark.....m. ^{above} _{below} rock/concrete; Mark is.....m. ^{above} _{below} G.L.
Height of Top Vanes to Top Mark/Pillar plate.....m. Diameter of Vanes (vertical) 1.0m.
Height of Cairn.....m. Diameter of Cairn 3.0m. Name Plate found/not found/placed.
Length of Mast.....m. (approximate if not unspliced)
4. A.....set in conc/rock has been placed/found, bearing.....°M from Mast/Plug/Pillar
5. A.....set in conc/rock has been placed/found, bearing.....°M from Mast/Plug/Pillar
6. A.....set in conc/rock has been placed/found, bearing.....°M from Mast/Plug/Pillar
7. A.....set in conc/rock has been placed/found, bearing.....°M from Mast/Plug/Pillar
8. Action required: OK TO BUILD PILLAR AND CLEAR AS NECESSARY

STANDPOINT:

Mark	Direction	Horiz. Distance	Height Difference	Mark	Direction	Horiz. Distance	Height Difference
			above standpt.				above standpt.
			below standpt.				below standpt.
			above standpt.				above standpt.
			below standpt.				below standpt.

Prepared by: [Signature] 14/10/89 Checked: [Signature] 14/10/89
Noted on U.T.M. Card

Station Diagram
Not to Scale
Checked

CENTRAL MAPPING AUTHORITY
 GEODETIC SURVEY OF NSW
 GEODETIC STATION RECONNAISSANCE and MAINTENANCE REPORT

STATION: **CARLTON (P)** No.: **7067**
 MAP SHEET SCALE 1:250 000
 INSPECTED BY: **G FORD** DATE: **27-7-83**
 AUTHORITY: **CMA** FIELD BOOK: **1945**

Description:
 1. Cleared by lanes bearing **331° 36' 7" - 28° 42' 18" - 155° 16' 18" - 187° 15' 20"** from Trig. Mast
 2. Mast & Vanes have been painted white & black respectively.
 3. The station/pillar was ~~unplaced/not supplied~~ constructed on **26-7-1983**, dimensions now being:
 Description of mark: **PLUG. PILE. PLATE** should be explicit, e.g. S/Steel Pillar Plate, ~~Steel plug, Brass plug, Bolt, G.I. Pipe~~
 Height of mark: **1.375** m. above ~~rock/concrete~~ ^{above G.I.} Mark is **1.475** m. above G.I.
 Height of Top Vanes to Top Mark/Pillar plate: **1.410** m. Diameter of Vanes (vertical): **0.150** m.
 Height of Cairn: m. Diameter of Cairn: m. Name Plate ~~found/lost~~ **found** placed.
 Length of Mast: m. (approximate if not unpled)
 4. **BRASS TRIG. PLUG** set in ~~conc/rock~~ **found**, bearing **324° 0' M** from Mast/Plug/Pillar
 5. **COPPER NAIL** set in ~~conc/rock~~ **has been placed**/found, bearing **330° 0' M** from Mast/Plug/Pillar
 6. **G.I. PIPE** set in ~~conc/rock~~ **has been placed**/found, bearing **328° 0' M** from Mast/Plug/Pillar
 7. A..... set in ~~conc/rock~~ **has been placed**/found, bearing ° M from Mast/Plug/Pillar
 8. Action required:

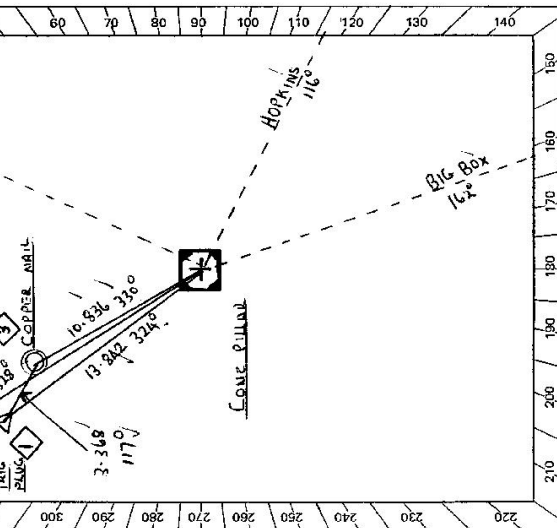

STANDPOINT:	CONC PILLAR	BRASS TRIG. PLUG					
Mark	Direction	Mark	Direction	Height Difference	Horiz. Distance	Height Difference	Horiz. Distance
¹⁰ HOPKINS (GS) ✓	0 00 00	HOPKINS (GS)	0 00 00	above standpt.		above standpt.	
¹¹ BIG BOX (P) ✓	41 48 00	CONC PILLAR	18 37 20	below standpt.	13.843	below standpt.	1.320
¹² TRIG PLUG	198 38 50	BIG BOX (P)	41 46 00	below standpt.		below standpt.	
¹³ G.I. PIPE	204 47 20	G.I. PIPE	230 12 10	below standpt.		below standpt.	
¹⁴ COPPER NAIL	205 44 20	CADIA (P)	261 44 30	below standpt.		below standpt.	
¹⁵ CADIA (P)	261 44 30	COPPER NAIL	355 12 10	below standpt.		below standpt.	

Prepared by: **G Ford** Checked: **T.H. Nelson 28.8.83** Noted on U.T.M. Card
 S: 2733-1 Checked

GS 24

<p>Owner's Name: MR. BRUCE GORDON Address: SATLEIGH PASTORAL CO. Phone: 66 3 111</p> <p>Current Occupant: JACK LAWSON Address: LIVES IN HOUSE DOWN ROAD FURTHER Phone: 66 4 316</p> <p>STATION: CARLTON (P) TS 7067</p>	<p>ACCESS</p> <p>Access Report of 31.8.1981 was found suitable/unusable.</p> <p>0-00 MANDURAMA P.O. HEAD TOWARDS COWRA / 0-06 TURN RIGHT TOWARDS BURNT YARDS / 3-70 BRIDGE (BIFLUGULA RIVER) / 7-74 TO LEFT TOWARDS FOREST REEF 21 / 11-38 FOLLOW BITUMEN TO RIGHT (FOREST REEF) / 16-66 TO LEFT SIGNS [14 FOREST REEF ← CARCORRA IS / → ORANGE 36] / 19-23 LEFT OVER CEMENT BRIDGE (PANUARAQ) / 24-19 PASS ROAD ON RIGHT TO CADIAG / 25-45 BRIDGE / 26-67 DOUBLE IRON GATES CATTLE YARDS / THROUGH DOUBLE IRON GATES ON LEFT HEAD PAST YARDS / AND MAKE OWN WAY UP HILL TO TRIG</p>
<p>Beacon Diagram</p> <p style="text-align: right;">Not to Scale</p>	<p>This section to be completed by officer constructing pillar.</p> <p>Original station mark found/not found.</p> <p>Description of mark: BRASS TRIG. PLYG.</p> <p>Original beacon found/not found.</p> <p>Description of beacon: CAIAN POLE or DISC</p> <p>Height Top of Vane to Top Mark: 3.725 m.</p> <p>Height of mark: 0.45 m. above rock/0.45 m. above G.L.</p> <p>Diameter of Vane: 1.000 m. / Height of Cairn: 1.200 m.</p> <p>Original Beacon has/has not been destroyed by me.</p>
	<p>Date</p> <p>Record of Station</p>