

TS 7077  
No. 4337


STATION: DEN  
MAP SHEET SCALE 1:250 000  
INSPECTED BY: P. HOLDEN  
AUTHORITY:

DATE: 9-12-87  
FIELD BOOK:

STATION: DEN  
MAP SHEET SCALE 1:250 000  
INSPECTED BY: P. HOLDEN  
AUTHORITY:

DATE: 9-12-87  
FIELD BOOK:

DATE: 9-12-87  
FIELD BOOK:

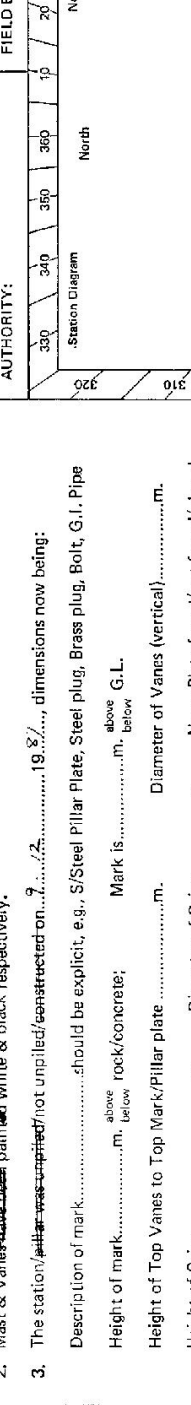

*Note: Cross out word or words which do not apply*

- Cleared by lanes bearing..... from Trig. Mast
- Mast & Vanes ~~to be painted~~ <sup>require</sup> white & black respectively.
- The station, ~~pillar~~ <sup>is</sup> ~~was~~ <sup>is</sup> ~~unplaced~~ <sup>is</sup> ~~not~~ <sup>is</sup> ~~unplaced~~ <sup>is</sup> ~~constructed~~ <sup>is</sup> on..... 19.8'....., dimensions now being:
  - .....m. above rock/concrete; Mark is.....m. above G.L.
  - .....m. above rock/concrete; Mark is.....m. above G.L.
- Description of mark.....should be explicit, e.g., S/Steel Pillar Plate, Steel plug, Brass plug, Bolt, G.I. Pipe
- Height of mark.....m. above below rock/concrete; Mark is.....m. above below G.L.
- Height of Top Vanes to Top Mark/Pillar plate.....m. Diameter of Vanes (vertical).....m.
- Height of Cairn.....m. Diameter of Cairn.....m. Name Plate found/not found/placed.
- Length of Mast.....m. (approximate if not unplaced)
- A..... set in conc/rock has been placed/found, bearing.....°M from Mast/Plug/Pillar
- A..... set in conc/rock has been placed/found, bearing.....°M from Mast/Plug/Pillar
- A..... set in conc/rock has been placed/found, bearing.....°M from Mast/Plug/Pillar
- A..... set in conc/rock has been placed/found, bearing.....°M from Mast/Plug/Pillar
- Action required: ~~paint~~ <sup>No clearing</sup>.....

STANDPOINT:

Mark	Direction	Horiz. Distance	Height Difference	Mark	Direction	Horiz. Distance	Height Difference
			above standpt				above standpt
			below				below
			above standpt				above standpt
			below				below
Prepared by: P. Holden 12-12-87 Checked: P. Holden 15-3-88

Noted on U.T.M. Card

GS 24

Sr 2733-2 D. West, Government Printer Beacon Diagram	STATION <u>Pen 15 7077</u> Owner's Name: <u>?</u> Address: ..... Phone: ..... Current Occupant: ..... Address: ..... Phone: ..... ACCESS Access Report of <u>9/12/19</u> was found suitable/unsuitable. WATSONS CREEK HALL <u>have west.</u> 0-27 Bridge 0-34 Turn Left 0-57 Grid 1-21 Veer Left <u>to main road.</u> 1-72 Between Bids. 2-07 Veer Left 2-10 Grid 2-83 Veer Left 4-22 Gate 4-37 Abandoned Bids <u>100m RHS.</u> 4-60 Follow track to Right <u>(just before gate.)</u> 5-51 Detour to Right around <u>eroded track</u> 6-04 Detour to Right around <u>eroded track</u> 6-62 To the Right 7-61 Veer Left 8-01 Gully Crossing 8-71 Gate 9-17 Shed <u>RHS</u> 10-19 Turn Left <u>towards trig</u> 10-37 Fence <u>150m from trig</u>	Not to Scale  This section to be completed by officer constructing pillar. Original station mark found/not found. Description of mark: ..... Original beacon found/not found. Description of beacon: ..... Height Top of Vanes to Top Mark .....m. Height of mark .....m. above G.L. .....m. below Diameter of Vanes .....m. Height of Cairn .....m. Original Beacon has/not been destroyed by me.
Date ..... Record of Station .....		

CENTRAL MAPPING AUTHORITY

GEODETIC SURVEY OF NSW

GEODETIC STATION RECONNAISSANCE and MAINTENANCE REPORT

Description:

Note: Cross out word or words which do not apply

1. Cleared by lanes bearing..... cleared by lanes bearing 360°..... from Trig. Mast
2. Mast & Vanes have been painted white & black respectively.
3. The station/pillar was unpiled/not unpiled/constructed on..... 1st Apr 1982....., dimensions now being:  
 Description of mark..... should be explicit, e.g., S/Steel Pillar Plate, Steel plug, Brass plug, Bolt, G.I. Pipe  
 Height of mark..... 1.1m..... above/below rock/concrete; Mark is..... above..... G.L.  
 Height of Top Vanes to Top Mark/Pillar plate..... 1.1m..... Diameter of Vanes (vertical)..... 1.1m.....  
 Height of Cairn..... 1.1m..... Name Plate found/not found/placed.  
 Length of Mast..... 1.1m..... (approximate if not unpiled)
4. A..... set in conc/rock has been placed/found, bearing..... 0° M from Mast/Plug/Pillar
5. A..... set in conc/rock has been placed/found, bearing..... 0° M from Mast/Plug/Pillar
6. A..... set in conc/rock has been placed/found, bearing..... 0° M from Mast/Plug/Pillar
7. A..... set in conc/rock has been placed/found, bearing..... 0° M from Mast/Plug/Pillar
8. Action required:..... Construction of pillar required.....

STANDPOINT:


STANDPOINT:

Mark	Direction	Horiz. Distance	Height Difference	Mark	Direction	Horiz. Distance	Height Difference
			above standpt				above standpt
			below				below
			above standpt				above standpt
			below				below
Prepared by: D. HALLS

Checked:

Noted on U.T.M. Card

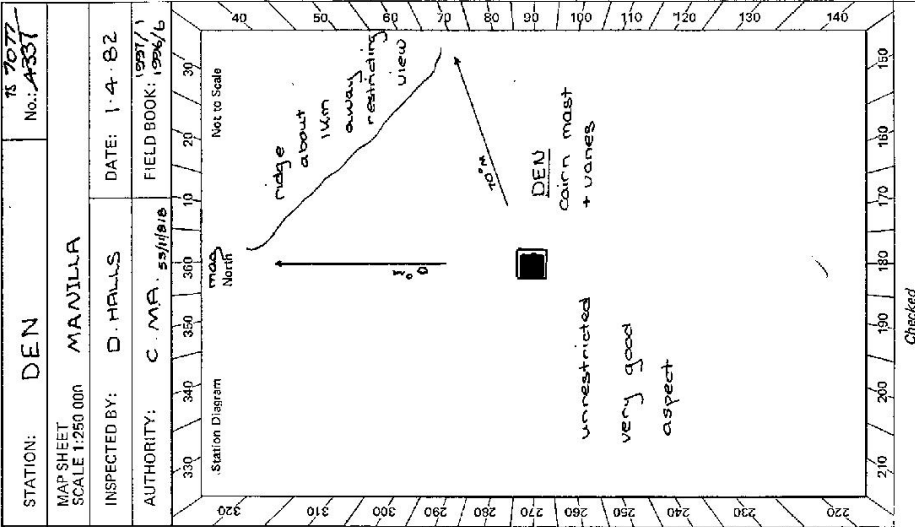

Checked

STATION: DEN

MAP SHEET SCALE 1:250 000

INSPECTED BY: D. HALLS

DATE: 1-4-82

AUTHORITY: C.M.A. ss/1/1/1

FIELD BOOK: 1982/1

No.: 4531

<p>STATION DEN TS 7077</p> <p>Owner's Name: <u>CROWN LANDS</u>                  Address: <u>TAMMARTH OFFICE</u>  <u>C. O'SO</u>                  Phone: .....</p> <p>Current Occupant: <u>L.T.B. HAWKINS</u>                  Address: <u>BOX VALE</u>  <u>HAYS CREEK MANILA</u>                  Phone: <u>(067) 861531</u></p> <p>ACCESS <u>1-4-1982</u></p> <p>Access Report of <u>12/12/1982</u> was found suitable/unsuitable.</p>	<p>Feature</p> <p>0.0 At intersection at Watsons creek head toward Manila.</p> <p>0.3 Turn left just after concrete bridge.</p> <p>2.2 Veer left just after yards.</p> <p>4.3 Iron gate.</p> <p>4.4 Pass track on right (leads to house).</p> <p>4.7 Veer right just before iron gate.</p> <p>6.4 Pass track on left.</p> <p>6.8 Pass track on left.</p> <p>7.8 Pass track on right.</p> <p>9.0 Iron gate.</p> <p>9.45 Shed on right.</p> <p>9.6 Iron gate.</p> <p>10.5 Turn left off track and pick own way along ridge through fallen timber.</p> <p>10.7 AT netting fence easy 5 mins walk along ridge to trig A at southern end.</p>	<p>DEPARTMENT OF LANDS                  ROYAL AUSTRALIAN ARMY</p>
<p>Beacon Diagram</p> <p style="text-align: right; font-size: small;">Not to Scale</p>	<p>This section to be completed by officer constructing pillar.</p> <p>Original station mark found/not found.</p> <p>Description of mark: .....</p> <p>Original beacon found/not found.</p> <p>Description of beacon: .....</p> <p>Height Top of Vanes to Top Mark .....m.</p> <p>Height of mark.....m. above G.L. below rock/conc.....m.</p> <p>Diameter of Vanes .....m. Height of Cairn .....m.</p> <p>Original Beacon has/has not been destroyed by me.</p>	
		<p>Record of Station</p> <p>Date</p>


CENTRAL MAPPING AUTHORITY  
 GEODETIC SURVEY OF N.S.W.  
 GEODETIC STATION RECONNAISSANCE and MAINTENANCE REPORT  
 Batch 1554

Description:

- Note: Cross out word or words which do not apply
1. Cleared by lanes bearing 67° 33.8' N from Trig. Mast Pillar. Vision blocked by trees on Rock and higher timbered ridge. Mast & Vanes have been painted white & black respectively. 338.2 m. Possible to clear.
  2. The station/pillar was ~~unusable~~/constructed on 16 September 1983, dimensions now being: Description of mark: Steel Pillar should be explicit, e.g. S/Steel Pillar Plate, Steel plug, Brass plug, Bolt, G.I. Pipe
  3. Height of mark: 1.385 m above rock/concrete; Mark is 1.485 m above G.L.  
 Height of Top Vanes to Top ~~mark~~/Pillar plate 1.395 m. Diameter of Vanes (vertical) 150 m.  
 Height of Cairn 1.485 m. Diameter of Cairn 19.9 m. Name Plate ~~found/~~placed 19.9.1983.  
 Length of Mast 4.85 m (approximate if not specified)
  4. A Cartridge Case set in conc/rock has been placed/found, bearing 255.0° M from Mast/Pillar  
 5. A Copper Nail set in conc/rock has been placed/found, bearing 47.3° M from Mast/Pillar  
 6. A Conc. Obs Pillar set in conc/rock has been placed/found, bearing .....° M from Mast/Plug/Pillar  
 7. A Conc. Obs Pillar set in conc/rock has been placed/found, bearing .....° M from Mast/Plug/Pillar
  8. Action required: .....

STANDPOINT: Concrete obs. Pillar			STANDPOINT: Cartridge Case			
Mark	Direction	Horiz. Distance	Height Difference	Direction	Horiz. Distance	Height Difference
Bungee Mulla (P)	0 00 00		above standpt	Bungee Mulla (P)	0 00 00	above standpt
Rosemary (P)	74 01 40		below standpt	Rosemary (P)	74 02 08	above standpt
Cartridge Case	11 10 42	3.572	1.633 above standpt	Copper Nail	219 37 44	3.455 above standpt
Copper Nail	164 02 51	4.115	1.441 above standpt	Moonbi Pillar	257 58 25	above standpt
Moonbi Pillar	257 56 58		below standpt	Conc. Obs Pillar	291 10 04	3.571 above standpt
			above standpt			below standpt
			below standpt			above standpt
			above standpt			below standpt

Prepared by: D. Kaur  
 Checked: .....  
 Noted on U.T.M. Card

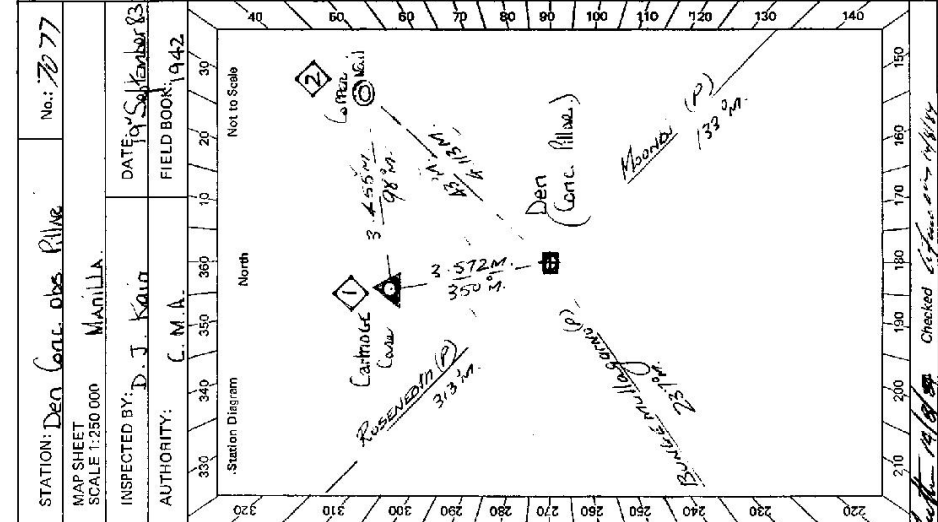

STATION: Den Conc. obs. Pillar No.: 7077  
 MAP SHEET SCALE 1:250 000 MANILLA  
 INSPECTED BY: D. J. Kaur DATE: 16 September 83  
 AUTHORITY: C. M. A. FIELD BOOK: 1442


STATION DEN CONCRETE OBSERVATION PILLAR 71 7077

Owner's Name: GRAHAM LAMAS  
 Address: 11 MUMBERTH RD, P. 118  
 Phone: (067) 662 1988  
 LESSEE: RON BARNETT  
 Address: BOX WALK  
 Phone: HILLS CREEK MANILLA (067) 84 1531

ACCESS  
 Access Report of J.1.4/1988 was found suitable/unsuitable  
 FEATURE

- K.M.  
 0.0 At Intersection at Watsons Creek  
 Head TAMWAC Manilla.  
 0.3 Turn Left Just after Concrete bridge.  
 2.2 Turn Left Just after Yards.  
 4.3 Iron Gate.  
 4.4 Pass Track on Right. (LEADS TO HOUSE)  
 4.7 Turn Right Just before Iron Gate.  
 6.4 Pass Track on Left.  
 6.8 Pass Track on Left.  
 7.8 Pass Track on Right.  
 9.0 Iron Gate.  
 9.45 Turn on Right.  
 9.6 Iron Gate.  
 10.5 Turn Left off track and pick own way along ridge known fallen timber.  
 10.7 At netting fence east 5 minute walk along ridge to concrete pillar at Southern End.

Note: 4 WD AND DRY WEATHER ACCESS ONLY.

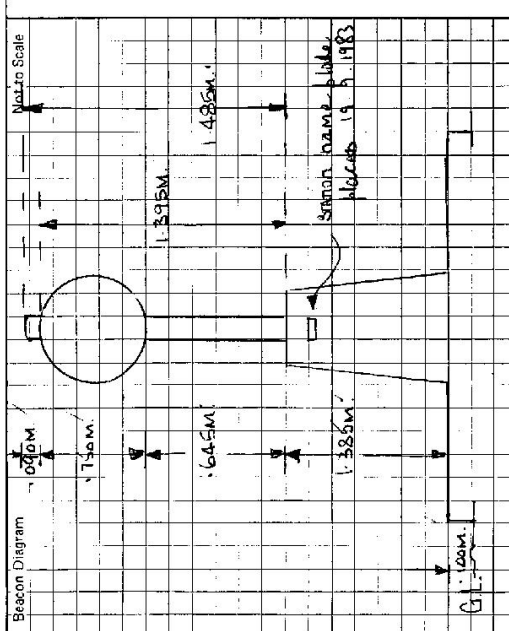

This section to be completed by officer constructing pillar.  
 Original station mark found/~~not found~~.  
 Description of mark: CONCRETE CEMENT  
 Original beacon found/~~not found~~.  
 Description of beacon: Pole, cap, disc  
 Height Top of Vanes to Top Mark: 2.185 m.  
 Height of mark: 0.05 m. above 1.86 m. below G.L.  
 Diameter of Vanes: 100 m. Height of Cairn: 1.250 m.  
 Original Beacon has/~~not~~ been destroyed by me.

Date	Record of Station



