



STATION **BALLINGALL * 708**

Owner's Name: **Crown Land (W.R.C.)**
 Address: **Parton 201**
 See W.R.C. DP. 10. 5. 11. 11.
 Phone:

Current Occupant: **Lessee**
 Address: **Mc W. J. J. J. J.**
 Phone: **63. 6260.**

ACCESS
MACANDEGA 1:250,000
MAP REFERENCE 398/773

Access Report of H.T. 11971 was found suitable/unsuitable.

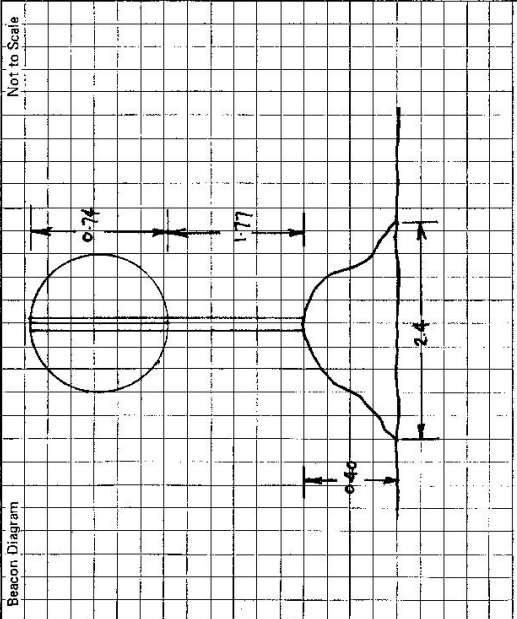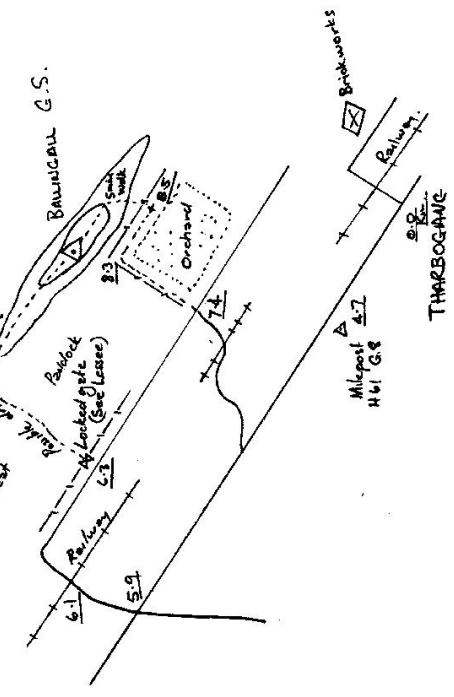

This section to be completed by officer constructing pillar.

Original station mark found/not found.

Description of mark:

Original beacon found/not found.

Description of beacon:

Height Top of Vanes to Top Mark:m.

Height of mark:m. above G.L. below G.L.

Diameter of Vanes:m. Height of Cairn:m.

Original Beacon has/has not been destroyed by me.

Date	Record of Station