

TS-7081

CENTRAL MAPPING AUTHORITY

GEODETTIC SURVEY OF M.S.W.

GEODETTIC STATION RECONNAISSANCE and MAINTENANCE REPORT

STATION: **GILLAMATONG** No.: **2493**

MAP SHEET SCALE 1:250 000 **CANBERRA**

INSPECTED BY: **G. C. HANNA** DATE: **2 / 4 / 79**

AUTHORITY: **C. M. A.** FIELD BOOK:

Description:

1. Cleared by lanes bearing.....  
 Note: Cross out word or words which do not apply from Trig. Mast

2. Mast & Vanes have been painted white & black respectively.

3. The station/pillar was unpiled/not unpiled/constructed on..... 19....., dimensions now being:  
 Description of mark.....should be explicit, e.g., S/Steel Pillar Plate, Steel plug, Brass plug, Bolt, G.I. Pipe

Height of mark.....m. <sup>above</sup> <sub>below</sub> rock/concrete; Mark is.....m. <sup>above</sup> <sub>below</sub> G.L.

Height of Top Vanes to Top Mark/Pillar plate.....m. Diameter of Vanes (vertical).....m.

Height of Cairn.....m. Diameter of Cairn.....m. Name Plate found/not found/placed.

Length of Mast.....m. (approximate if not unpiled)


4. A.....set in conc./rock has been placed/found, bearing.....° M from Mast/Plug/Pillar

5. A.....set in conc./rock has been placed/found, bearing.....° M from Mast/Plug/Pillar

6. A.....set in conc./rock has been placed/found, bearing.....° M from Mast/Plug/Pillar

7. A.....set in conc./rock has been placed/found, bearing.....° M from Mast/Plug/Pillar

8. Action required:.....

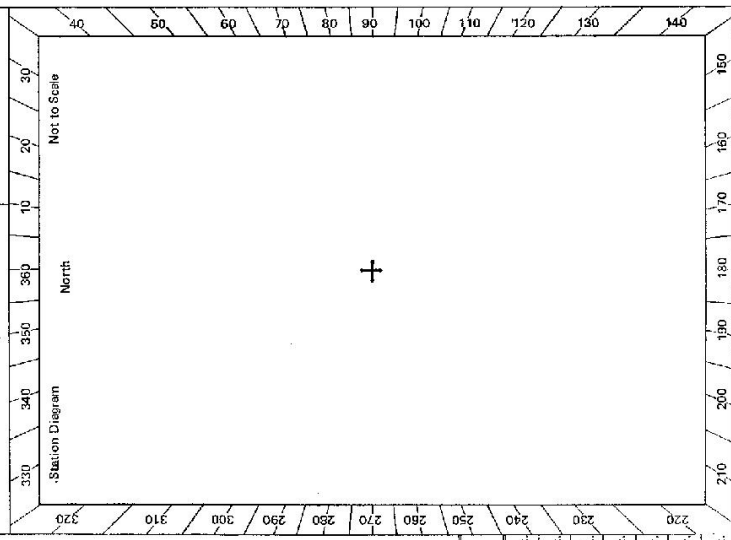

STANDPOINT:			
Mark	Direction	Horiz. Distance	Height Difference
			above standpt. below standpt.
			above standpt. below standpt.
Prepared by: *G. Hanna* 11/4/79  
 Checked: *[Signature]*  
 Noted on U.T.M. Card

**STATION GILLMATONG TS-7081**

Owner's Name: .....  
 Address: .....  
 Phone: .....

Current Occupant: .....  
 Address: .....  
 Phone: .....

ACCESS  
 Access Report of 24/1/1974, was found suitable/unsuitable.

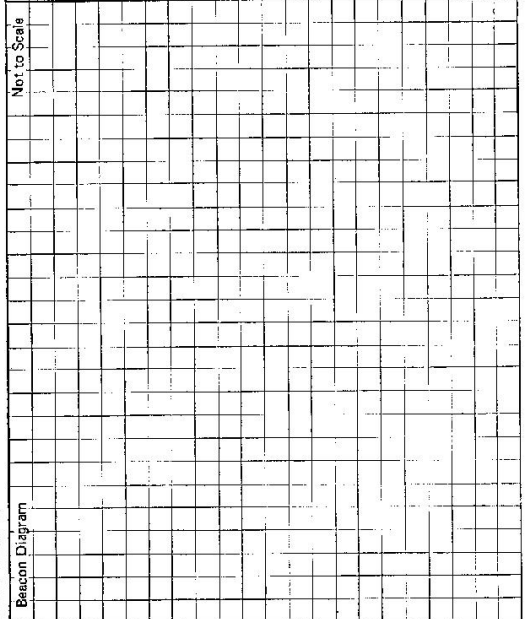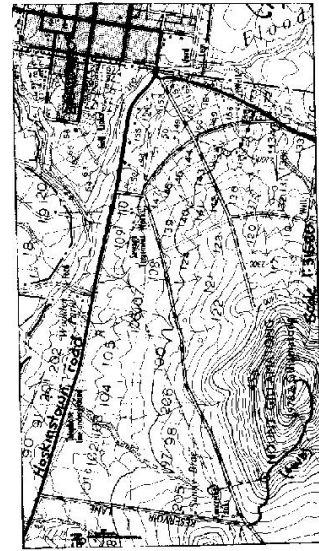

This section to be completed by officer constructing pillar.

Original station mark found/not found.

Description of mark: .....

Original beacon found/not found.

Description of beacon: .....

Height Top of Vane to Top Mark .....m.

Height of mark .....m above below rock/contc .....m above G.L. below

Diameter of Vane .....m.

Height of Cairn .....m.

Original Beacon has/has not been destroyed by me.

Date	Record of Station

CENTRAL MAPPING AUTHORITY

GEODETIC SURVEY OF NSW

GEODETIC STATION RECONNAISSANCE and MAINTENANCE REPORT

Description:

Note: Cross out word or words which do not apply

1. Cleared by lances bearing 95°... 106°... 112°... 138°... 165°... 2188 m... from Trig. Mast 274 m x 274 m

2. Mast & Vanes have been painted white & black respectively.

3. The station/pillar was unpiled/not unpiled/conserved on... 19.82... dimensions now being:

Description of mark... should be explicit: e.g. S/Steel Pillar Plate/Steel plug, Brass plug, Bolt, G.I. Pipe

Height of mark... m. above rock/concrete; Mark is... m. above G.L.

Height of Top Vanes to Top Mark/Pillar plate... m. Diameter of Vanes (vertical).....m.

Height of Cairn.....m. Diameter of Cairn.....m. Name Plate found/not found/placed.

Length of Mast.....m. (approximate if not printed)

4. A. (S.M.)..... set in conc/rock has been placed/found, bearing..... 170° M from Mast/Plug/Pillar

5. A..... set in conc/rock has been placed/found, bearing..... M from Mast/Plug/Pillar

6. A..... set in conc/rock has been placed/found, bearing..... M from Mast/Plug/Pillar

7. A..... set in conc/rock has been placed/found, bearing..... M from Mast/Plug/Pillar

8. Action required: Construct pillar... Clearing per instruction.....

STANDPOINT:

Mark	Direction	Horiz. Distance	Height Difference	Mark	Direction	Horiz. Distance	Height Difference
			above standpt				above standpt
			below				below
			above standpt				above standpt
			below				below
Prepared by: V. H. H. H.

Noted on U.T.M. Card

SR 2733-1

Checked

TS-7081  
STATION: GILLAMATONLE  
MAP SHEET SCALE 1:250 000  
INSPECTED BY: K. HADDOU  
AUTHORITY: C.M.A.  
No: 2143  
DATE: 16-11-82  
FIELD BOOK: C 246

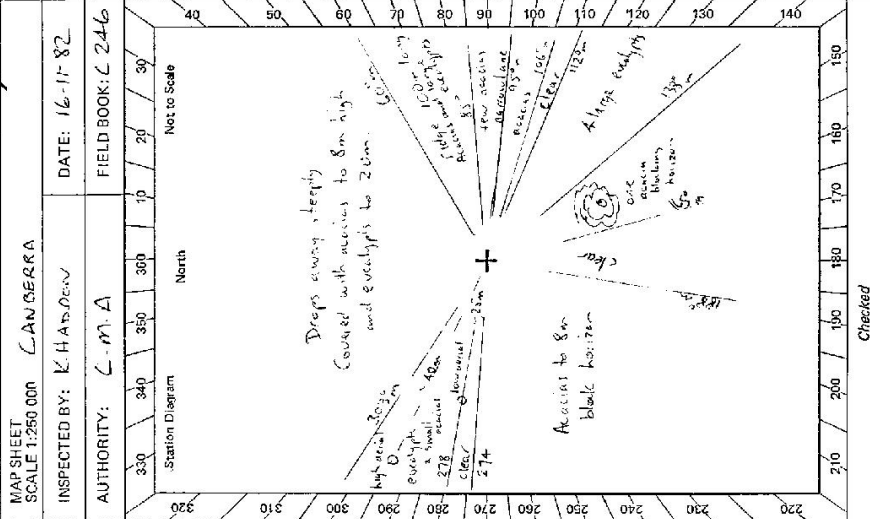

St.2739-2 D. West, Government Printer

Beacon Diagram	Not to Scale

STATION GRILLAMATONG TS-7081  
 Owner's Name: TRIG RESERVE (28486)  
 Address: CL Farmers Grazos  
 Phone: 84828282

**ACCESS**

Access Report of 16/11/1982 was found suitable/unavailable.

\* KEY REQUIRED

- 00 Braidwood PO. Head south
- \* 02 Obtain key at Farmers Grazos on left
- 04S Straight ahead
- 07 Turn right
- 09S Cross bridge
- 1-0 Straight ahead towards "Farrington"
- 4-0 Turn left into Reserve Lane
- 54 At T-Junction, go straight ahead through locked gate. Follow track.
- 65 At trig.

This section to be completed by officer constructing pillar.

Original station mark found/not found.

Description of mark: .....

Original beacon found/not found.

Description of beacon: .....

Height Top of Vanes to Top Mark.....m.

Height of mark.....m. above G.L. below

Diameter of Vanes .....m. Height of Galn .....m.

Original Beacon has/has not been destroyed by me.

Date	Record of Station

7081

CENTRAL MAPPING AUTHORITY

GEODETTIC SURVEY OF N.S.W.  
GEODETTIC STATION RECONNAISSANCE and MAINTENANCE REPORT

Description:

1. Cleared by lances bearing  $135^\circ$ ,  $205^\circ$ ,  $325^\circ$ ,  $355^\circ$ ,  $325^\circ$ ,  $205^\circ$  from Trig. Mast  $88^\circ$  to  $88^\circ$ .

2. Mast & Vanes have been painted white & black respectively.

3. This station, ~~was~~ was unplied/ ~~was~~ was unplied/ ~~was~~ was unplied on  $19/08/20$ , dimensions now being:

Description of mark ~~Steel Pipe~~ should be explicit, e.g., S/Steel Pillar Plate, Steel plug, Brass plug, Bolt, G.I. Pipe

Height of mark  $0.040$  m. <sup>above</sup> rock/ ~~concrete~~; Mark is  $19.2$  m. <sup>above</sup> G.L.

Height of Top Vanes to Top Mark/ ~~concrete~~  $3.576$  m. Diameter of Vanes (vertical)  $16.6$  m.

Height of Cairn  $1.000$  m. Diameter of Cairn  $0.000$  m. Name Plate found/not found/placed.

Length of Mast  $3.076$  m. (approximate if not unplied)

4. A.  $S.S.M$  set in conc/ ~~rock~~ has been placed/ ~~found~~, bearing  $160^\circ$  M from ~~Mast/Plug/Pillar~~

5. A. ~~Bolt~~ set in conc/rock has been placed/ ~~found~~, bearing  $302^\circ$  M from ~~Mast/Plug/Pillar~~


6. A. ~~G.I. Pipe~~ set in conc/rock has been placed/ ~~found~~, bearing  $354^\circ$  M from ~~Mast/Plug/Pillar~~

7. A. set in conc/rock has been placed/ ~~found~~, bearing  $000^\circ$  M from Mast/Plug/Pillar

8. Action required: ~~None~~

Mark	Direction	Horiz. Distance	Height Difference	Mark	Direction	Horiz. Distance	Height Difference
M20 (P)	0 00 00		above standpt.	M20 (P)	0 00 00		above standpt.
S.S.M	02 25 00	2.491	above standpt.	Bolt	16 08 30	7.161	above standpt.
Bolt	43 29 20	5.451	above standpt.	Brass Trig. Lac. in Rock (B)	01 26 30	2.497	above standpt.
G.I. Pipe	21 50 46	7.529	above standpt.	G.I. Pipe	09 15 00	9.993	above standpt.
Reconnaissance Tower	03 51 26		above standpt.	Reconnaissance Tower	03 51 00		above standpt.

STANDPOINT: ~~None~~  $S.S.M$   $R.I.C$   $R.I.C$   $R.I.C$   $R.I.C$   
 Prepared by: ~~P.H.T.S~~  $6/10/23$   $6/10/23$   $6/10/23$   $6/10/23$   $6/10/23$   
 Checked: ~~None~~  $6/10/23$   $6/10/23$   $6/10/23$   $6/10/23$   $6/10/23$   
 Noted on U.T.M. Card  $6/10/23$

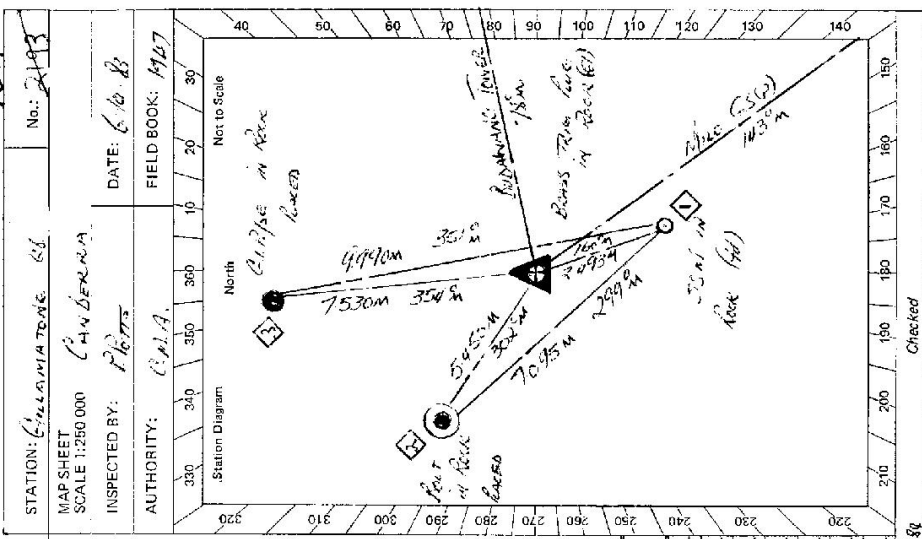

STATION: ~~WILLAMIA TRIG.~~  $6/10/23$   
 MAP SHEET SCALE 1:250 000  $6/10/23$   
 INSPECTED BY: ~~P.H.T.S~~  $6/10/23$   
 AUTHORITY: ~~C.M.A.~~  $6/10/23$   
 DATE:  $6/10/23$   
 FIELD BOOK:  $1917$


Checked

STATION Collamaton E 68 TS-7081

ADJACENT OWNER MR N NUTFIELD  
 Current Occupant: CHARTERS GEORGES  
 Address: 288 RD  
 Phone: 0845 13 1000

Owner's Name: TRIG ABEYSENE  
 Address: 288 RD  
 Phone:

ACCESS  
 Access Report of 6/10/1982 was found suitable/unsuitable.

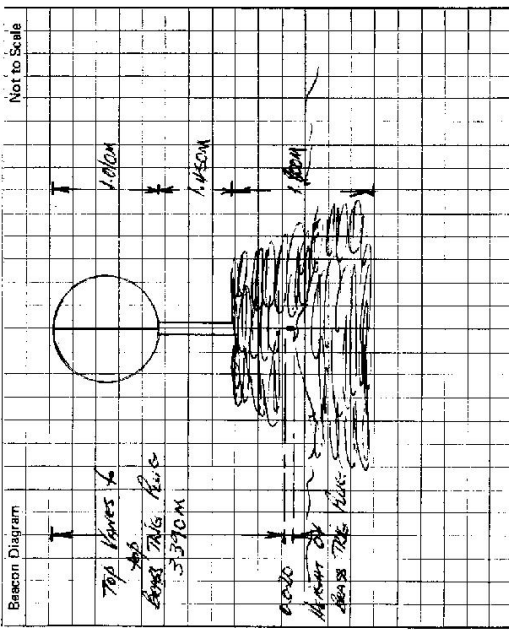


This section to be completed by officer constructing pillar.

Original station mark found/not found.  
 Description of mark: .....  
 Original beacon found/not found.  
 Description of beacon: .....  
 Height Top of Vanes to Top Mark ..... m.  
 Height of mark ..... m. above G.L. below  
 Diameter of Vanes ..... m. Height of Cairn ..... m.  
 Original Beacon has/has not been destroyed by me.

Date	Record of Station

CENTRAL MAPPING AUTHORITY  
 GEODETIC SURVEY OF N.S.W.  
 GEODETIC STATION RECONNAISSANCE and MAINTENANCE REPORT  
 STATION: *Campberridge (S.I.C)* No: *7081*  
 MAP SHEET SCALE 1:250 000  
 INSPECTED BY: *P.H.M.S* DATE: *7/6/83*  
 AUTHORITY: *C.M.A.* FIELD BOOK: *1917*

Description:  
 Note: *Cross out word or words which do not apply*  
 1. Cleared by lanes bearing *60° 00' 00"* *303° 36' 55"* *355° 00' 00"* *355° 00' 00"* *355° 00' 00"* from Trig. Mast  
 2. Mast & Vanes have been painted white & black respectively *80m to 88m*  
 3. The *steel* pillar was *replaced/reconstructed*/constructed on *19/83*, dimensions now being:  
 Description of mark *Steel Pillar Plate, Steel plug, Brass plug, Bolt, G.I. Pipe*  
 Height of mark *1.570* m. above *concrete*/concrete; Mark is *1.570* m. above *concrete*  
 Height of Top Vanes to Top Mast/Pillar plate *1.410* m. Diameter of Vanes (vertical) *0.750* m.  
 Height of Cairn *1.410* m. Diameter of Cairn *0.750* m. Name Plate *removed*/ *removed* placed.  
 Length of Mast *55.11* m. (approximate if not unplied)  
 4. A. *55.11* set in *concrete*/rock has been *planned*/found, bearing *60° 00' 00"* M from *North*/Mast/Pillar  
 5. A. *Bolt* set in *concrete*/rock has been *planned*/found, bearing *303° 36' 55"* M from *North*/Mast/Pillar  
 6. A. *G.I. Pipe* set in *concrete*/rock has been *planned*/found, bearing *355° 00' 00"* M from *North*/Mast/Pillar  
 7. A. *concrete* set in *concrete*/rock has been placed/found, bearing *355° 00' 00"* M from Mast/Pillar  
 8. Action required: *concrete*

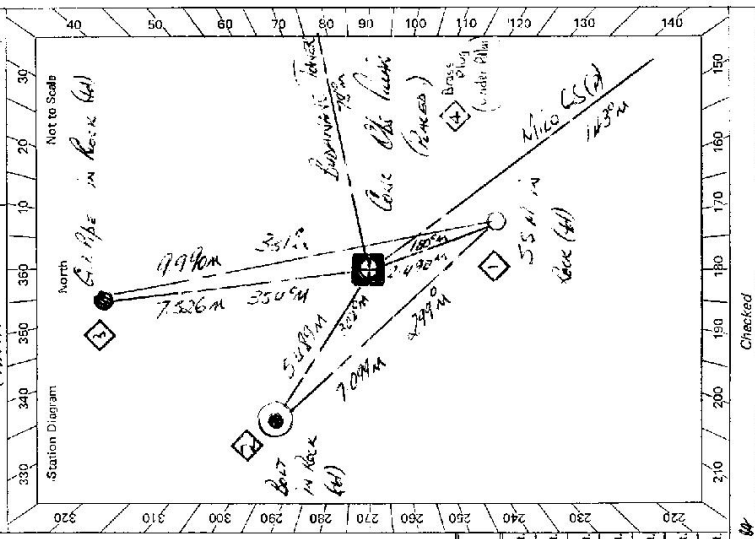

STANDPOINT: *Conc Obs Cairn*      STANDPOINT: *55.11*

Mark	Direction	Horiz. Distance	Height Difference	Mark	Direction	Horiz. Distance	Height Difference
<i>Misc (H)</i>	<i>0 00 00</i>		<i>above</i> <i>standpt</i>	<i>Misc (H)</i>	<i>0 00 00</i>		<i>above</i> <i>standpt</i>
<i>55.11</i>	<i>02 05 50</i>	<i>2.087</i>	<i>above</i> <i>standpt</i>	<i>Bolt</i>	<i>40 08 40</i>	<i>7.097</i>	<i>above</i> <i>standpt</i>
<i>Bolt</i>	<i>143 16 30</i>	<i>5.086</i>	<i>above</i> <i>standpt</i>	<i>Conc Obs Cairn</i>	<i>02 08 30</i>	<i>12.491</i>	<i>above</i> <i>standpt</i>
<i>G.I. Pipe</i>	<i>021 30 30</i>	<i>7.503</i>	<i>above</i> <i>standpt</i>	<i>G.I. Pipe</i>	<i>09 15 30</i>	<i>19.992</i>	<i>above</i> <i>standpt</i>
<i>BRASS PLUG</i>	<i>033 51 30</i>		<i>above</i> <i>standpt</i>	<i>BRASS PLUG</i>	<i>303 51 00</i>		<i>above</i> <i>standpt</i>
			<i>below</i> <i>standpt</i>				<i>below</i> <i>standpt</i>
			<i>below</i> <i>standpt</i>				<i>below</i> <i>standpt</i>

Prepared by: *P.H.M.S* 10/10/83.      Checked: *P.H.M.S* 23/11/83  
 Noted on U.I.M. Card 23/11/83

Station Diagram  
 Not to Scale  
 320 310 300 290 280 270 260 250 240 230 220  
 330 340 350 360 370 380 390 400  
 40 50 60 70 80 90 100 110 120 130 140  
 150 160 170 180 190  
 Checked

STATION QUADRANTONG C.S. 01 IS 7081


ADJUTANT MA. N. WHITFIELD  
 Current Occupant: MA. N. WHITFIELD  
 Address: CH. FARMERS QUARTERS  
MAN/STATION

Owner's Name: TRIG RESERVE  
 Address: 280 86  
 Phone: 440 0111

Phone: 440 0111  
 Address: 440 0111

\* PLEASE NOTE KEY REQUIRED  
 Access Report of 1.1.10/1983 was found suitable/unsuitable.

- K.M. FEATURE
- 0.00 POST OFFICE QUADRANTONG ROAD SOUTH
  - \* 0.30 OBTAIN KEY FROM MR WHITFIELD AT FARMERS QUARTERS BUILDING
  - 0.45 SIGNPOST DIVERS THROUGH CAVE MAY SIGN
  - 0.70 TURN RIGHT TOWARDS MOUNTAIN & MAJORS CREEK
  - 0.95 CROSS BRIDGE
  - 1.00 TURN RIGHT TOWARDS 'FARMINGTON' ALONG SANDY ROAD
  - 1.00 TURN LEFT ON RESERVE WAY
  - 4.00 AT T. INTERSECTION GO STRAIGHT AHEAD THROUGH
  - 5.40 LOCKED GATE - THEN FOLLOW TRACK TO TRIG
  - 6.50 GEOMETRIC STATION QUADRANTONG
- \* A KEY IS ALSO AVAILABLE FROM LOCAL COUNCIL

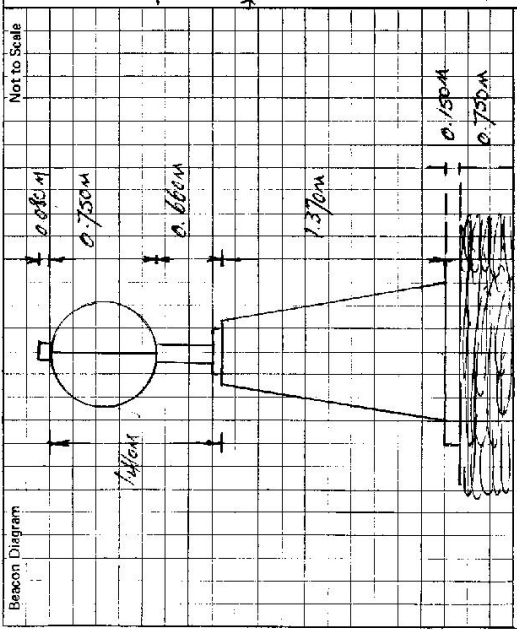

This section to be completed by officer constructing pillar.

Original station mark found/not found.  
 Description of mark: Beacon Trig. Pillar  
 Original beacon found/not found.  
 Description of beacon: Plain Pillar & Disc  
 Height Top of Varies to Top Mark 3.380 m.  
 Height of mark 0.22 m. above G.L. / below rock/cont. m. below  
 Diameter of Varies 10.0 m. Height of Cairn 1.80 m.  
 Original Beacon has/~~has~~ been destroyed by me.

Date	Record of Station