

TS 7082

GEODETTIC SURVEY OF N.S.W.

CENTRAL MAPPING AUTHORITY

GEODETTIC STATION RECONNAISSANCE and MAINTENANCE REPORT

STATION: **NARRANGHI**

No.: **3835**

MAP SHEET
SCALE 1:250 000

CANBERRA

INSPECTED BY: **G. C. HANNA**

DATE: **3/4/79**

AUTHORITY: **C.M.A.**

FIELD BOOK:

Description:
1. Cleared by lanes bearing.....
Note: Cross out word or words which do not apply

2. Mast & Vanes have been painted white & black respectively.
3. The station/pillar was unpiled/not unpiled/constructed on.....
Description of mark.....
Height of mark.....m. ^{above} _{below} rock/concrete; Mark is.....m. ^{above} _{below} G.L.

Height of Top Vanes to Top Mark/Pillar plate.....m. Diameter of Vangs(vertical).....m.
Height of Cairn.....m. Diameter of Cairn.....m. Name Plate found/not found/placed.

Length of Mast.....m. (approximate if not unpiled)

4. A.....set in conc/rock has been placed/found, bearing.....°M from Mast/Plug/Pillar

5. A.....set in conc/rock has been placed/found, bearing.....°M from Mast/Plug/Pillar

6. A.....set in conc/rock has been placed/found, bearing.....°M from Mast/Plug/Pillar

7. A.....set in conc/rock has been placed/found, bearing.....°M from Mast/Plug/Pillar

8. Action required:.....


STANDPOINT:			
Mark	Direction	Horiz. Distance	Height Difference
			above standpt.
			below
			above standpt.
			below
Prepared by: *G. Hanna* 11/4/79

Checked

Noted on U.T.M. Card

St 2738-1

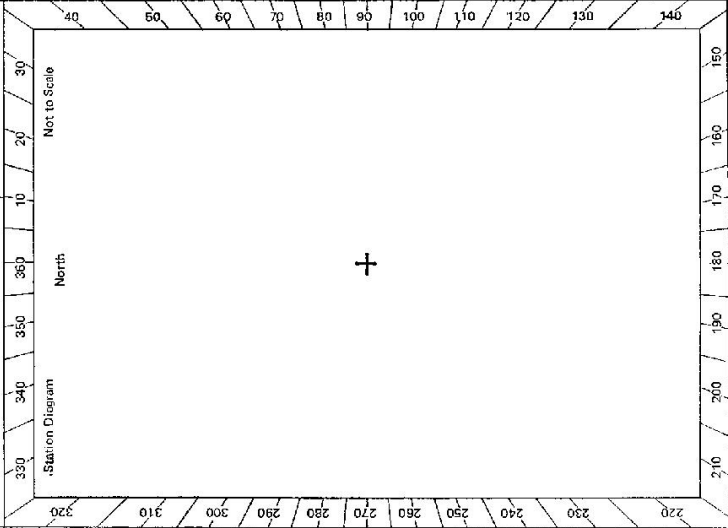


TS 7082
No.: 3339

STATION: NARRANGETTI
MAP SHEET SCALE 1:250 000 CANBE62A
INSPECTED BY: K. HADDOON DATE: 17-11-82
AUTHORITY: C.M.A. FIELD BOOK: C 246

CENTRAL MAPPING AUTHORITY
GEODETTIC SURVEY OF NSW.
GEODETTIC STATION RECONNAISSANCE and MAINTENANCE REPORT

- Description: Note: Cross out word or words which do not apply
1. Cleared by lanes bearing..... Nil..... from Trig. Mast
 2. Mast & Vanes have been painted white & black respectively.
 3. The station/pillar was unspiled/not unspiled/erected on..... 17-11-82..... dimensions now being: Description of mark..... should be explicit e.g. ~~Steel Pillar Plate, Steel plug, Brass Plug, Bolt, G.I. Pipe~~
Height of mark..... m. above rock/concrete; Mark is..... m. above G.L.
Height of Top Vanes to Top Mark/Pillar plate..... m. Diameter of Vanes (vertical)..... m.
Height of Cairn..... m. Diameter of Cairn..... m. Name Plate found/not found/placed.
Length of Mast..... m. (approximate if not unspiled)
 4. A..... set in conc/rock has been placed/found, bearing..... °M from Mast/Plug/Pillar
 5. A..... set in conc/rock has been placed/found, bearing..... °M from Mast/Plug/Pillar
 6. A..... set in conc/rock has been placed/found, bearing..... °M from Mast/Plug/Pillar
 7. A..... set in conc/rock has been placed/found, bearing..... °M from Mast/Plug/Pillar
 8. Action required: ~~Construct Pillar~~..... Clearing..... per instruction. Make back to top of hill.....

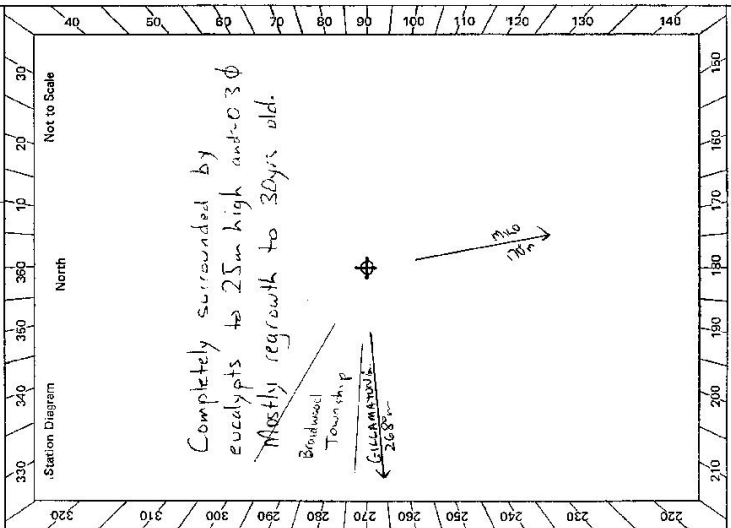

STANDPOINT:

Mark	Direction	Horiz. Distance	Height Difference	Direction	Horiz. Distance	Height Difference
			above standpt.			above standpt.
			below			below
			above standpt.			above standpt.
			below			below
Prepared by: K. HADDOON
Checked: [Signature]
Noted on U.T.M. Card

St 2733 – 2 D. West, Government Printer	STATION <u>NARRANGI</u> TS 7082	Future Lessee Current Occupant <u>R. Slattery</u> Address: <u>130 Terminus Ave</u> <u>Eastwood NSW 2206</u> Phone:	Owner's Name: <u>TRIG RESERVE (15376)</u> Address: Phone: ACCESS Access Report of <u>17/11/1982</u> was found suitable/unsuitable. 00 Braidwood PO. Head South. 045 Turn left towards Babensons Bay 87 Turn left into Narrangki Rd 93 Gate 103 Turn right onto track (104 Pass track to house on right) 109 Turn off track to right. Head up hill 110 End of progress. 200m to trig on top of hill
Beacon Diagram Not to Scale	This section to be completed by officer constructing pillar. Original station mark found/not found. Description of mark: Original beacon found/not found. Description of beacon: Height: Top of Vanes to Top Mark m. Height of mark m. above G.L. below Diameter of Vanes m. Height of Cairn m. Original Beacon has/has not been destroyed by me.		
		Date	Record of Station

CENTRAL MAPPING AUTHORITY

GEODETIC STATION RECONNAISSANCE and MAINTENANCE REPORT

Description:

1. Cleared by lanes bearing 235.0° to 270.0° ; 150.0° to 177.0° from Trig. Mast

2. Mast & Vanes have been painted white & black respectively.

3. The ~~station~~ pillar was ~~erected~~ constructed on ~~17th October~~ 19 ~~83~~ dimensions now being:
 Description of mark: ~~3/8" brass cone~~ should be explicit, e.g., S/Steel Pillar Plate, Steel plug, Brass plug, Bolt, G.I. Pipe

Height of mark: 1.370 m. ^{above} ~~below~~ G.L. Mark is 1.500 m. ^{above} ~~below~~ G.L.

Height of Top Vanes to Top ~~mark~~ Pillar plate 1.425 m. Diameter of Vanes (vertical) 0.750 m.

Height of Cairn.....m. Diameter of Cairn.....m. Name Plate ~~erected~~ ~~erected~~ /placed.

Length of Mast.....m. (approximate if not unplied)

4. A ~~Brass Trig. Peg~~ set in ~~conc/rock~~ has been ~~placed~~ /found, bearing 340° M from ~~Mast~~ /Mast/Pillar

5. A ~~G.I. Pipe~~ set in ~~conc/rock~~ has been placed /found, bearing 230° M from ~~Mast~~ /Mast/Pillar

6. A..... set in ~~conc/rock~~ has been placed /found, bearing..... M from Mast/Plug/Pillar

7. A..... set in ~~conc/rock~~ has been placed /found, bearing..... M from Mast/Plug/Pillar

8. Action required:.....

STANDPOINT: ~~Conc. Obs. Pillar~~ ~~Brass Trig. Peg~~


Mark	Direction	Horiz. Distance	Height Difference	Mark	Direction	Horiz. Distance	Height Difference
BRASS TRIG. PEG	0° to 00°		above standpt.	BRASS TRIG. PEG	0° to 00°		above standpt.
CONC. OBS. PILLAR	230° to 19° to 46°	2.206	above standpt.	CONC. OBS. PILLAR	12° to 27° to 40° to 48°	48.0	above standpt.
G.I. PIPE	340° to 20° to 20°	3.517	above standpt.	G.I. PIPE	50° to 22° to 40° to 230°	1.516	above standpt.
			below				below
			above standpt.				above standpt.
			below				below
			above standpt.				above standpt.
			below				below

Prepared by: ~~P. P. P.~~ $62.10.83$ Checked: ~~K. A. P.~~ $19.11.82$

Noted on U.T.M. Card $KA 23/100$

Checked

STATION: ~~MARAKASHI, G.I. (P)~~ No: ~~71082~~
 MAP SHEET SCALE 1:250 000 ~~CANLERA~~
 INSPECTED BY: ~~P. P. P.~~ DATE: ~~8.6.83~~
 AUTHORITY: ~~C.M.A.~~ FIELD BOOK: ~~1967~~

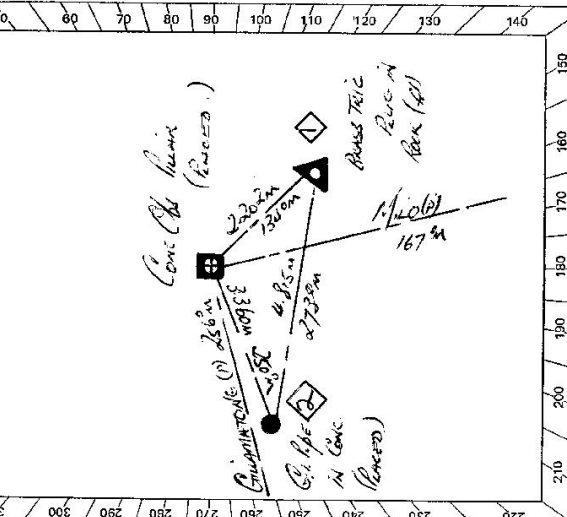

Not to Scale

Checked

Sr 2735-2 D. West, Government Printer

<p>STATION <u>MARQUANBY BS(1)</u> IS <u>7082</u></p>	<p>Owner's Name: <u>TRIC RESERVE</u> Address: <u>15376</u> Phone:</p>	<p>Current Occupant: <u>MR R SLATTERY</u> Address: <u>30 BERNARDI AVE</u> Phone: <u>03 755708</u></p>	<p>ACCESS</p> <p>Access Report of 8.10/1983 was found suitable/unavailable.</p> <p>FEATURE</p> <p>0.00 ROAD OFFICE BRANDON'S HEAD SOUTH TOWERS BARNHANS DAY 0.40 TURN LEFT AT CURVE WAY SIGN BARNHANS DAY - MOBYA. 0.65 TURN LEFT ONB APPROACHED ROAD 1.25 WADY GATE 16.20 TURN RIGHT OFF CRANIEL ROAD TOWERS NEW HOUSE 0.25 TAKE LEFT TRACK - TRACK TO RIGHT GOES X MR SLATTERY'S NEW HOUSE TURN RIGHT AT FOLLEN TRACK TURN RIGHT ONB TRACK A KNOCK UP RIDGE & TRG MARQUANBY BS(1)</p>
<p>Beacon Diagram</p>		<p>This section to be completed by officer constructing pillar.</p> <p>Original station mark found/not found.</p> <p>Description of mark: <u>BRASS TIG PILE</u></p> <p>Original beacon found/not found.</p> <p>Description of beacon: <u>CORR BE & DISC</u></p> <p>Height Top of Vanes to Top Mark <u>5.325</u> m.</p> <p>Height of mark <u>0.25</u> m. above G.L. above G.L. below G.L.</p> <p>Diameter of Vanes <u>0.365</u> m. Height of Cairn <u>1.360</u> m.</p> <p>Original Beacon has not been destroyed by me.</p>	
<p>Date</p>		<p>Record of Station</p>	