

CENTRAL MAPPING AUTHORITY

GEODETIC SURVEY OF N.S.W.

Canranumbold

GEODETIC STATION RECONNAISSANCE and MAINTENANCE REPORT


STATION: **CANRANUMBOLD** No: **7091**
1387

MAP SHEET SCALE 1:250 000 **GOULBURN**
 INSPECTED BY: **K. HASSON** DATE: **20-9-83**

AUTHORITY: **CMA** FIELD BOOK: **C 300**

Description: *Note: Cross out word or words which do not apply*

- Cleared by lanes bearing..... from Trig. Mast
- Mast & Vanes have been painted white & black respectively.
- The station/pillar was unpiled/not unpiled/constructed on..... 19....., dimensions now being:
 Description of mark..... should be explicit, e.g., S/Steel Pillar Plate, Steel plug, Brass plug, Bolt, G.I. Pipe
 Height of mark.....^{above} rock/concrete; Mark is.....^{above} m. ^{below} G.L.
 Height of Top Vanes to Top Mark/Pillar plate..... m. Diameter of Vanes (vertical)..... m.
 Height of Cairn..... m. Diameter of Cairn..... m. Name Plate found/not found/placed.
 Length of Mast..... m. (approximate if not unpiled)
- A..... set in conc/rock has been placed/found, bearing.....° M from Mast/Plug/Pillar
- A..... set in conc/rock has been placed/found, bearing.....° M from Mast/Plug/Pillar
- A..... set in conc/rock has been placed/found, bearing.....° M from Mast/Plug/Pillar
- A..... set in conc/rock has been placed/found, bearing.....° M from Mast/Plug/Pillar
- Action required: **Construction of pillar 15.5 metres high from existing concrete pile. Clear dead trees in sector 170° to 175° and to Geographical.**

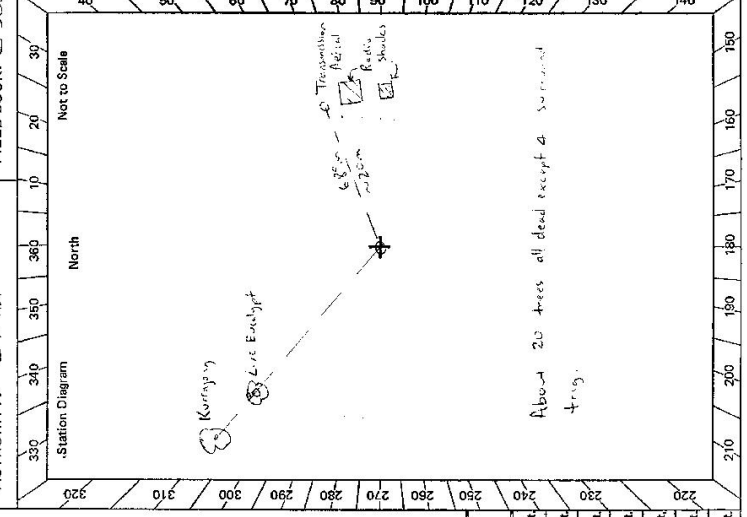

Mark	Direction	Horiz. Distance	Height Difference	Mark	Direction	Horiz. Distance	Height Difference
			above standpt.				above standpt.
			below standpt.				below standpt.
			above standpt.				above standpt.
			below standpt.				below standpt.
STANDPOINT: **Construction of pillar 15.5 metres high from existing concrete pile. Clear dead trees in sector 170° to 175° and to Geographical.**

Prepared by: **K. J. HASSON** Checked: **17.4.84** Noted on U.T.M. Card **17.4.84** Checked

Carrara symbols

STATION: **CANEMUNDOLA GS (P)** No: **7091**

MAP SHEET SCALE 1:250 000 **GEOL BOUND**

INSPECTED BY: **L. HITCHINS** DATE: **14-12-83**

AUTHORITY: **C.M.A.** FIELD BOOK: **01937**

CENTRAL MAPPING AUTHORITY GEODETTIC SURVEY OF N.S.W. GEODETTIC STATION RECONNAISSANCE and MAINTENANCE REPORT

Description: *Note: Cross out word or words which do not apply*

- Cleared by lanes bearing **260°** ~~Set~~ **Set** ~~to~~ **to** ~~the~~ **the** ~~lines~~ **lines** ~~from Trig. Mast~~
- Mast & Vanes have been painted white & black respectively. ✓
- The station/pillar was ~~unpiled~~ ~~not unpiled~~ /constructed on **1.3 ft. Dec.** ~~19.83~~ **19.83**, dimensions now being:
 - Description of mark **1.3 ft. Dec.** ~~19.83~~ **19.83** should be explicit, e.g., S/Steel Pillar Plate, Steel plug, Brass plug, Bolt, G.I. Pipe
 - Height of mark **1.390** ~~m.~~ **m.** ~~above~~ ~~below~~ **above** **1.540** ~~m.~~ **m.** ~~above~~ ~~below~~ **above** **G.L.** ✓
 - Height of Top Vanes to Top ~~Mast~~ ~~Pillar plate~~ **1.418** ~~m.~~ **m.** ✓ Diameter of Vanes (vertical) **0.750** ~~m.~~ **m.**
 - Height of Cairn ~~m.~~ **m.** Diameter of Cairn ~~m.~~ **m.** Name Plate ~~found~~ ~~not found~~ /placed.
 - Length of Mast ~~m.~~ **m.** (approximate if not unpiled)
- A. BRASS. Min. Pillar** ~~set in conc/teek~~ ~~has been placed~~ /found, bearing **50°** ~~M~~ **M** from ~~Mast/Plug/Pillar~~ ✓
- A. C.I. PIPE** ~~set in conc/teek~~ ~~has been placed~~ /found, bearing **183°** ~~M~~ **M** from ~~Mast/Plug/Pillar~~ ✓
- A.** ~~set in conc/rock~~ ~~has been placed~~ /found, bearing ~~°~~ **°** ~~M~~ **M** from ~~Mast/Plug/Pillar~~
- A.** ~~set in conc/rock~~ ~~has been placed~~ /found, bearing ~~°~~ **°** ~~M~~ **M** from ~~Mast/Plug/Pillar~~
- Action required: ~~.....~~

STANDPOINT: S/S PILLAR PILE			STANDPOINT: BRASS TRIC. PILLAR				
Mark	Direction	Horiz. Distance	Height Difference	Mark	Direction	Horiz. Distance	Height Difference
			above standpt.				above standpt.
			below standpt.				below standpt.
GEEGULLALONG GS (P)	0 60 00		above standpt.	GEEGULLALONG GS (P)	0 60 00		above standpt.
BRASS PILE	32 23 10	15 347	above standpt.	BUFFALO GS (P)	169 25 00		above standpt.
BUFFALO GS (P)	169 20 40		below standpt.	PILLAR PLATE	212 26 35	15 250	below standpt.
C.I. PIPE	213 50 50	3 412	below standpt.	G.I. PIPE	212 41 10	18 157	above standpt.
			above standpt.				below standpt.
			below standpt.				above standpt.
			above standpt.				below standpt.
			below standpt.				above standpt.

Prepared by: *[Signature]* Checked: *[Signature]* Noted on U.T.M. Card **14-28-1984**

Checked

STATION **CANEMUMBOLA GS (P) B 7091**

Owner's Name: **VICENT CUMMINGS**


Lessee **CANEMUMBOLA GS (P) B 7091**

Current Occupant: **K J HINDS**
 Address: **FELKINGDALE ROAD**
 Phone: **853238**

Address: **.....**
 Phone: **.....**

ACCESS

Access Report of 10/9/1983 was found suitable/unavailable
 0.0 BOORLOWA RD HEAD NORTH TOWARDS COWDA
 0.2 TURN RIGHT TOWARDS CROOKWELL
 0.65 TURN LEFT
 0.9 TURN RIGHT
 1.8 TURN LEFT TOWARDS CROOKWELL
 2.9 CROSS BOORLOWA RIVER
 3.0 TAKE LEFT FORK
 3.45 TURN RIGHT OFF BITUMEN GO THROUGH GATE
 FOLLOW TRACK EASTWOOD ALONG FENCE + PAST RIFLE
 RANGE MOUNDS
 4.25 TURN LEFT + GO THROUGH GATE (LMA LOCK) + FOLLOW TRACK
 5.2 GS

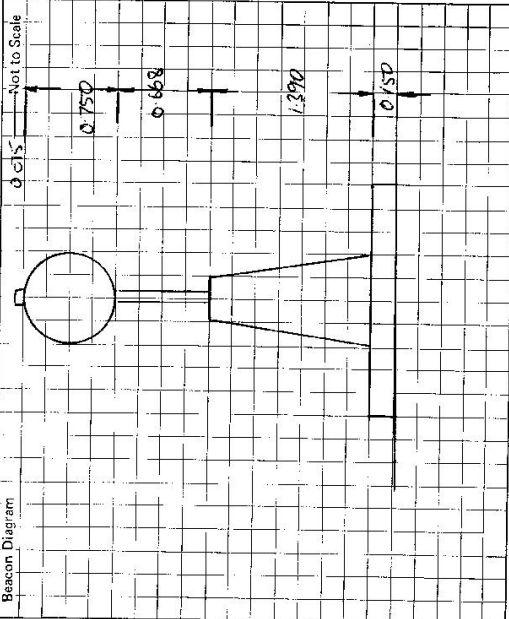

This section to be completed by officer constructing pillar.

Original station mark found/~~not found~~.
 Description of mark: **BASS TRIG. P. IN. CONE**
 Original beacon found/~~not found~~.
 Description of beacon: **CALDA P. IN. DISC.**
 Height Top of Vanes to Top Mark: **3.425** m. above G.L.
 Height of mark: **0.630** m. above G.L. below G.L.
 Diameter of Vanes: **0.440** m. Height of Calm **1.000** m.
 Original Beacon has ~~been~~ been destroyed by me.

Date	Record of Station

CARRON M.C. A.


GEODETTIC SURVEY OF N.S.W.

CENTRAL MAPPING AUTHORITY

GEODETTIC STATION RECONNAISSANCE and MAINTENANCE REPORT

STATION: CANEMUMBOLA No.: 7091
 MAP SHEETS SCALE 1:100 000
 SCALE 1:250 000 GOULBURN
 INSPECTED BY: K HADDOON
 DATE: 9-2-84
 AUTHORITY: C.M.A.
 FIELD BOOK: C 300
 R 272

Description:
 1. Cleared by lanes bearing.....
 Note: Cross out word or words which do not apply
 from Trig. Mast
 2. Mast & Vanes have been painted white & black respectively.
 3. The station/pillar was unpiled/not unpiled/constructed on..... 19....., dimensions now being:
 Description of mark..... should be explicit, e.g., S/Steel Pillar Plate, Steel plug, Brass plug, Bolt, G.I. Pipe
 Height of mark.....m. above rock/concrete; Mark is.....m. above G.L.
 Height of Top Vanes to Top Mark/Pillar plate.....m. Diameter of Vanes (vertical).....m.
 Height of Cairn.....m. Diameter of Cairn.....m. Name Plate found/not found/placed.
 Length of Mast.....m. (approximate if not unpiled)
 4. A..... Drill hole..... set in conc/rock has been placed/missing, bearing.....°M from Mast/Plug/Pillar
 5. A..... set in conc/rock has been placed/missing, bearing.....°M from Mast/Plug/Pillar
 6. A..... set in conc/rock has been placed/missing, bearing.....°M from Mast/Plug/Pillar
 7. A..... set in conc/rock has been placed/missing, bearing.....°M from Mast/Plug/Pillar
 8. Action required:.....

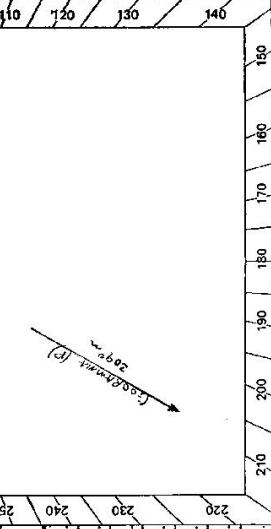

Mark	Direction	Horiz. Distance	Height Difference	Mark	Direction	Horiz. Distance	Height Difference
GOORAMMA (P)	0°00'00.0"		above standpt.	GOORAMMA (P)	0°00'00.0"		above standpt.
Drill hole in rock	85°41'50.8"	34.051	above standpt.	GREEGULL ALONGS (P)	120°59'16.9"		above standpt.
GREEGULL ALONGS (P)	120°44'55.0"		above standpt.	Pillar & plug	265°50'47.2"	34.051	2.705
			above standpt.				above standpt.
			below				below
			above standpt.				above standpt.
			below				below
			above standpt.				above standpt.
			below				below
			above standpt.				above standpt.
			below				below

STANDPOINT: Pillar Plate. STANDPOINT: Drill hole in rock. Prepared by: K.H. Haddon. Checked: K.H. Haddon. Noted on U.T.M. Card. 16.4.84.