

CENTRAL MAPPING AUTHORITY

GEODETIC SURVEY OF N.S.W.

GEODETIC STATION RECONNAISSANCE and MAINTENANCE REPORT

Description:

Note: Cross out word or words which do not apply

1. Cleared by lanes bearing..... from Trig. Mast
2. Mast & Vanes have been painted white & black respectively.
3. The station/pillar was unpiled/not unpiled/constructed on.....19....., dimensions now being:
 Description of mark.....should be explicit, e.g., S/Steel Pillar Plate, Steel plug, Brass plug, Bolt, G.I. Pipe
 Height of mark.....^{above} rock/concrete; Mark is.....^{above} G.L. ^{below}
 Height of Top Vanes to Top Mark/Pillar platem. Diameter of Vanes (vertical).....m.
 Height of Cairn.....m. Diameter of Cairn.....m. Name Plate found/not found/placed.
 Length of Mastm. (approximate if not unpiled)
4. A.....set in conc/rock has been placed/found, bearing.....° M from Mast/Plug/Pillar
5. A.....set in conc/rock has been placed/found, bearing.....° M from Mast/Plug/Pillar
6. A.....set in conc/rock has been placed/found, bearing.....° M from Mast/Plug/Pillar
7. A.....set in conc/rock has been placed/found, bearing.....° M from Mast/Plug/Pillar
8. Action required: Construction of pillar somewhere between 60m and 150m from existing trig.....

STANDPOINT:

Mark	Direction	Horiz. Distance	Height Difference	Mark	Direction	Horiz. Distance	Height Difference
			above standpt				above standpt
			below				below
			above standpt				above standpt
			below				below
Prepared by: K.J. Haslam

Checked:

Noted on U.T.M. Card

17.4.84

Checked


St 2733-1

STATION: Goomamma No.: 2268

MAP SHEET SCALE 1:250 000 GOULBURN

INSPECTED BY: K. HADAMON DATE: 20-9-83

AUTHORITY: C.M.A. FIELD BOOK: C.300

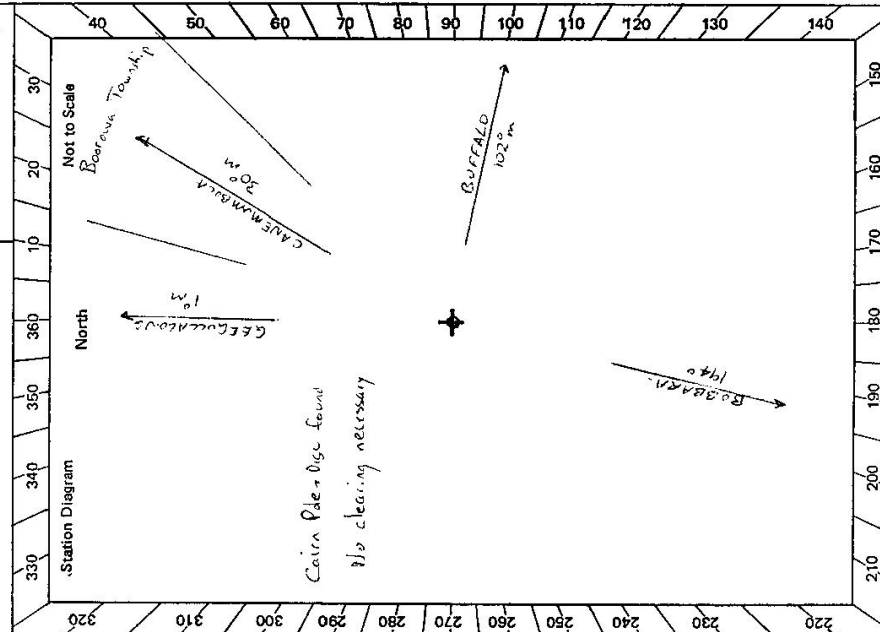

STATION **GOORBAMMA GS (P) TS 7092**


Owner's Name: **PETER MASON**
 Address: **HAWK HILL**
BOSORWA
 Phone: **85 22 60**

Current Occupant:
 Address:
 Phone:

ACCESS

Access Report of 20/9/1988 was found suitable/unsuitable
 GOORBAMMA POST OFFICE HEAD SOUTH towards VASS

0 0
 1 0 CROSS RAILWAY LINE
 2 2 TURN RIGHT TOWARDS HARDEN
 5 85 BRIDGE
 6 8 STRAIGHT AHEAD TOWARDS BINALONG
 11 5 TURN RIGHT - CROSS ROAD INTO 'HAWK HILL'
 11 8 STRAIGHT AHEAD (OWNERS HOUSE ON RIGHT)
 12 75 STRAIGHT AHEAD THROUGH 2 SETS OF DOUBLE IRON GATES
 13 3 THROUGH GATE TURN LEFT FOLLOW TRACK SOUTH ALONG FENCE
 13 9 TURN RIGHT - FOLLOW TRACK PAST TREES
 14 3 G.S.

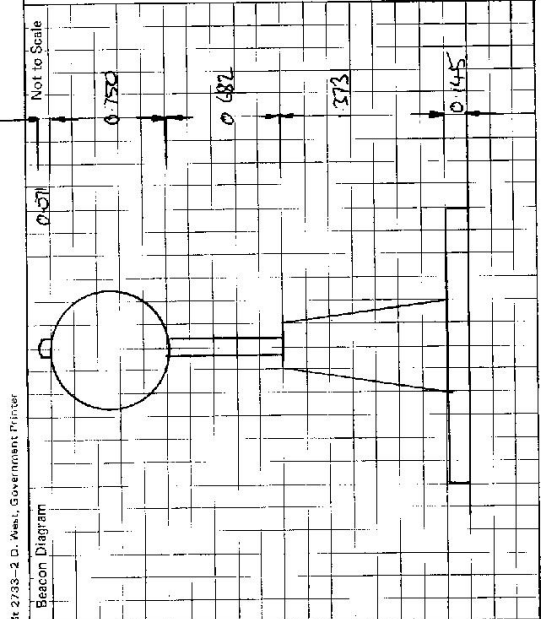

This section to be completed by officer constructing pillar.

Original station mark found/~~not found~~.....
 Description of mark: **Cross Pile in Cox**.....
 Original beacon found/~~not found~~.....
 Description of beacon: **Cairn Post - VASS**.....
 Height Top of Vanes to Top Mark **Not known**.....m.
 Height of mark **0.29** above ~~mark~~ **conc. A.P.** above G.L. / below ~~mark~~.....m.
 Diameter of Vanes **0.760**.....m. Height of Cairn **1.500**.....m.
 Original Beacon has ~~been~~ been destroyed by ma.

Date	Record of Station