

CENTRAL MAPPING AUTHORITY
Department of Lands

Trigonometrical Survey of N.S.W.

RECONNAISSANCE and MAINTENANCE REPORT

This Trig. Station has been:-

Note: Cross out word or words which do not apply


1. Completely cleared to permit 360° vision to surrounding Trigs.
2. Cleared by lones bearing..... from Trig. Mast
3. Trig. Mast & Vanes have been painted white & black respectively.
4. The Trig. was unpiled/~~not-unpiled~~, dimensions now being:
Description of mark. 2.245c. 2215. 2144c. should be explicit, e.g. Steel plug, Brass plug, Bolt, G.I. Pipe
Height of mark.....0.020.....m above rock/concrete.....m above G.I.
below
Height of Top Vanes to Top Mark. 3.522 m. Diameter of Vanes (vertical) 1.02 m.
Height of Cairn.....1.5 m. Diameter of Cairn 2.50 m.
Length of Mast 3.52 m. (approximate if not unpiled)

5. A.....set in conc/rock has been placed.....m. bearing.....°M from Trig. Mast
6. A.....set in conc/soil has been placed.....m. bearing.....°M from Trig. Mast
7. A.....set in conc/soil has been placed.....m. bearing.....°M from Trig. Mast
8. A.....set in conc/rock has been placed.....m. bearing.....°M from Trig. Mast
9. Connection.....to.....m. bearing.....°M
10. Connection.....to.....m. bearing.....°M
11. Connection.....to.....m. bearing.....°M
12. Connection.....to.....m. bearing.....°M
13. Diff. Ht. is.....m. above
below
14. Diff. Ht. is.....m. above
below
15. Diff. Ht. is.....m. above
below
16. Diff. Ht. is.....m. above
below

Prepared by: J. Jennings Checked: AM/17/17c Noted on U.T.M. Card

Checked

STATION WARRAWOLONG T.S. 7105
Co: NORTHUMBERLAND Ph: W & GOSFORD
Map Sheet: GOSFORD No: 9131 - N
Inspected by: C BOSSLOPER Date: 6 & 7 MAY 1974
Authority: C.M.A. Field Book: 1357 AB

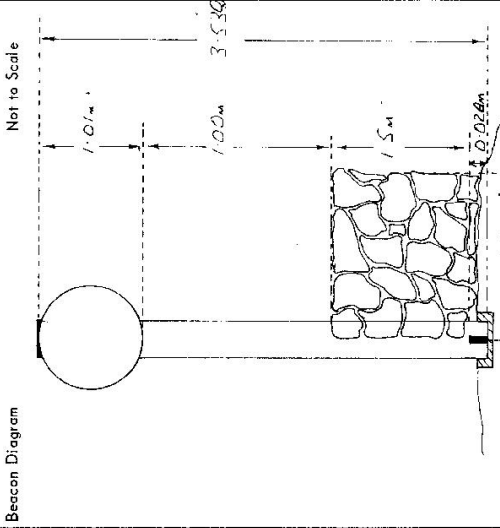

Date	Record of Station

749-98

TS 7105
No: 4634

CENTRAL MAPPING AUTHORITY

GEODETIC SURVEY OF M.S.I.W.
GEODETIC STATION RECONNAISSANCE and MAINTENANCE REPORT

STATION: WARRAWONG
SYDNEY

MAP SHEET SCALE 1:250 000

INSPECTED BY: G JAMES

DATE: 14.5.21

AUTHORITY: CMA

FIELD BOOK: 1923

Description: Note: Cross out word or words which do not apply

1. Cleared by lanes bearing..... from Trip Mast
2. Mast & Vanes have been painted white & black respectively.
3. The station/pillar was unpiled/not unpiled/constructed on..... 19....., dimensions now being: Description of mark..... should be explicit, e.g., S/Steel Pillar Plate, Steel plug, Brass plug, Bolt, G.I. Pipe
Height of mark.....m. above rock/concrete; Mark is.....m. above G.L.
Height of Top Vanes to Top Mast/Pillar plate.....m. Diameter of Vanes (vertical).....m.
Height of Cairn.....m. Diameter of Cairn.....m. Name Plate found/not found/placed.
Length of Mast.....m. (approximate if not unpiled)
4. A..... set in conc/rock has been placed/found, bearing.....° M from Mast/Plug/Pillar
5. A..... set in conc/rock has been placed/found, bearing.....° M from Mast/Plug/Pillar
6. A..... set in conc/rock has been placed/found, bearing.....° M from Mast/Plug/Pillar
7. A..... set in conc/rock has been placed/found, bearing.....° M from Mast/Plug/Pillar
8. Action required: TO BE CLEARED AND CONNECTED.

STANDPOINT:


Mark	Direction	Horiz. Distance	Height Difference	Mark	Direction	Horiz. Distance	Height Difference
			above standpt.				above standpt.
			below standpt.				below standpt.
			above standpt.				above standpt.
			below standpt.				below standpt.
Prepared by:

Checked:

Noted on U.T.M. Card

SF 2733-1

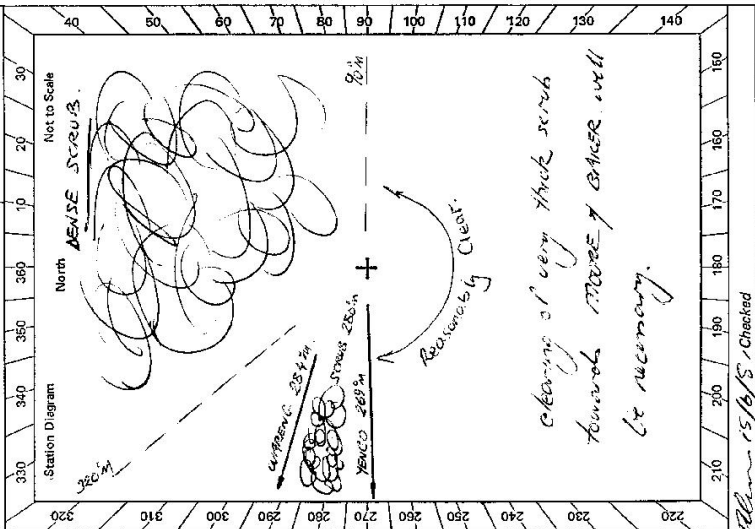

GS 24


STATION Wakawawaka GS TS 7105

Owner's Name:
 Address:
 Phone:
 Current Occupant:
 Address:
 Phone:

ACCESS

Access Report of 21/8/1981 was found suitable/unsuitable.
 Location Boards P.O. Travel South
 Turn Right Sign MAKAWAKA WAKAWAKA STATE FOREST
 Turn Right
 Turn Left onto Dirt Rd. Sign WAKAWAKA STATE FOREST
 Turn Right Sign "HUB FOREST" BOX 5, DESANDAL LS
 STANDSTAY AHEAD
 Turn Left Fore Sign "Wakawaka Forest P.O."
 Turn Left Fore WAKAWAKA FOREST P.O. "KUNUIA"
 Turn Right Fore "KUNUIA"
 Turn Right "WAKAWAKA"
 Pass Track on Right
 Pass Small Clearing and Turn to Right Track Left up old Swit Track.
 Leave Vehicle — Follow Forward Track to Track.
 30 MINUTE WALK.

- 01:00
- 01:50
- 02:30
- 03:10
- 03:50
- 04:30
- 05:10
- 05:50
- 06:30
- 07:10
- 07:50

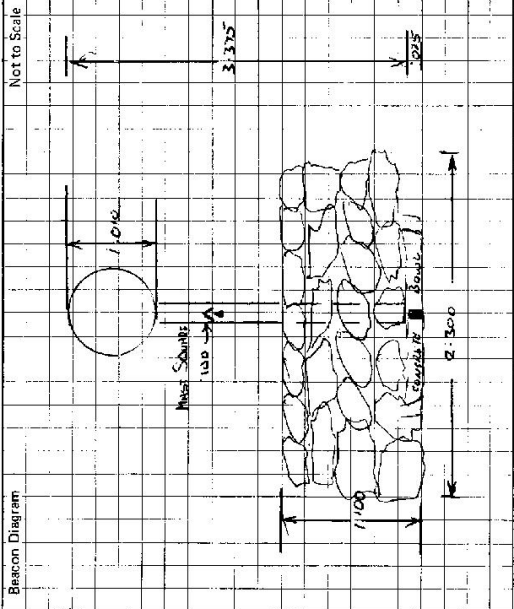

This section to be completed by officer constructing pillar.

Original station mark found/not found.

Description of mark:

Original beacon found/not found.

Description of beacon:

Height Top of Vanes to Top Markm.

Height of markm. above G.L. below

Diameter of Vanesm. Height of Cairnm.

Original Beacon has/has not been destroyed by me.

Date Record of Station

CENTRAL MAPPING AUTHORITY

GEODETIC SURVEY OF N.S.W.

GEODETIC STATION RECONNAISSANCE and MAINTENANCE REPORT

STATION: **WARRAWONG (P)** No.: **7105**

MAP SHEET SCALE: **1:250 000** **SINGLE TON**

INSPECTED BY: **G Ford** DATE: **9-12-83**


AUTHORITY: **C M A** FIELD BOOK: **1951**

- Description:
- Cleared by lanes bearing $275^{\circ} 30'$, $315^{\circ} 30'$, $320^{\circ} 15'$, $324^{\circ} 15'$, $327^{\circ} 15'$, $328^{\circ} 15'$, $330^{\circ} 15'$, $332^{\circ} 15'$, $335^{\circ} 15'$, $338^{\circ} 15'$, $340^{\circ} 15'$, $342^{\circ} 15'$, $345^{\circ} 15'$, $348^{\circ} 15'$, $350^{\circ} 15'$, $352^{\circ} 15'$, $355^{\circ} 15'$, $358^{\circ} 15'$, $360^{\circ} 15'$ from Trig. Mast
 - Mast & Vanes have been painted white & black respectively.
 - The station/pillar was ~~unplaced~~/constructed on 8.12×19.22 m, dimensions now being:
- Description of mark: **Roof Top PLUG** should be explicit, e.g., **Steel-Pillar-Plate-Steel-Plug-Bolt-G.I. Pipe**
- Height of mark 1.395 m. above ~~below~~ **reek/concrete**; Mark is 1.495 m. above ~~below~~ G.L.
- Height of Top Vanes to Top Mast/Pillar plate 1.440 m. Diameter of Vanes (vertical) 0.750 m.
- Height of Cairn 1.440 m. Diameter of Cairn 1.440 m. Name Plate ~~found~~/not found/placed.
- Length of Mast 1.440 m. (approximate if not unplaced)
- A. **BLAXLAND (P)** set in conc/rock has been placed/ found, bearing $140^{\circ} 00'$ M from Mast/Plug/Pillar
 - A. **S.S.M.** set in conc/reek has been placed/ found, bearing $19^{\circ} 00'$ M from Mast/Plug/Pillar
 - A. **G.I. PIPE** set in conc/reek has been placed/ found, bearing $244^{\circ} 00'$ M from Mast/Plug/Pillar
 - A. set in conc/rock has been placed/ found, bearing $244^{\circ} 00'$ M from Mast/Plug/Pillar
- Action required:

STANDPOINT: ROOF TOP PILLAR		STANDPOINT: TRIG PLUG					
Mark	Direction	Horiz. Distance	Height Difference	Mark	Direction	Horiz. Distance	Height Difference
BLAXLAND (P)	$0^{\circ} 00'$	1.978	1.541	BLAXLAND (P)	$0^{\circ} 00'$	0.00	above standpt.
G.I. PIPE	$02^{\circ} 25'$	2.0	1.541	G.I. PIPE	$32^{\circ} 29'$	3.668	below standpt.
BAKER (P)	$85^{\circ} 46'$	2.0	1.60	ROOF TOP PILLAR	$59^{\circ} 20'$	1.0	above standpt.
S.S.M.	$127^{\circ} 07'$	1.605	1.60	BAKER (P)	$85^{\circ} 45'$	3.0	below standpt.
YAMBO (P)	$133^{\circ} 02'$	2.0	1.507	S.S.M.	$87^{\circ} 16'$	3.172	above standpt.
TRIG PLUG	$234^{\circ} 18'$	2.145	1.507	YAMBO (P)	$233^{\circ} 01'$	3.0	below standpt.

Prepared by: **G Ford** Checked: **Michael Clark** 17.5.84. Noted on U.T.M. Card


ST 2733-1

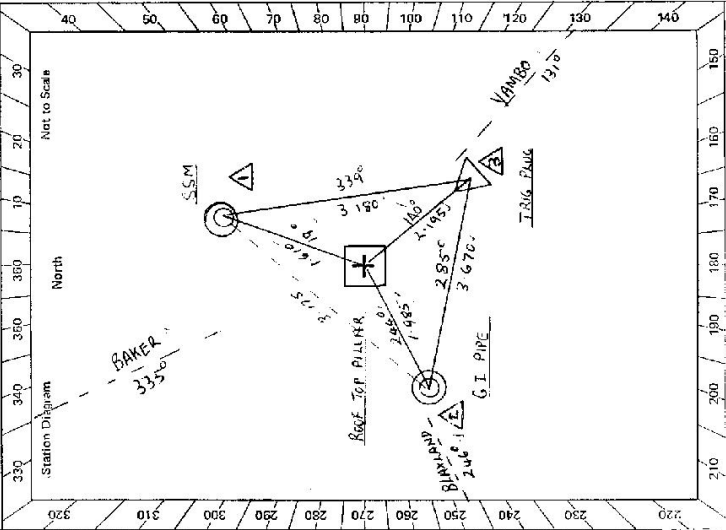

GS 24

STATION WARRAWONG (P) TS 7105

Owner's Name: TR 19477 Resealed
 Subject to permission of Department of Transport
 Address: NEWCASTLE BLUE MOUNTAIN PO BOX 48
 KICKWORTHVILLE NSW 2320
 Phone: 02 621 8600
 LANTHORPE MANTLEND L.B.O.
 Current Occupant: MR H.H. ARATOK
 Address: PEATS RIDGE QUARRY
 Phone: 06 232317

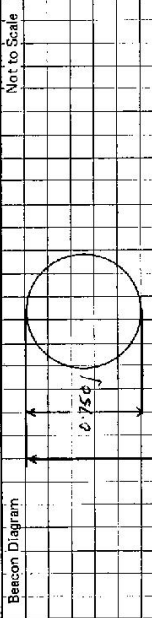

Access Report of 19.5/19.2 was found suitable/unsuitable.

0.00 INOLLUMBI PC ✓
 0.09 LEFT TOWARDS WINDSOR - SYDNEY ✓
 7.92 TURN LEFT (AT MAGNA) ✓
 12.80 END OF BITUMEN ✓
 20.81 IRON GATE MAK BCHA (EVANHA SANCTUARY) ✓
 23.80 WHITE GAZE ✓
 24.50 WOODEN BRIDGE ✓
 33.80 TURN RIGHT SIGN WALKER RIDGE FOREST ROAD ✓
 36.92 PASS ROAD ON LEFT ✓
 37.95 TURN RIGHT WARRAWONG RD ✓
 40.54 PASS TRACK ON LEFT ✓
 40.95 TURN LEFT OFF MAIN TRACK (GRASS ON TRACK) ✓
 41.35 STOP AT BLAZED TREES ✓
 AS MINI WALK FOLLOWING BLAZED TREES ✓

Note
 Station now in the Warrawong Flora Reserve
 NO DTSAI IMPORTANT THAT THE DISTRICT FORESTER
 WYONG BE CONTACTED BEFORE VISITING THE STATION
 27/05/21

Date	Record of Station

Bt 2788-2 D. West, Government Printer

This section to be completed by officer constructing pillar.

Original station mark found/~~not found~~.
 Description of mark: BRASS TUBE PLUG ✓
 Original beacon found/~~not found~~.
 Description of beacon: CAIRN POLE & DISC ✓
 Height Top of Vane to Top Mark: 3.345 ✓
 Height of mark: 0.035 m above rock/cone ✓
 Diameter of Vane: 1.000 ✓ m Height of Cairn: 1.000 ✓ m
 Original Beacon has/~~not~~ been destroyed by me.