

CENTRAL MAPPING AUTHORITY GEODETTIC SURVEY OF N.S.W. Now WAUGAN APPROVED NEW STATION

GEODETTIC STATION RECONNAISSANCE and MAINTENANCE REPORT

STATION: ~~BAZA~~ No.: 7113


MAP SHEET SCALE 1:250 000 NARRABRI

INSPECTED BY: B. JONES DATE: 21/7/82

AUTHORITY: CMA FIELD BOOK: 2008

Description: *Note: Cross out word or words which do not apply*

1. Cleared by lanes bearing.....
2. Mast & Vanes have been painted white & black respectively.
3. The station/pillar was unpiled/not unpiled/constructed on..... 19....., dimensions now being:
  - Description of mark..... should be explicit, e.g. ~~Steel Pillar Plate, Steel plug, Brass plug, Bolt, G.I. Pipe~~
  - Height of mark..... m. <sup>above</sup> rock/concrete; ~~Mark W..... m. <sup>above</sup> G.L.~~
  - Height of Top Vanes to Top Mark/Pillar plate..... 0m..... Diameter of Vanes (vertical)..... m.
  - Height of Cairn..... m. Diameter of Cairn..... m. Name Plate found/not found/placed.
  - Length of Mast..... m. ~~Approximate if not unpiled~~
4. A..... set in conc/rock has been placed/ found, bearing..... ° M from Mast/Plug/Pillar
5. A..... set in conc/rock has been placed/ found, bearing..... ° M from Mast/Plug/Pillar
6. A..... set in conc/rock has been placed/ found, bearing..... ° M from Mast/Plug/Pillar
7. A..... set in conc/rock has been placed/ found, bearing..... ° M from Mast/Plug/Pillar
8. Action required:..... SEE 55/11/969

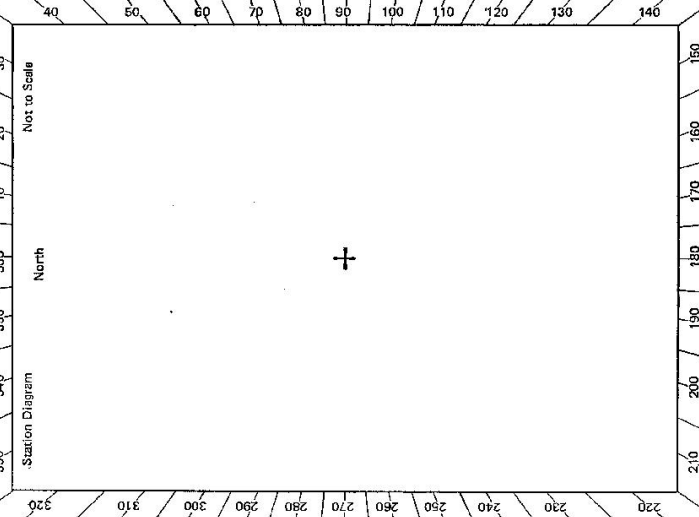

STANDPOINT:			
Mark	Direction	Horiz. Distance	Height Difference
			above standpt
			below standpt
			above standpt
			below standpt
Prepared by: [Signature] Checked: [Signature] Noted on U.T.M. Card

TS 7113  
~~BA~~ Non, WALUGAN

St 2733-2 D. West Government Printer

<p>Owner's Name: <u>Mrs S M FATIMER</u>                  Address: <u>"BULO ANO"</u>                  Phone: <u>Edificio "3.3.3"</u></p>	<p>Current Occupant: <u>/</u>                  Address: <u>/</u>                  Phone: <u>21/7/1982</u></p>	<p style="text-align: center;"><b>ACCESS 21/7/1982</b></p> <p><b>Access Report of 140 was found suitable for installation.</b></p> <p>01:00 WEE WAA Rest Office. Travel towards MABOBAE.                  6:3 Turn right towards MABOBAE.                  11:8 Turn left along sealed road. Sign says "BUREAU, STONE RAINS".                  12:4 Turn right onto gravel road.                  32:4 Turn left sign "MUTE".                  35:9 Turn left into "BULO ANO".                  36:5 Track to owner's house on right. Travel straight ahead.                  37:05 At street, turn right down driveway.                  37:15 Turn left through fence spanning across water tank.                  37:65 Make way across path to gate in SW corner. Travel straight ahead following fence. (Gate on right). Make way up rocky hill.                  38:0 Turn left and trees away from hill.                  38:6 <u>△</u></p>
<p>Date</p>		<p>Record of Station</p>

<p>Beacon Diagram</p> <div style="border: 1px solid black; height: 150px; width: 100%; position: relative;"> <div style="position: absolute; top: 50%; left: 50%; transform: translate(-50%, -50%);"> </div> </div> <p style="text-align: right;">Not to Scale</p>	<p>This section to be completed by officer constructing pillar.</p> <p>Original station mark found/not found.</p> <p>Description of mark: .....</p> <p>Original beacon found/not found.</p> <p>Description of beacon: .....</p> <p>Height Top of Vanes to Top Mark .....m.</p> <p>Height of mark .....m. above rock/conc. below G.L.</p> <p>Diameter of Vanes .....m. Height of Cairn .....m.</p> <p>Original Beacon has/has not been destroyed by me.</p>
--	--

CENTRAL MAPPING AUTHORITY

GEODETIC SURVEY OF N.S.W.

GEODETIC STATION RECONNAISSANCE and MAINTENANCE REPORT

STATION: **WAUGAN** No.: **7113**  
 MAP SHEETS: **NARRABRI** SCALE 1:100 000  
 SCALE 1:250 000  
 INSPECTED BY: **A. Sivertsen** DATE: **27 Feb '84**  
 AUTHORITY: **CMA** FIELD BOOK: **324**

Station Diagram  
 North  
 Not to Scale

- Description:
- Cleared by lanes bearing..... Note: Cross out word or words which do not apply
  - Mast & Vanes have been painted white & black respectively. ✓  
 Mast & Vanes were ~~replaced~~ constructed on **26 Feb 1984**, dimensions now being: ✓  
 Description of mark: **Steel Pillar Plate** would be explicit, e.g., S/Steel Pillar Plate, Steel plug, Brass plug, Bolt, G.I. Pipe  
 Height of mark..... **1.360** m. above ~~rock~~ **rock/concrete**; Mark is **1.49** m. above ~~rock~~ **G.L.**
  - Height of Top Vanes to Top Mast/Pillar plate **1.440** m. Diameter of Vanes (vertical) **0.747** m. ✓  
 Height of Cairn..... m. Diameter of Cairn..... m. Name Plate found/not found/placed.
  - Length of Mast **1.525** m. (approximate if not unspiled)
  - A. **Cu. Nail** set in conc/rock has been placed/removed, bearing **106.6** °M from Mast/Plug/Pillar  
 A. **G.I. Pipe** set in conc/rock has been placed/removed, bearing **182.0** °M from Mast/Plug/Pillar  
 A. set in conc/rock has been placed/removed, bearing..... °M from Mast/Plug/Pillar  
 A. set in conc/rock has been placed/removed, bearing..... °M from Mast/Plug/Pillar
  - Action required:.....

STANDPOINT: Pillar		STANDPOINT: Cu. Nail		STANDPOINT: G.I. Pipe		STANDPOINT: GRATTAI (P)	
Mark	Direction	Horiz. Distance	Height Difference	Mark	Direction	Horiz. Distance	Height Difference
KAPUTAR (P)	0 00 00		above standpt	KAPUTAR (P)	0 00 00		below standpt
Cu. Nail	1 24 01	3.642	1.496	G.I. Pipe	134 54 44	4.336	0.036
G.I. Pipe	79 35 44	3.212	1.535	Pillar	181 22 07	3.644	1.428
GRATTAI (P)	337 30 43		above standpt	GRATTAI (P)	337 30 26		above standpt
			below standpt				below standpt
			above standpt				above standpt
			below standpt				below standpt
			above standpt				above standpt
			below standpt				below standpt

Prepared by: **A. Sivertsen** 21.3.84  
 Checked: **C. Ross**  
 Noted on U.T.M. Card



LAND INFORMATION CENTRE

GEODETIC SURVEY OF N.S.W.

GEODETIC STATION RECONNAISSANCE and MAINTENANCE REPORT

STATION: **WAUGAN** No.: **7113**

MAP SHEET SCALE 1:250 000 **NARRABRI**

INSPECTED BY: **C Zahra** DATE: **1-3-84**

AUTHORITY: **CMA** FIELD BOOK: **C 324**

Description: **Clear 360°** Note: Cross out word or words which do not apply

1. Cleared by lanes bearing **Clear 360°** from Trig. Mast

2. Mast & Vanes have been painted white & black respectively.

3. The station/pillar was unpiled/not unpiled/constructed on **19** dimensions now being:

Description of mark **should be explicit, e.g. S/Steel Pillar Plate** Steel plug, Brass plug, Bolt, G.I. Pipe

Height of mark **1.5** m. above rock/concrete; Mark is **1.5** m. above G.L.

Height of Top Vanes to Top Mark/Pillar plate **1.440** m. Diameter of Vanes (vertical) **0.742** m.

Height of Cairn **---** m. Diameter of Cairn **---** m. Name Plate found/not found/placed.

Length of Mast **1.525** m. (approximate if not unpiled)

4. A. **G.I.N** set in ~~conc/rock~~ **tree** bearing **69°** M. from Mast/Plug/Pillar

5. A. **CUNAIL** set in conc/rock has been placed/found, bearing **106°** M. from Mast/Plug/Pillar

6. A. **G.I.Pipe** set in conc/rock has been placed/found, bearing **182°** N. from Mast/Plug/Pillar

7. A. **G.I.Pipe** set in conc/rock has been placed/found, bearing **60°** N. from Mast/Plug/Pillar **CUNAIL**

8. Action required: **---**

Mark	Direction	Horiz. Distance	Height Difference	Mark	Direction	Horiz. Distance	Height Difference
<b>Light on Graffai line to (?)</b>	<b>0 00 00</b>		above standpt.	<b>Graffai 65 82.94</b>	<b>0 00 00</b>		above standpt.
<b>Silo LHS side of mast</b>	<b>15 56 29</b>		below standpt.	<b>GIP in conc</b>	<b>15 56 41</b>		above standpt.
<b>CUNAIL in conc</b>	<b>23 53 26</b>	<b>3.644</b>	below standpt.	<b>GIP in conc</b>	<b>157 22 52</b>	<b>4.341</b>	below standpt.
<b>G.I.Pipe in conc</b>	<b>102 05 04</b>	<b>3.212</b>	below standpt.	<b>Spigot</b>	<b>203 49 33</b>	<b>3.644</b>	above standpt.
<b>G.I.N in tree</b>	<b>348 06 11</b>	<b>1.00</b>	above standpt.	<b>G.I.N in tree</b>	<b>346 52 11</b>	<b>0.66</b>	above standpt.
			below standpt.				below standpt.
			above standpt.				above standpt.
			below standpt.				below standpt.

STANDPOINT: **CUNAIL**

STANDPOINT: **at Pillar**

Prepared by: **C Zahra** Checked: **---** Noted on U.T.M. Card

Checked

GS 24

STATION WAUGAN TS 7113


Owner's Name: S. M. EATHER  
 Address: "BALD KNOS"  
 Phone: Edgerai 333 D  
 Current Occupant:  
 Address:  
 Phone:

ACCESS

Access Report of 27.2.1984 was found suitable/unsuitable.

- 0.0 WEE WAA RD. Travel towards NARRABRI
- 6.3 Turn R towards NARRABRI
- 11.8 Turn L along sealed road. Sign: BULYEROI, SPRING RAINS "
- 12.9 Turn R gravel road.
- 32.4 Turn L Sign: "MILLIE "
- 35.9 Turn L into "BALD KNOS "
- 36.8 Track to owners house on R. Travel straight ahead.
- 36.85 Turn L down laneway
- 37.15 Turn L through fence opening before water tank.  
Make own way across paddock to gate in SW corner
- 37.65 Thru wire gate in cor. Straight ahead - fence on R
- 38.0 Turn L at trees away from fence & make own way  
thru rocky paddock to top of hill
- 38.16 WAUGAN G.S.

ALTERNATIVE ACCESS: At abt 35.6 turn left along wheel tracks to iron gate. After gate follow track veering to left & up hill to A.

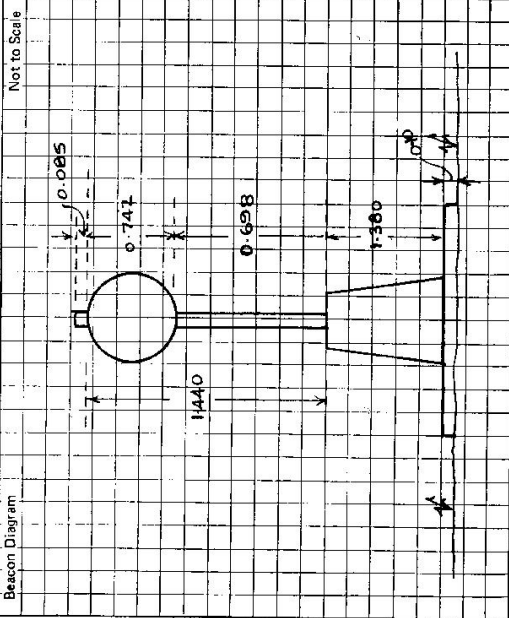

This section to be completed by officer constructing pillar.

Original station mark found/not found.

Description of mark: G.L. Pipe in soil (From 1:4000 Control)

Original beacon found/not found.

Description of beacon:

Height Top of Vanes to Top Mark .....m.

Height of mark .....m. above below rock/cone .....m. above below G.L.

Diameter of Vanes .....m. Height of Cairn .....m.

Original Beacon has/has not been destroyed by me.

Date

Record of Station