

CENTRAL MAPPING AUTHORITY  
Department of Lands

Trigonometrical Survey of N.S.W.

RECONNAISSANCE and MAINTENANCE REPORT

This Trig. Station has been:-

Note: Cross out word or words which do not apply

1. ~~Completely cleared to permit 360° vision to surrounding Trig.~~
2. Cleared by James bearing from Trig-Mast
3. ~~Trig-Mast & Vanes have been painted white & black respectively.~~
4. The Trig. was ~~unpiled~~/not unpiled, dimensions now being:

Description of mark..... should be explicit, e.g. Steel plug, Brass plug, Bolt, G.I. Pipe

Height of mark..... m above below rock/concrete..... m above below G.L.

Height of Top Vanes to Top Mark..... m. Diameter of Vanes (vertical)..... m.

Height of Cairn 1.9 m. Diameter of Cairn 2.1 m.

~~Length of Mast~~..... (approximate if not unpiled)

5. A..... set in conc/rock has been placed..... m. bearing.....°M from Trig. Mast
6. A..... set in conc/soil has been placed..... m. bearing.....°M from Trig. Mast
7. A..... set in conc/soil has been placed..... m. bearing.....°M from Trig. Mast
8. A..... set in conc/rock has been placed..... m. bearing.....°M from Trig. Mast

9. Connection to NA bearing.....°M

10. Connection to..... m. bearing.....°M

11. Connection to..... m. bearing.....°M

12. Connection to..... m. bearing.....°M

13. Diff. Ht. is..... m. above below

14. Diff. Ht. is..... m. above below

15. Diff. Ht. is..... m. above below

16. Diff. Ht. is..... m. above below


Prepared by: Paul

Checked:

Noted on U.T.M. Card

STATION GENOWLAN G.S. 7138  
Co: ROXBURGH Pk: MORUNDUREY  
Map Sheet: WALLERAWANG No: 8931-N  
Inspected by: P. CARR Date: 16/2/77  
Authority: C.M.A. Field Book:

Besccon Diagram Not to Scale

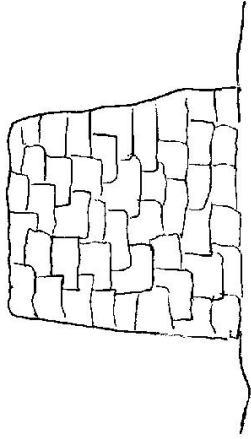

Mast found rotted on ground.

Date..... Record of Station.....

Checked



CENTRAL MAPPING AUTHORITY  
Department of Lands

Trigonometrical Survey of N.S.W.

RECONNAISSANCE and MAINTENANCE REPORT

STATION **GENOWLAN GS TS 7138**

Co: **ROYBURGH** | Ph: **MORUNDUREY**  
Map Sheet: **WALLERWANG** | No: **8931-N**  
Inspected by: **H.C. BOEDER** | Date: **25-11-77**  
Authority: **C.M.A.** | Field Book:

This Trig. Station has been:- Note: Cross out word or words which do not apply

1. ~~Completely cleared to permit 360° vision to surrounding Trig.~~
2. Cleared by lanes bearing **137° to 265°**, **325° to 80°** from Trig. Mast
3. Trig. Mast & Vanes have been painted white & black respectively.  Mast ~~not painted~~
4. The Trig. was unpiled/~~not unpiled~~, dimensions now being: **Original Station Mark found / not found**


Description of mark: **Brown, Te. C. Plus** should be explicit, e.g. Steel plug, Brass plug, Bolt, G.L. Pipe  
Height of mark: **0.035** m above (rock/concrete) **0.776** m above below G.L.  
Height of Top Vanes to Top Mark: **3.414** m. Diameter of Vanes (vertical): **0.776** m.  
Height of Cairn: **1.350** m. Diameter of Cairn: **2.440** m.

5. ~~Star Picket set in conc/rock has been placed~~ **148°** m. bearing **148°** from Trig. Mast Plus Level
6. **Star Picket** set in conc/~~rock~~ has been placed **3.500** m. bearing **148°** from Trig. Mast Plus Level
7. **Star Picket** set in conc/~~rock~~ has been placed **3.560** m. bearing **245°** from Trig. Mast Plus Level
8. **A** set in conc/rock has been placed **0.035** m. bearing **0°** from Trig. Mast

9. Connection to **0.035** m. bearing **0°**
10. Connection to **0.035** m. bearing **0°**
11. Connection to **0.035** m. bearing **0°**
12. Connection to **0.035** m. bearing **0°**

13. Diff. Ht. is **0.035** m. above below
14. Diff. Ht. is **0.035** m. above below
15. Diff. Ht. is **0.035** m. above below
16. Diff. Ht. is **0.035** m. above below

Prepared by: **H.C. BOEDER** Checked: **7/** Noted on U.T.M. Card

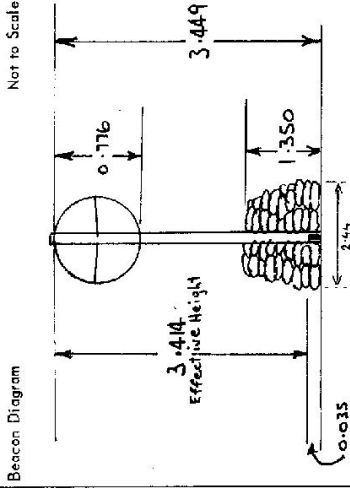

Date	Record of Station

Checked



TS-7138  
No: 2161

STATION: GENDWLAN G.S.


MAP SHEET  
SCALE 1:250 000  
SYDNEY

INSPECTED BY: K. THOMPSON

DATE: 22-2-179

AUTHORITY: C. M. A

FIELD BOOK: AB 1716

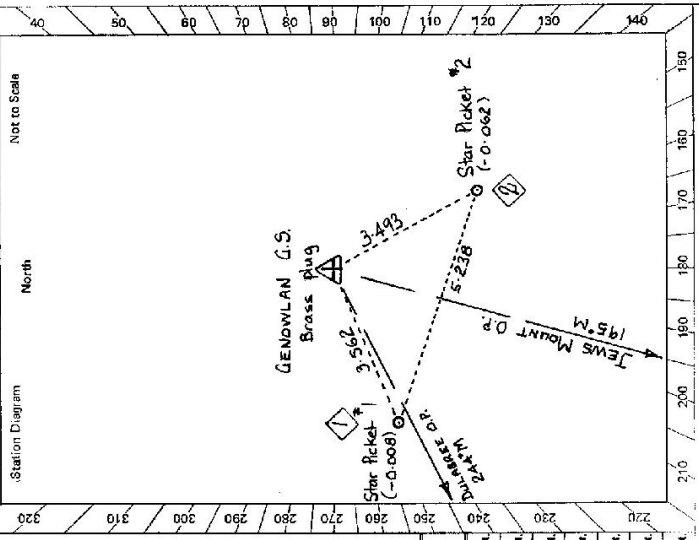

Checked

GEODETIC STATION RECONNAISSANCE and MAINTENANCE REPORT

Description: Note: Cross out word or words which do not apply

1. Cleared by lanes bearing... 330 - 80° M. 140 - 260° M

2. Mast & Vanes have been painted white & black respectively.

3. The station/pillar was unpiled/not unpiled/removed on... 19.79, dimensions now being:

Description of mark... Brass Plug... should be explicit, e.g., S/Steel Pillar Plate, Steel plug, Brass plug, Bolt, G.I. Pipe

Height of mark... 0.03... Mark is... above G.L.

Height of Top Vanes to Top Mark/Pillar/plate... 3.450... Diameter of Vanes (vertical)... 0.76

Height of Cairn... 1.5... Diameter of Cairn... 3.0... Name Plate found/not found/placed.

Length of Mast... 3.480... (approximate if not unpiled)

4. A... STAR PICKET #1... set in conc/rock has been placed/found, bearing... 248° M from Mast/Plug/Pillar

5. A... STAR PICKET #2... set in conc/rock has been placed/found, bearing... 152° M from Mast/Plug/Pillar

6. A... set in conc/rock has been placed/found, bearing... ° M from Mast/Plug/Pillar

7. A... set in conc/rock has been placed/found, bearing... ° M from Mast/Plug/Pillar

8. Action required:

Mark	Direction	Horiz. Distance	Height Difference	Mark	Direction	Horiz. Distance	Height Difference
JEW'S MOUNT O.P.	0 00 00			JEW'S MOUNT O.P.	0 00 00		
STAR PICKET #1	51 47 00	3.564	0.005	DULABREE G.S.P.	49 49 08		
DULABREE O.P.	49 48 29			G.S. Brass plug	231 42 50	3.559	0.010
STAR PICKET #2	315 54 10	3.443	0.068	STAR PICKET #2	273 19 30	5.238	0.061

STANDPOINT: Brass Trig. Plug. STANDPOINT: STAR PICKET #1

Prepared by: Kevin Thompson 4/4/179 Checked:

Name on U.T.M. Card




STATION: *CENNEWLAN*  
 No.: *2167*

MAP SHEET  
 SCALE 1:250 000  
 SYDNEY

INSPECTED BY: *R. ELLIS*  
 DATE: *3-6-81*

AUTHORITY: *C. M. A.*  
 FIELD BOOK: *C1880*

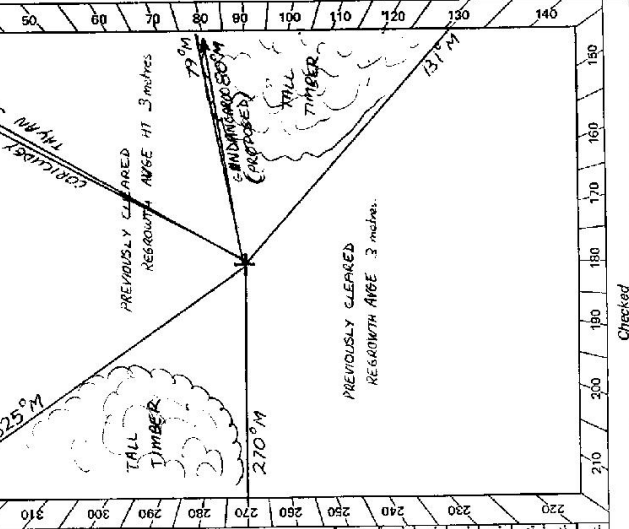

CENTRAL MAPPING AUTHORITY  
 GEODETIC SURVEY OF NSW  
 GEODETIC STATION RECONNAISSANCE and MAINTENANCE REPORT

- Note: Cross out word or words which do not apply*
- Cleared by lanes bearing..... from Trig. Mast
  - Mast & Vanes have been painted white & black respectively.
  - The station/pillar was unpiled/not unpiled/constructed on....., dimensions now being:  
 Description of mark..... should be explicit, e.g., S/Steel Pillar Plate, Steel plug, Brass plug, Bolt, G.I. Pipe  
 Height of mark.....<sup>above</sup> rock/concrete; Mark is.....<sup>above</sup> G.L.  
 Height of Top Vanes to Top Mark/Pillar plate.....<sup>above</sup>.....<sup>below</sup>.....  
 Diameter of Vanes (vertical).....m.  
 Height of Cairn.....m. Diameter of Cairn.....m. Name Plate found/not found/placed.  
 Length of Mast.....m. (approximate if not unpiled)
  - A..... set in conc/rock has been placed/found, bearing.....° M from Mast/Plug/Pillar
  - A..... set in conc/rock has been placed/found, bearing.....° M from Mast/Plug/Pillar
  - A..... set in conc/rock has been placed/found, bearing.....° M from Mast/Plug/Pillar
  - A..... set in conc/rock has been placed/found, bearing.....° M from Mast/Plug/Pillar
  - Action required..... *MAINTENANCE ON TRIG. POSSIBLE INCLUSION OF ADDITIONAL ECCENTRIC MARK TO NORTH TO FACILITATE CLEARING FOR LINE TO GONDWANAREED (Proposed) TRIG. STN.*

STANDPOINT:

Mark	Direction	Horiz. Distance	Height Difference	Mark	Direction	Horiz. Distance	Height Difference
			above standpt				above standpt
			below				below
			above standpt				above standpt
			below				below
Prepared by: *Ellis* 10/6/81  
 Checked: *Ellis*  
 Noted on U.T.M. Card

GS 24

<p>STATION</p> <p style="text-align: center; font-size: 1.2em;"><i>GENDOLLAN IS 7138</i></p>	<p>Owner's Name: <del>.....</del></p> <p>Address: <del>.....</del></p> <p>Phone: <del>.....</del></p> <p>Current Occupant: <i>VACANT CROWN LAND</i></p> <p>Address: <i>From enquiries to: Orange LBO</i></p> <p>Phone: <i>then phone call to Mr Aughey</i></p> <p>Investigations <i>Orange LBO</i></p> <p>Mineral Res. <i>02 231 0912</i></p> <p><i>2/5/82</i></p> <p>ACCESS <i>3-6-1981</i></p> <p>Access Report of <i>Bill 1971</i> was found <del>unsuitable</del> (unsuitable).</p> <p>0.0 KM FROM CAPETEE P.O. PROCEED TOWARDS MUDGEE</p> <p>0.05 KM TURN RIGHT ALONG "GLEN DAVIS ROAD"</p> <p>8.2 KM TURN LEFT AT YELLOW GATE. (KEY ON BOTTOM SIDE OF GATE STAY IN KNOTHOLE)</p> <p>8.4 KM TAKE LEFT FORK</p> <p>8.5 KM PASS HOUSE ON LEFT - (OWNERS HOUSE)</p> <p>8.6 KM TAKE RIGHT FORK</p> <p>8.8 KM PASS SHED ON LEFT</p> <p>8.9 KM PASS TRACK ON LEFT</p> <p>9.6 KM PASS TRACK ON LEFT - SHARP RIGHT-HAND HARPIN CORNER</p> <p>9.7 KM CROSS CREEK GULLY</p> <p>10.0 KM PASS THROUGH GAP IN CLIFF FACE</p> <p>10.1 KM TURN RIGHT AT FORK IN ROAD</p> <p>10.4 KM PASS TWO TRACKS ON LEFT</p> <p>10.45 KM STOP AT BLAZES IN TREES - PARK VEHICLES HERE</p> <p>FOLLOW BLAZES IN A DIRECTION OF 140° M INITIALLY</p> <p>FOLLOW BLAZES UP ROCKY FACE AND ALONG RIDGE IN A GENERALLY "SW" DIRECTION - APPROX 30 MINS WALK WITHOUT LOAD.</p>
<p>Beacon Diagram</p> <p style="text-align: right;">Not to Scale</p> <p style="text-align: center;"><i>CAIRN, MUST 8 VAINES IN GOOD ORDER.</i></p>	<p>This section to be completed by officer constructing pillar.</p> <p>Original station mark found/not found.</p> <p>Description of mark: .....</p> <p>Original beacon found/not found.</p> <p>Description of beacon: .....</p> <p>Height Top of Vanes to Top Mark .....m.</p> <p>Height of mark .....m. above G.L. below</p> <p>Diameter of Vases .....m. Height of Cairn .....m.</p> <p>Original Beacon has/has not been destroyed by me.</p>
	<p>Date</p> <p>Record of Station</p>



CENTRAL MAPPING AUTHORITY

GEODETIC SURVEY OF N.S.W.

GEODETIC STATION RECONNAISSANCE and MAINTENANCE REPORT

Description: *Note: Cross out word or words which do not apply*  
 1. Cleared by lanes bearing..... from Trig. Mast

2. Mast & Vanes have been painted white & black respectively.

3. The station/pillar was unpiled/not unpiled/constructed on....., dimensions now being:

Description of mark..... should be explicit, e.g., S/Steel Pillar Plate, Steel plug, Brass plug, Bolt, G.I. Pipe

Height of mark..... m. <sup>above</sup> rock/concrete; Mark is..... m. <sup>above</sup> G.L.

Height of Top Vanes to Top Mark/Pillar plate..... m. Diameter of Vanes (vertical)..... m.

Height of Cairn..... m. Diameter of Cairn..... m. Name Plate found/not found/placed.

Length of Mast..... m. (approximate if not unpiled)

4. A..... set in conc/rock has been placed/found, bearing..... ° M from Mast/Plug/Pillar

5. A..... set in conc/rock has been placed/found, bearing..... ° M from Mast/Plug/Pillar

6. A..... set in conc/rock has been placed/found, bearing..... ° M from Mast/Plug/Pillar

7. A..... set in conc/rock has been placed/found, bearing..... ° M from Mast/Plug/Pillar

8. Action required:..... **SUITABLE FOR CONCRETE PILLAR**.....

STANDPOINT:

STANDPOINT:

Mark	Direction	Horiz. Distance	Height Difference	Mark	Direction	Horiz. Distance	Height Difference
			above standpt.				above standpt.
			below				below
			above standpt.				above standpt.
			below				below
Prepared by: **C SHADBOLT 23/1/82** Checked:

Notes on U.T.M. Card


Sr 2733-1

TS-7138  
 STATION: **GENOWLAN GS**  
 No: **246T**

MAP SHEET  
 SCALE 1:250 000 **SINGLETON**

INSPECTED BY: **D SHADBOLT** DATE: **31-J-82**

AUTHORITY: **CMA** FIELD BOOK: **-**

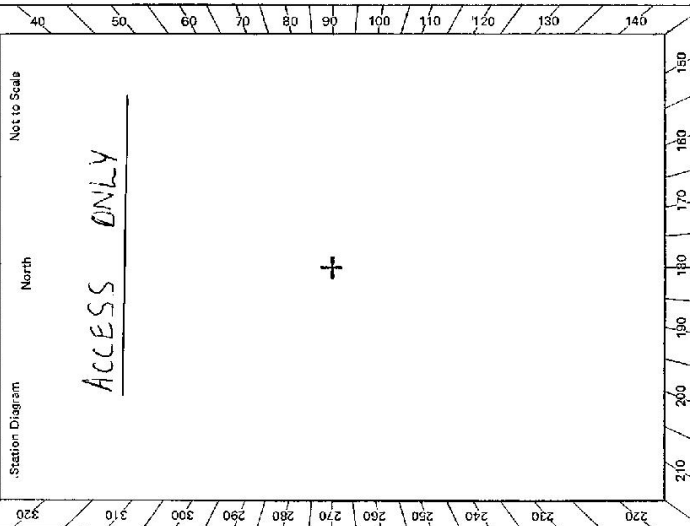

Checked



CENTRAL MAPPING AUTHORITY

GEODETIC SURVEY OF N.S.W.

GEODETIC STATION RECONNAISSANCE and MAINTENANCE REPORT

Description:

1. Cleared by lanes bearing  $40^{\circ} 4' 6''$  to  $280.4'$ ,  $11^{\circ} 34' 7''$  to  $82.54'$  from Trig. Mast

2. Mast & Vanes have been painted white & black respectively.

3. The station/pillar was ~~reconstructed~~/constructed on  $6 \times 4$  m on  $19^{\text{th}}$  Apr 1986, dimensions now being:

Description of mark: ~~Steel Pillar Plate~~/Steel Pillar Plate, Steel plug, Brass plug, Bolt, G.I. Pipe

Height of mark:  $1.370$  m. above ~~mark~~/concrete; Mark is  $1.530$  m. above G.L.

Height of Top Vanes to Top ~~mark~~/Pillar plate  $1.400$  m. Diameter of Vanes (vertical)  $0.750$  m.

Height of Cairn: ..... m. Diameter of Cairn: ..... m. Name Plate: ~~removed~~/replaced/placed.

Length of Mast: ..... m. (approximate if not unpiled)

4. A. ~~Steel Trig. Plate~~ set in ~~conc/rock~~/found, bearing  $17^{\circ}$  M from ~~mark~~/Pillar

5. A. ~~Steel Plate~~ set in conc/~~rock~~ has been ~~placed~~/found, bearing  $310^{\circ}$  M from ~~mark~~/Pillar

6. A. ~~Steel Plate~~ set in conc/~~rock~~ has been ~~placed~~/found, bearing  $84^{\circ}$  M from ~~mark~~/Pillar

7. A. .... set in conc/rock has been placed/found, bearing: ..... M from Mast/Plug/Pillar


8. Action required: .....

STANDPOINT: ~~Cone Obs Pillar~~

STANDPOINT: ~~Steel Trig. Plate~~

Mark	Direction	Horiz. Distance	Height Difference	Mark	Direction	Horiz. Distance	Height Difference
Lewis Mountain (P)	$0^{\circ} 00' 00''$	1	above standpt.	Lewis Mountain (P)	$0^{\circ} 00' 00''$	1	above standpt.
Steel Pillar (P)	$119^{\circ} 46' 10''$	$3.094$	below standpt.	Cone Obs Pillar	$01^{\circ} 43' 36''$	$370.7$	above standpt.
Steel Trig. Plate	$181^{\circ} 44' 00''$	$3.708$	below standpt.	Steel Pillar (P)	$51^{\circ} 43' 10''$	$3.583$	below standpt.
Trig. Plate (P)	$145^{\circ} 58' 30''$	1	above standpt.	Trig. Plate (P)	$145^{\circ} 58' 20''$	1	above standpt.
Steel Pillar (P)	$244^{\circ} 13' 00''$	$2.829$	below standpt.	Steel Plate (P)	$245^{\circ} 58' 10''$	$3.580$	below standpt.
Concrete Mark (A)	$245^{\circ} 48' 00''$	1	below standpt.	Steel Plate (P)	$315^{\circ} 55' 10''$	$3.669$	below standpt.

Prepared by: ~~P.P.~~ Checked: ~~M.L.~~ Noted on U.T.M. Card

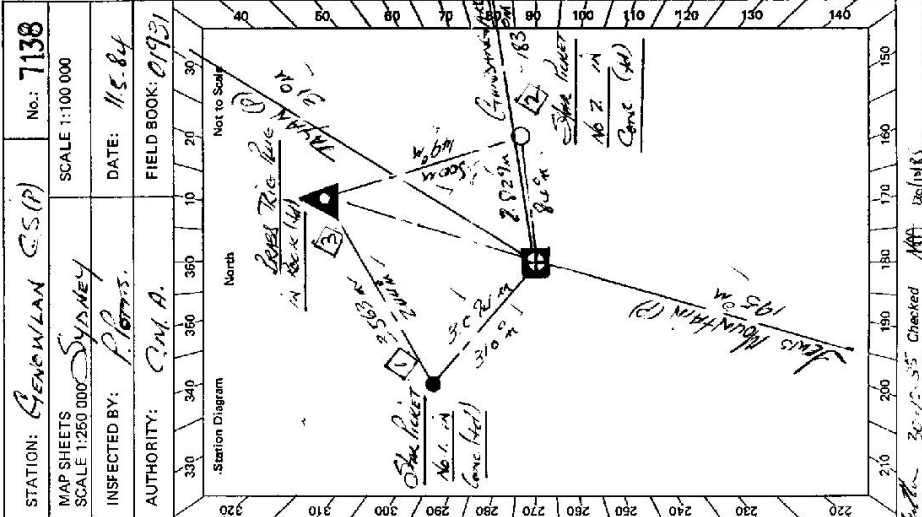

STATION: ~~RENEWLAN CS(P)~~ No: 7138  
 MAP SHEETS SCALE 1:250 000  
 INSPECTED BY: ~~P.P.~~ DATE: 11.5.84  
 AUTHORITY: ~~C.M.A.~~ FIELD BOOK: 01931

Checked: ~~M.L.~~ 31.5.84

STATION **GRENOWLAN (E.P.) 7138**

Current Occupant: **Mr. C. J. KILBAY**

Address: .....

Phone: .....

Owner's Name: **CONAN LAND**

Address: .....


Phone: .....

**ACCESS**

Access Report of 11/5/1984 was found suitable/unsuitable.

- 144 **FEATURE**
- 0100 **CHALKYRE EAST BRIDGE HEAD TOWARDS MUDS BEE /**
- 0103 **TRUCK LIGHT SIGN GREEN DAVID ST. - GRAVEL ROAD /**
- 366 **MUDS BEE BRIDGE /**
- 802 **TOWN LEFT & THROUGH LOCKED YELLOW GATE (CONAN LOCK FINDER) /**
- 838 **HOUSE ON LEFT /**
- 866 **TOWN RIGHT AT OLD MACHINERY SHED & FELLON /**
- 971 **STEEP TRACK UP RIDGE /**
- 973 **TRUCK TRACK ON LEFT /**
- 1001 **TRUCK TRACK ON RIGHT /**
- 1013 **TRUCK TRACK ON RIGHT /**
- 1058 **TOWN SHED RIGHT /**
- 1152 **GEODETIC STATION GRENOWLAN /**

Not to Scale

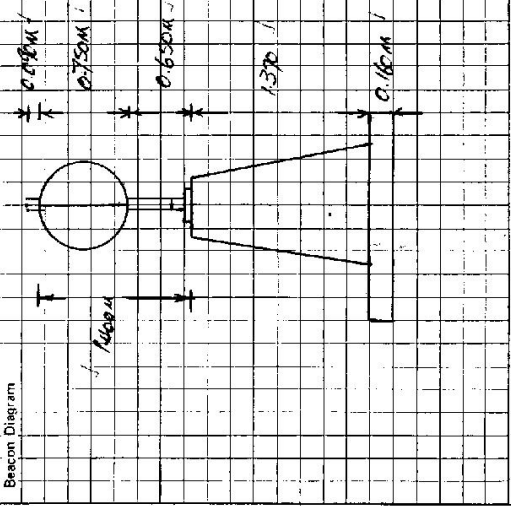

61 27332-2 D. West Government Printer

This section to be completed by officer constructing pillar.

Original station mark found/~~not found~~.

Description of mark: **BRASS TRIG. PILLAR**

Original beacon found/~~not found~~.

Description of beacon: **Coin Be. A Disc**

Height Top of Vanes to Top Mark **3.855** m.

Height of mark **0.03** m.   
 above rock/above G.L.   
 below rock/below

Diameter of Vanes **0.765** m.

Original Beacon has/~~has not~~ been destroyed by me.   
 Height of Cairn **1.000** m.

Date	Record of Station