




STATION REDBANK GS (P) 7148

Owner's Name: ALAN LUMMINGHAM  
 Address: REDMOUNT  
 ROSARY VIA TARALCA  
 Phone: 048 373768

Current Occupant: OWNER  
 Address:  
 Phone:

ACCESS 30-6-1984

Access Report of 1/19 - was found suitable for installation  
 00 CROCKWELL PO HEAD DOWN MAIN ST TOWARDS BATHURST  
 03 TURN RIGHT TOWARDS LAGGAN  
 87 AT LAGGAN TURN HARD RIGHT ONTO WOODHOUSE LEE ROAD  
 90 END OF BITUMEN RAILWAY LINE ONTO MINISTER ROAD  
 13.75 TURN LEFT BEFORE HOUSE ON LEFT THEN VEER RIGHT AND HEAD TOWARDS  
 14.25 PASS OWNERS HOUSE THROUGH IRON GATE THEN VEER RIGHT AND HEAD TOWARDS  
 15.1 TURN LEFT THROUGH IRON GATE THEN VEER RIGHT AND HEAD TOWARDS  
 POWER POLE AND THEN TO TOP OF HILL.  
 15.6 REDBANK GS (P)

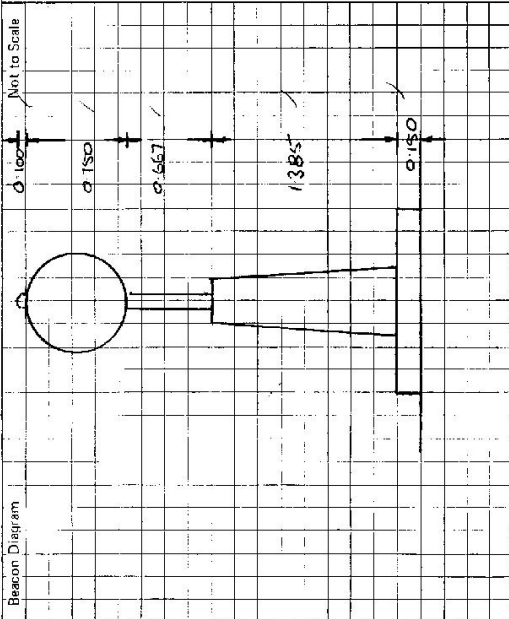

This section to be completed by officer constructing pillar.

Original station mark found/~~not found~~.

Description of mark: ~~None~~ *None in Location*

Original beacon found/~~not found~~.

Description of beacon: *TRIPED MARK VINES*

Height Top of Vanes to Top Mark *2.257* m.

Height of mark *0.2* m. *above* G.L. *below* rock/conc. *0.250* m.

Diameter of Vanes *0.106* m. Height of Cairn *0* m.

Original Beacon has ~~been~~ been destroyed by me.

Date

Record of Station