

CENTRAL MAPPING AUTHORITY

GEODETIC SURVEY OF N.S.W.

GEODETIC STATION RECONNAISSANCE and MAINTENANCE REPORT

Description:

1. Cleared by lances bearing  $360^\circ$  with some scattered trees from Trig. Mast
2. Mast & Vanes have been painted white & black respectively.
3. The station/pillar was repaired/constructed on 5/6 July 1984, dimensions now being:

Description of marks: Steel Plate should be explicit, e.g., S/Steel Pillar Plate, Steel plug, Brass plug, Bolt, G.I. Pipe

Height of mark:  $1.370$  m. above ~~rock~~ concrete; Mark is  $1.570$  m. above G.L.

Height of Top Vanes to Top Mast/Pillar plate  $1.416$  m. Diameter of Vanes (vertical)  $0.350$  m.

Height of Cairn: ..... m. Diameter of Cairn: ..... m. Name Plate ~~found~~ not found/placed.

Length of Mast ..... m. (approximate if not unplied)

1. A. Copper Nail set in conc/rock has been placed/found, bearing  $313^\circ$  M from Mast/Plug/Pillar

2. A. G.I. Pipe set in conc/rock has been placed/found, bearing  $70^\circ$  M from Mast/Plug/Pillar

3. A. .... set in conc/rock has been placed/found, bearing ..... M from Mast/Plug/Pillar

4. A. .... set in conc/rock has been placed/found, bearing ..... M from Mast/Plug/Pillar

5. Action required: .....

STANDPOINT: S/S Pillar Plate STANDPOINT: Copper Nail


Mark	Direction	Horiz. Distance	Height Difference	Mark	Direction	Horiz. Distance	Height Difference
WATTMAN CS(1)	0 00 00	✓	above standpt.	WATTMAN CS(1)	0 00 00	✓	above standpt.
G.I. PIPE	11 40 55	3.589	below	G.I. PIPE	40 53 45	5.655	below
MARY CS(1)	87 06 10	✓	above standpt.	S/S PILLAR PLATE	75 41 30	3.073	below
COPPER NAIL	256 43 15	3.073	below	MARY CS(1)	87 04 55	✓	above standpt.
			above standpt.				below
			above standpt.				below
			above standpt.				below
			above standpt.				below

Prepared by: *[Signature]*

Checked: AS 27/11

Noted on U.T.M. Card #4-41218

Checked #4-41218

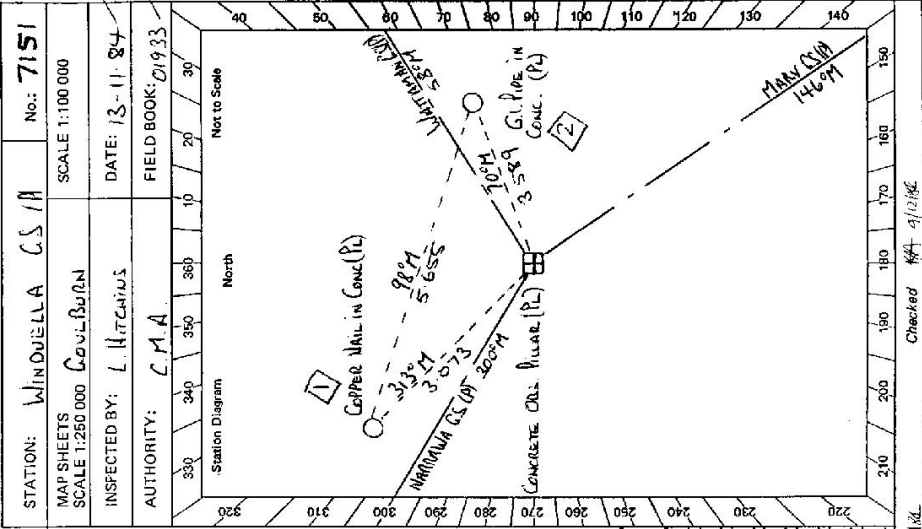

2733 - 2 D. West, Government Printer

<p>STATION <b>WINDUELLA CS (P)</b> TS 7151</p> <p>Owner's Name: <b>John Casley</b>                  Address: <b>WOODBINE PARK</b>                  Phone: <b>048367351</b></p> <p>Current Occupant: <b>DUMKNER</b>                  Address: .....                  Phone: .....                  ACCESS <b>13-11-1984</b></p> <p><i>Access Report of 19/10/19 was found suitable for this.</i></p> <p>0-0 CROOKWELL RD. HEAD DOWN MAIN STREET TOWARDS BATHURST.                  5.1 TURN LEFT ONTO BOORAWA ROAD.                  9.9 TURN LEFT ONTO HAWTHORNES TREE ROAD.                  17.6 TURN RIGHT ONTO WHEED ROAD.                  20.8 PASS OWNERS HOUSE ON LEFT 'WOODBINE PARK'.                  21.1 TURN LEFT ONTO SAPPHIRE ROAD.                  21.5 TURN LEFT THROUGH IRON GATE AND FOLLOW TRACK, CIRCULE                  AROUND TO THE RIGHT.                  21.6 THROUGH WOODEN GATE + FOLLOW TRACK                  22.0 THROUGH GATE + FOLLOW TRACK                  22.4 THROUGH IRON GATE + FOLLOW TRACK                  22.5 TURN RIGHT OFF TRACK THROUGH IRON GATE + FOLLOW FENCE                  ON RIGHT.                  22.6 TURN LEFT AND FOLLOW FENCE UP OVER HILL.                  23.0 WINDUELLA CS (P)</p>	<p>Beacon Diagram</p> <p>This section to be completed by officer constructing pillar.</p> <p>Original station mark <del>found</del>/not found.</p> <p>Description of mark: .....</p> <p>Original beacon <del>found</del>/not found. <b>NOT FOUND</b></p> <p>Description of beacon: .....</p> <p>Height Top of Vane to Top Mark .....m.                  above below</p> <p>Height of mark .....m. above below G.L.                  rock/conc</p> <p>Diameter of Vane .....m. Height of Cairn .....m.</p> <p>Original Beacon has/has not been destroyed by me.</p>
--	--

<p>Date</p>	<p>Record of Station</p>
-------------	--------------------------