

CENTRAL MAPPING AUTHORITY

GEODETIC SURVEY OF N.S.W. *Batch Id: 1585*
GEODETIC STATION RECONNAISSANCE and MAINTENANCE REPORT

Description:

1. Cleared by lones bearing..... *360° M.* Note: Cross out word or words which do not apply
..... from Trig. Mast
2. Mast & Vanes have been painted white & black respectively ✓
3. The ~~station~~ pillar was ~~replaced/reconstructed~~/constructed on *23.20 Mch 1984*, dimensions now being:
Description of mark *Roof Top Plate* should be explicit, e.g., S/Steel Pillar Plate, Steel plug, Brass plug, Bolt, G.I. Pipe
Height of mark *1360* m. above ~~rock~~/concrete; Mark is *1460* m. above ~~EST.~~ CONCRETE ROOF.
Height of Top Vanes to Top ~~Mark~~/Pillar plate *0.96* m. Diameter of Vanes (vertical) *0.72* m.
Height of Cairn..... m. Diameter of Cairn..... m. Name Plate found/not found/placed.
Length of Mast..... m. (approximate if not unplied)
4. A. *Copper Nail* set in conc/~~rock~~ has been placed/~~found~~, bearing... *226°* M from ~~Mast~~/Pillar
5. A. *G.I. Nail* set in conc/~~rock~~ has been placed/~~found~~, bearing... *187°* M from ~~Mast~~/Pillar
6. A..... set in conc/~~rock~~ has been placed/~~found~~, bearing..... ° M from Mast/Plug/Pillar
7. A..... set in conc/~~rock~~ has been placed/~~found~~, bearing..... ° M from Mast/Plug/Pillar
- B. Action required:.....

STANDPOINT: *Roof Top Plate*

STANDPOINT: *Copper Nail*

Mark	Direction	Horiz. Distance	Height Difference	Mark	Direction	Horiz. Distance	Height Difference
<i>CURLEY (C)</i>	<i>0 00 00</i>		above standpt. below	<i>CURLEY (C)</i>	<i>0 00 00</i>		above standpt. below
<i>MEELBURRA (C)</i>	<i>16 31 20</i>		low above standpt.	<i>MEELBURRA (C)</i>	<i>16 31 20</i>		above standpt. below
<i>C.I. Nail</i>	<i>46 31 46</i>	<i>1458</i>	above standpt. below	<i>Roof Top Plate</i>	<i>284 11 20</i>	<i>2 136</i>	<i>1450</i>
<i>Copper Nail</i>	<i>104 09 50</i>	<i>2138</i>	above standpt. below	<i>C.I. Nail</i>	<i>333 35 60</i>	<i>1887</i>	<i>0.006</i>
			above standpt. below				above standpt. below
			above standpt. below				above standpt. below
			above standpt. below				above standpt. below


1407

Prepared by: *P. BOTT* 17.9.84

Checked:

Noted on U.T.M. Card

Checked *W.A. - 4.12.86*

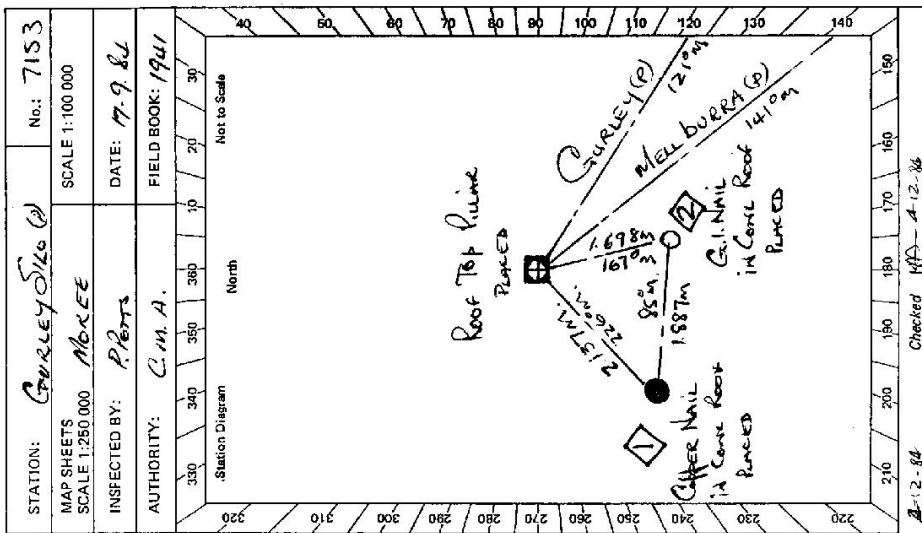

TS 2733 - 2 D. West, Government Printer


STATION Guirley Jct (P) TS-7153

Owner's Name: Clear Handling Authority Current Occupant: Key Responsible
 Address: Mc Winston Hemphong Address: From HERE Office
Industrial Drive 118EE One Days Notice Required
 Phone: 067 521110 Phone:

ACCESS

Access Report of 17.9.19 was found suitable/unsuitable.
FROM HERE RST OFFICE TRAVEL SOUTH ALONG NENEEL HIGHWAY
FOR APPROX 35 KM. TO GUIRLEY TOWN. GUIRLEY JCT (P)
IS ON LEFT OF HIGHWAY.

INDOOR TO ROOF 650MM DIAGONAL

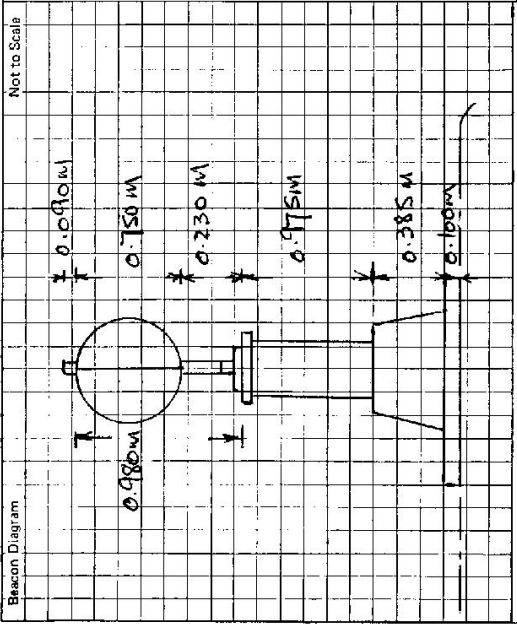

This section to be completed by officer constructing pillar.

Original station mark found/not found.

Description of mark: N.I. New Station

Original beacon found/not found.

Description of beacon:

Height Top of Vanes to Top Mark:m.

Height of mark:m. above rock/conem. below G.L.

Diameter of Vanes:m. Height of Calm:m.

Original Beacon has/has not been destroyed by me.

Date	Record of Station