

CENTRAL MAPPING AUTHORITY **Batch** GEODETIC SURVEY OF N.S.W. GEODETIC STATION RECONNAISSANCE and MAINTENANCE REPORT 1584

Description: Cleared by lanes bearing 360° ✓ Note: Cross out word or words which do not apply


- Mast & Vanes have been painted white & black respectively. ✓ from Trig. Mast
- The station/pillar was ~~replaced~~ constructed on 17^{th} August 19 81 , dimensions now being:
 Description of mark ~~Steel Top Plate~~ should be explicit, e.g., S/Steel Pillar Plate, Steel plug, Brass plug, Bolt, G.I. Pipe
 Height of mark 1.365 m. above ~~rock/concrete base~~ Mark is 1.465 m. above ~~rock/concrete base~~ 160 cm LEVEL
 Height of Top Vanes to Top Mark/Pillar plate 2.998 m. Diameter of Vanes (vertical) 0.750 m.
 Height of Cairn..... m. Diameter of Cairn..... m. Name Plate found/not found/placed.
 Length of Mast..... m. (approximate if not unipled)
- A. Copper Nail..... set in conc/rock has been placed/removed, bearing 298° M from ~~mark~~ Mark/Pillar
- A. Bolt..... set in conc/rock has been placed/removed, bearing 337° M from ~~mark~~ Mark/Pillar
- A..... set in conc/rock has been placed/removed, bearing..... M from Mast/Plug/Pillar
- A..... set in conc/rock has been placed/removed, bearing..... M from Mast/Plug/Pillar

8. Action required:..... STANDPOINT: Copper Nail

Mark	Direction	Horiz. Distance	Height Difference	Mark	Direction	Horiz. Distance	Height Difference
KAPURANG (A)	0 00 00	✓	above standpt.	KAPURANG (A)	0 00 00	✓	above standpt.
MALIBON (P)	171 20 00	✓	above standpt.	MALIBON (P)	171 20 00	✓	above standpt.
COPPER NAIL	171 34 30	2.309	above standpt.	BOLT	295 11 40	1.964	above standpt.
BOLT	224 52 25	2.046	above standpt.	MALIBON (P)	302 34 10	✓	above standpt.
MALIBON (P)	302 30 10	✓	above standpt.	ROCK TOP	351 40 00	2.310	above standpt.
			below				below
			below				below
			below				below

Prepared by: P. BORS 30.8.84 Noted on U.T.M. Card 44

Checked: 6/9/88

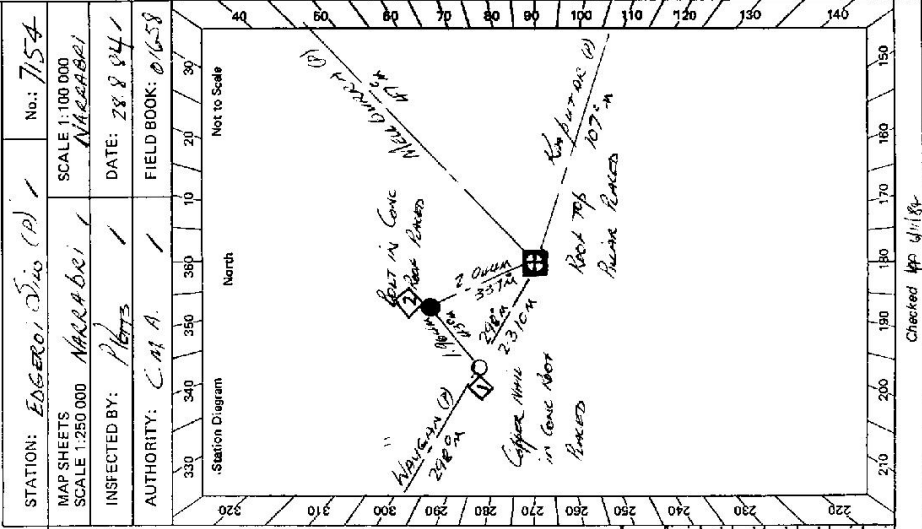

Checked: 4/11/84


1407

STATION **EDGEROI Silo (P) TS-7154**

Owner's Name: **P. H. A. MARRABRI OFFICE**
 Address: **MARRABRI OFFICE**
 Phone: **087 92 18 97 ONE DAYS NOTICE REQUIRED**
 Current Occupant:
 Address:

Access Report of **18/3/19** was found suitable/unsuitable.
ACCESS

TRAVEL NORTH FROM MARRABRI ON NEVELL HIGHWAY FOR APPROX 25 KM TO EDGEROI. EDGEROI SILO (P) IS ON LEFT OF HIGHWAY
A HOLE IN ROOF HAS BEEN PLACED & WATER PROOFED
A SAFETY RAIL HAS BEEN PLACED
A TRAMPOLIN to the roof is 650mm Dia. round.

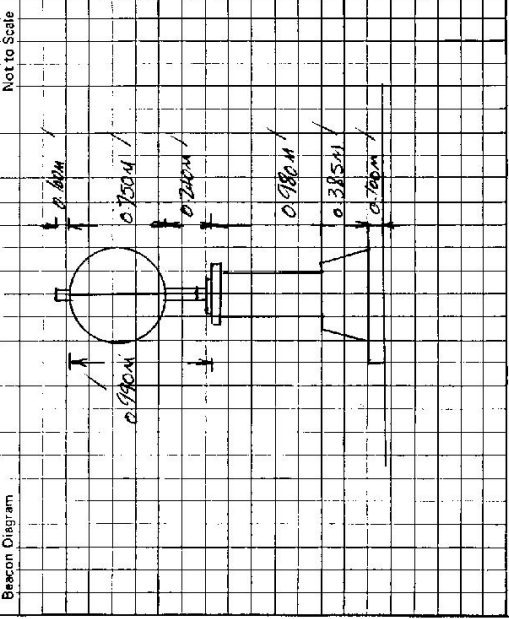

This section to be completed by officer constructing pillar.

Original station mark found/not found.
 Description of mark:
 Original beacon found/not found.
 Description of beacon:
 Height Top of Vanes to Top Markm.
 Height of markm. above G.L.
 Diameter of Vanesm. Height of Cairnm.
 Original Beacon has/has not been destroyed by me.

Date	Record of Station