

IS 7160
No: 2814


STATION: LIGHTHOUSE
MAP SHEET
SCALE 1:250 000
INSPECTED BY: A. GARSIDE
AUTHORITY: CMA

DATE: 4-9-82
FIELD BOOK: 2011

CENTRAL MAPPING AUTHORITY
GEODETTIC SURVEY OF N.S.W.
GEODETTIC STATION RECONNAISSANCE and MAINTENANCE REPORT

Description: Note: Cross out word or words which do not apply

1. Cleared by lanes bearing..... from Trig. Mast
2. Mast & Vanes have been painted white & black respectively.
3. The station/pillar was unpiled/not unpiled/constructed on..... dimensions now being: 18....., dimensions now being: 18....., dimensions now being: 18.....
- Description of mark..... should be explicit, e.g., S/Steel Pillar Plate, Steel plug, Brass plug, Bolt, G.I. Pipe
- Height of mark.....m. ^{above} rock/concrete; Mark is.....m. ^{above} G.L.
- Height of Top Vanes to Top Mark/Pillar plate.....m. ^{ONLY} Diameter of Vanes (vertical).....m.
- Height of Cairn.....m. Diameter of Cairn.....m. Name Plate found/not found/placed.
- Length of Mast.....m. (approximate if not unpiled)
4. A..... set in conc/rock ~~has been placed/found~~, bearing.....° M from Mast/Plug/Pillar
5. A..... set in conc/rock has been placed/found, bearing.....° M from Mast/Plug/Pillar
6. A..... set in conc/rock has been placed/found, bearing.....° M from Mast/Plug/Pillar
7. A..... set in conc/rock has been placed/found, bearing.....° M from Mast/Plug/Pillar
8. Action required:..... See 55/11/1034

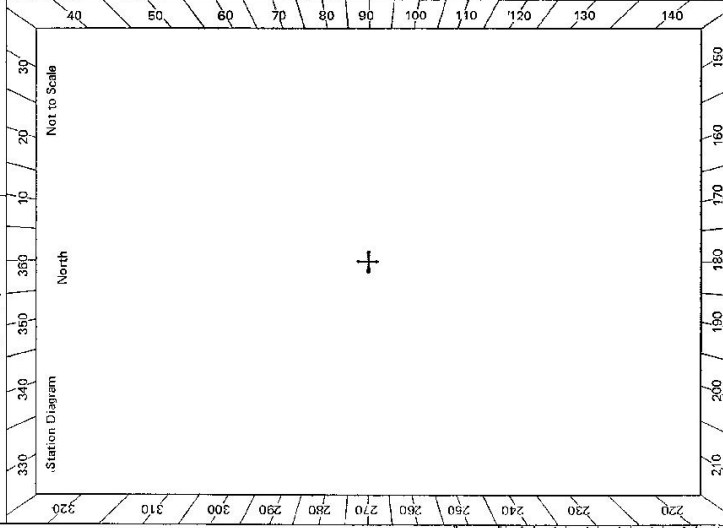

STANDPOINT:			
Mark	Direction	Horiz. Distance	Height Difference
			above standpt.
			below standpt.
			above standpt.
			below standpt.
Prepared by: *9/ed* Checked: *W. H. H. H. H.*
Noted on U.T.M. Card

CENTRAL MAPPING AUTHORITY

GEODETIC SURVEY OF N.S.W.

GEODETIC STATION RECONNAISSANCE and MAINTENANCE REPORT

Description:

1. Cleared by lanes bearing 360° *except for stone pillars to West & South* from Trig. Mast

2. Mast & Vanes have been painted white & black respectively.

3. The station/pillar was unpiled/not unpiled/constructed on 2.3 m 19.54 m, dimensions now being:

Description of mark **SK PILLAR** should be explicit, e.g., S/Steel Pillar Plate, Steel plug, Base plug, Bolt, G.I. Pipe

Height of mark 1.320 m. *above* rock/concrete; Mark is 1.510 m. *above* G.L.

Height of Top Vanes to Top Mark/Pillar plate 1.420 m. Diameter of Vanes (vertical) 0.755 m.

Height of Cairn 0 m. Diameter of Cairn 0 m. Name Plate found/not found/placed.

Length of Mast 0 m. (approximate if not unpiled)

4. A. **C.U. NAIL** set in conc/rock has been placed/found, bearing 315° 0 M from Mast/Plug/Pillar

5. A. **G.I. PIPE** set in conc/rock has been placed/found, bearing 258° 0 M from Mast/Plug/Pillar

6. A. set in conc/rock has been placed/found, bearing 0° M from Mast/Plug/Pillar

7. A. set in conc/rock has been placed/found, bearing 0° M from Mast/Plug/Pillar

8. Action required:

STANDPOINT: PILLAR		STANDPOINT: TRIG. PLUG	
Mark	Direction	Horiz. Distance	Height Difference
RURAK (GS)	$0 00 00$		above standpt.
G.I. PIPE	$134 02 50$	3.275	below standpt.
HURRICANE HILL (P)	$165 16 40$	1.604	above standpt.
TRIG. PLUG	$187 33 40$	6.591	below standpt.
C.U. NAIL	$194 12 50$	2.926	above standpt.
ISOLATION			below standpt.

Prepared by: *g 701*

Checked: *15*

Noted on U.T.M. Card

sr2733-1

STATION: LIGHTHOUSE No: 7160
 MAP SHEET SCALE 1:250 000
 INSPECTED BY: G. CARD DATE: 24.8.84
 AUTHORITY: C.M.A. FIELD BOOK: C.378

Station Diagram
 North
 Not to Scale

Checked

GS 24

STATION LIGHT HOUSE (P) TS 7160

Owner's Name: R.S. F.R. BLUNT
 Address: WELLING GROVE STATION
 Phone: (067) 336 771

Current Occupant:
 Address:
 Phone:

ACCESS

Access Report of 21/8/1988 was found suitable/unsuitable.

- 0.00 P.O. GLEN INNES NORTH IN GRAY ST.
- 0.16 TURN LEFT TOWARDS INNERELL
- 1.35 TURN RIGHT TOWARDS EMMAVILLE - BONSHAW
- 2.38 TURN LEFT TOWARDS BONSHAW
- 18.35 PASS ROAD TO WELLING GROVE ON LEFT
- 24.20 PASS GRID ON LEFT TO OWNERS HOUSE
- 24.25 WELLING GROVE CREEK
- 25.90 TURN LEFT ONTO TRACK OPPOSITE MAILBOX "GLEN ROWAN"
- 27.37 TRACK GOES BACK THE WAY YOU CAME
- 27.52 GATE FOLLOW TRACK AROUND CONTOUR BANKS
- 27.86 GATE FORA FOLLOW FANT TRACK
- 28.43 TURN RIGHT AT GATE, CROSS GULLY MAKE OWN WAY UP SOUTHERN SIDE OF HILL.
- 28.82


29.54 LIGHT HOUSE G.S.

DAY ACCESS ONLY FROM 28.82.

Record of Station

Date

Sr 2733-2 D. West, Government Printer

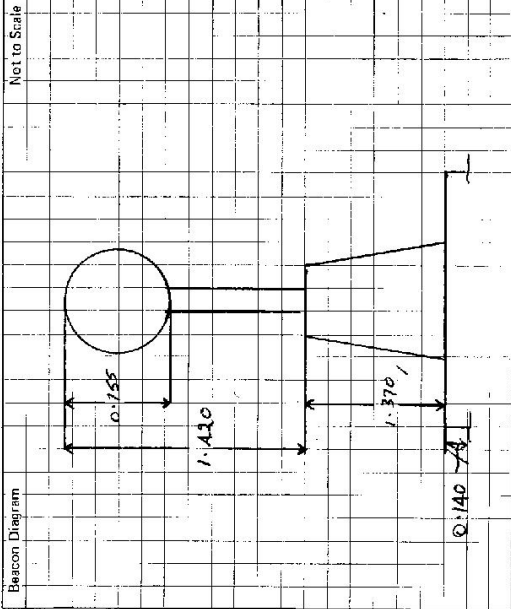

This section to be completed by officer constructing pillar.

Original station mark found/lost/removed.

Description of mark: BOTTLE IN CONC

Original beacon found/lost/removed.

Description of beacon: CAIRN POLE IN DISK

Height Top of Vanes to Top Mark: 3.035 m.

Height of mark: 1.140 m. above G.L. below

Diameter of Vanes: 0.155 m. Height of Cairn: 0.800 m.

Original Beacon has been destroyed by me.


LIGHTHOUSE [P] T.S. 7160

Access report as at 03/11/97

Good GPS sky.

All distances in kilometres.

- 0.0 Glen Innes P.O. go north in Gray St.
- 0.16 Turn left towards Inverell.
- 1.35 Turn right towards Emmaville, Bonshaw.
- 2.4 Turn left towards Bonshaw.
- 17.8 Pass road to "Wellingrove 5" on left.
- 23.5 Pass road to "Wellingrove" on left.
- 23.55 Pass grid on left to owner's house.
- 25.2 Wellingrove Creek.
- 26.6 Turn left onto track opposite "Glen Rowan" (no name on letter box). Track goes back the way you came.
- 26.7 Iron gate.
- 26.85 Left fork.
- 27.0 Fence corner on right.
- 27.2 Turn right through iron gate at power line, then turn left and follow faint track across paddock.
- 27.8 Iron gate, **Don't go through** (can see trig from here), follow fence down to w'course.
Then (A) **If dry** - cross watercourse and follow fence, turn right and make your own way to top of hill, avoiding rock outcrops.
(B) **If wet** - Leave vehicle at watercourse and walk to top of hill (approx 10 mins.)


John J Tierney
Registered Surveyor
TransGrid