


7168

STATION: GUNDAMULDA No. 2361

MAP SHEET SCALE 1:250 000 MANILLA

INSPECTED BY: G. KEEP DATE: 25/9/80

AUTHORITY: C.M.A. FIELD BOOK:

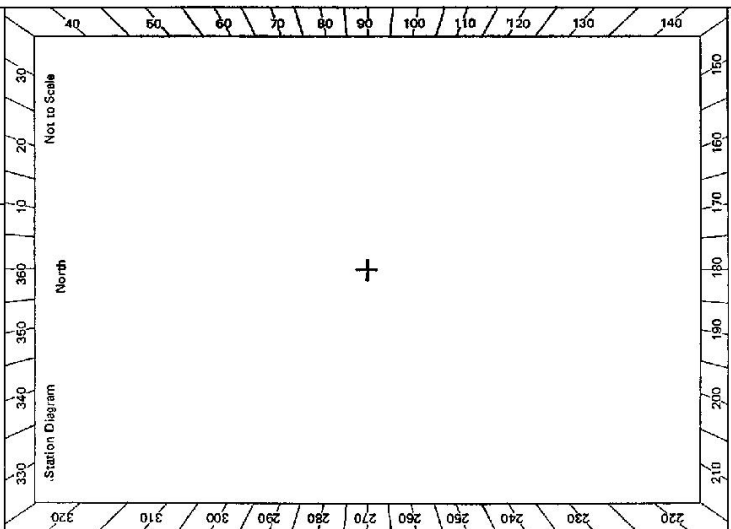

CENTRAL MAPPING AUTHORITY

GEODETTIC SURVEY OF N.S.W. GEODETTIC STATION RECONNAISSANCE and MAINTENANCE REPORT

Description: Note: Cross out word or words which do not apply

- 1. Cleared by lanes bearing..... from Trig. Mast
- 2. Mast & Vanes have been painted white & black respectively.....
- 3. The station/pillar was unpiled/not unpiled/constructed on..... 19....., dimensions now being: Description of mark..... should be explicit, e.g., S/Steel Pillar Plate, Steel plug, Brass plug, Bolt, G.I. Pipe
- Height of mark.....m. above below rock/concrete; Mark is.....m. above below G.L.
- Height of Top Vanes to Top Mark/Pillar plate.....m. Diameter of Vanes (vertical).....m.
- Height of Cairn.....m. Diameter of Cairn.....m. Name Plate found/not found/placed.
- Length of Mast.....m. (approximate if not unpiled)
- 4. A..... set in conc/rock has been placed/found, bearing.....° M from Mast/Plug/Pillar
- 5. A..... set in conc/rock has been placed/found, bearing.....° M from Mast/Plug/Pillar
- 6. A..... set in conc/rock has been placed/found, bearing.....° M from Mast/Plug/Pillar
- 7. A..... set in conc/rock has been placed/found, bearing.....° M from Mast/Plug/Pillar
- 8. Action required: Needs painting black and white. Needs clearing NW to NE

STANDPOINT:			
Mark	Direction	Horiz. Distance	Height Difference
			above standpt.
			below standpt.
			above standpt.
			below standpt.
Prepared by: G. Keep 8/10/80 Checked: G. Kepp 25/12/80 Noted on U.T.M. Card

TS 7168

STATION: GUADAMUZA


MAP SHEET SCALE 1:250 000

INSPECTED BY: A CARSIDE

DATE: 7-7-82

AUTHORITY: CMA

FIELD BOOK: 2007

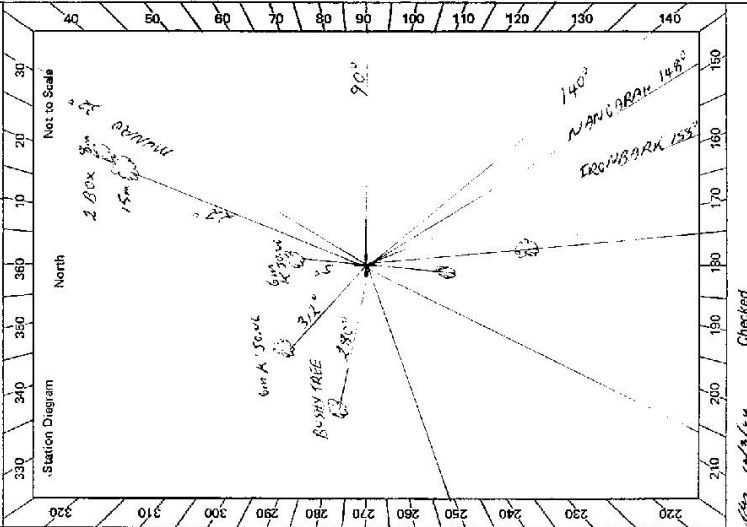

GEODETIC STATION RECONNAISSANCE and MAINTENANCE REPORT

Description:

1. Cleared by lanes bearing 360° ~~was emptied~~ *see sketch for details* ~~from Trig, Mast~~

2. Mast & Vanes have been painted white & black respectively.

3. The station/pillar ~~was emptied~~/not unpiled/constructed on 7.7×19.8 dimensions now being:

Description of mark ~~should be explicit, e.g., S/Steel Pillar Plate, Steel plug, Brass plug, Bolt, G.I. Pipe~~

Height of mark ~~above~~ rock/concrete: Mark is ~~above~~ 0.1 m. below G.L.

Height of Top Vanes to Top Mark/Pillar plate ~~.....m. Diameter of Vanes (vertical).....m.~~

Height of Cairn ~~.....m. Diameter of Cairn.....m. Name Plate found/not found/placed.~~

Length of Mast 4 ~~.....m. (approximate if not unplied)~~

4. A 5.5 set in conc/rock has been placed/found, bearing 90° M from Mast/Plug/Pillar

5. A 1 set in conc/rock has been placed/found, bearing 140° M from Mast/Plug/Pillar

6. A 1 set in conc/rock has been placed/found, bearing 149° M from Mast/Plug/Pillar

7. A 1 set in conc/rock has been placed/found, bearing 153° M from Mast/Plug/Pillar

8. Action required: *Construct concrete pillar. Fall of pillar. No more trees left standing*


STANDPOINT:

Mark	Direction	Horiz. Distance	Height Difference	Mark	Direction	Horiz. Distance	Height Difference
			above standpt.				above standpt.
			below standpt.				below standpt.
			above standpt.				above standpt.
			below standpt.				below standpt.
Prepared by: *AbdGoniele 23/82* Checked:

Noted on U.T.M. Card *AbdGoniele 23/82* Checked

STATION	GAWANULLA 75 7168		
Owner's Name: <i>Mr. J.R. Whitfield</i>	Current Occupant:	Address:	
Address: <i>Towarra</i>			
Phone: <i>067 833112</i>		Phone:	
ACCESS			
Access Report of <i>1.1.1988</i> was found suitable/unsuitable.			
0-0	<i>At 'Keezel' locality, on Inverell-Bingara Rd. 30km East of Bingara. Take Towarra Road to south.</i>		
5-7	<i>Cross numerous grids.</i>		
14-6	<i>Pass road on right.</i>		
15-0	<i>Grid. "Moona-meena"</i>		
15-4	<i>Take right fork.</i>		
15-5	<i>Grid. "Towarra"</i>		
15-8	<i>Cross creek.</i>		
15-9	<i>Pass grid to house on left.</i>		
16-4	<i>Take right fork.</i>		
17-0	<i>Iron gate.</i>		
17-03	<i>Pass cottage on right.</i>		
17-6	<i>Iron gate.</i>		
17-9	<i>Iron gate.</i>		
19-3	<i>Pass tracks on left.</i>		
19-6	<i>Iron gate.</i>		
20-05	<i>Turn right at end of fence.</i>		
20-2	<i>Iron gate.</i>		
21-85	<i>Iron gate. Yards on left. Head towards salt lick on right, and make own way along ridge.</i>		
Date	Record of Station		
	<i>200m walk to A</i>		

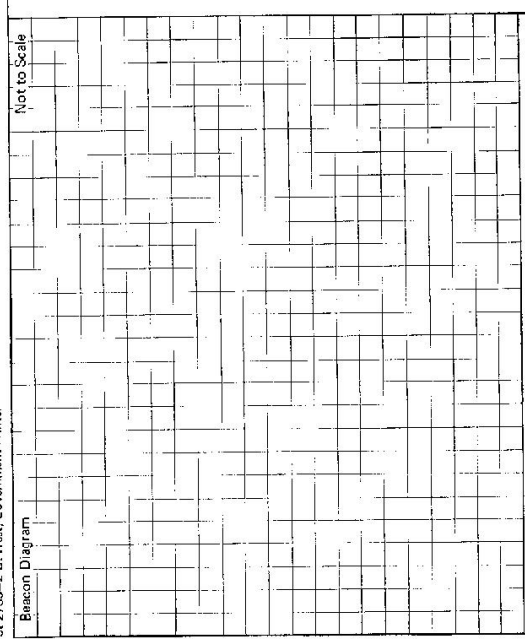

This section to be completed by officer constructing pillar.

Original station mark found/not found.

Description of mark:

Original beacon found/not found.

Description of beacon:

Height Top of Vanes to Top Mark.....m.

Height of mark.....m. above rock/conc.....m. below G.L.

Diameter of Vanesm. Height of Cairnm.

Original Beacon has/has not been destroyed by me.

61 2735-2 D. West, Government Printer

CENTRAL MAPPING AUTHORITY

GEODETIC SURVEY OF N.S.W.

GEODETIC STATION RECONNAISSANCE and MAINTENANCE REPORT

Description:

1. Cleared by ~~tree~~ ~~bearing~~ To ~~PERMANENT~~ ~~2400~~ ~~°~~ from Trig. Mast

2. Mast & Vanes have been painted white & black respectively. ✓

3. The station/pillar was ~~replaced/reconstructed~~/constructed on ~~13~~ ~~10~~ ~~19.84~~ dimensions now being:

Description of mark ~~set~~ ~~Steel Pillar Plate~~ would be explicit, e.g., S/Steel Pillar Plate, Steel plug, Brass plug, Bolt, G.I. Pipe

Height of mark ~~1.37~~ ~~m.~~ ~~above~~ ~~rock/concrete~~; ✓ Mark is ~~1.51~~ ~~m.~~ ~~above~~ ~~G.L.~~

Height of Top Vanes to Top ~~Mark~~/Pillar plate ~~4.45~~ ~~m.~~ ✓ Diameter of Vanes (vertical) ~~1.50~~ ~~m.~~

Height of Cairn ~~1.54~~ ~~m.~~ ✓ Diameter of Cairn ~~1.54~~ ~~m.~~ Name Plate ~~found~~/not ~~found~~/placed.

Length of Mast ~~1.54~~ ~~m.~~ (approximate if not supplied)

① 4. ~~AST~~/~~Steel~~/~~Pin~~ set in conc/~~rock~~ has been placed/found, bearing ~~131~~ ~~°~~ ~~M~~ from ~~Macintyre~~/Pillar

② 5. ~~A~~/~~S.S.M.~~ set in conc/~~rock~~ has been placed/found, bearing ~~94~~ ~~°~~ ~~M~~ from ~~Macintyre~~/Pillar

6. ~~A~~ set in conc/~~rock~~ has been placed/found, bearing ~~131~~ ~~°~~ ~~M~~ from Mast/Plug/Pillar

7. ~~A~~ set in conc/~~rock~~ has been placed/found, bearing ~~131~~ ~~°~~ ~~M~~ from Mast/Plug/Pillar


8. Action required: ~~None~~

STANDPOINT: Concrete Pillar		STANDPOINT: ST/STEEL TRIG. PIN	
Mark	Direction	Horiz. Distance	Height Difference
MACINTYRE G.S.(P)	0 00 00	✓	above standpt.
MUNRO G.S.(P)	129 45 07	✓	above standpt.
S.S.M.	198 41 08	3.637	1.515 below
ST/ST. PIN	235 51 47	2.165	1.515 below
IRONBARK G.S.(P)	266 01 52	✓	above standpt.
GULF CREEK G.S.(P)	315 10 31	✓	above standpt.

Prepared by: D. J. KAIN.

Checked: AS 29/1/85

Noted on U.T.M. Card 144

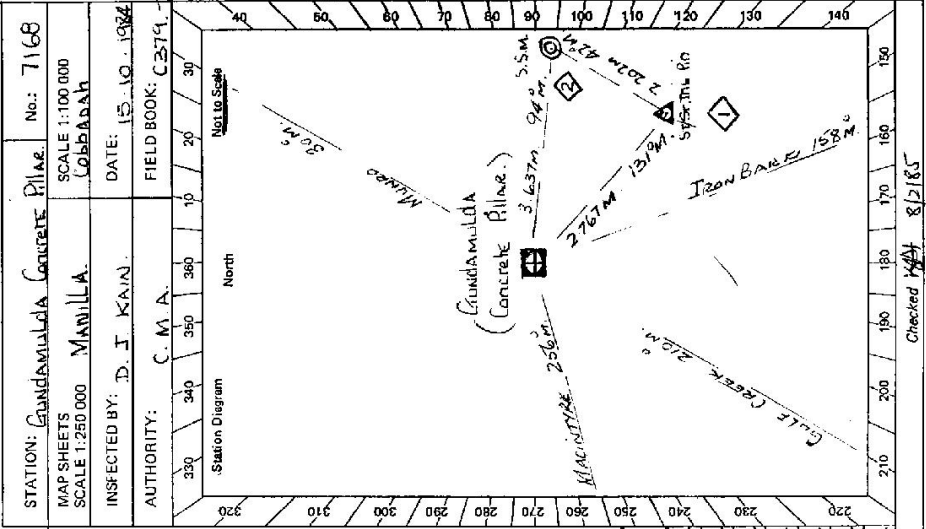


Checked: DJK 8/2/85

TS
STATION Groundmunda Concrete Pillar. 7168

FREEHOLD
Owner's Name: MR. J. R. WHITEFIELD
Address: TOWARRA
Phone: (0667) 83 3112
Current Occupant: OWNER
Address:
Phone: ACCESS 15-10-1984

Access Report of 17.11.82 was found unsuitable/unsuitable.
KMS. UNDEVELOPED DAMP RD
FEATURE
AT KEERA LOCALITY ON INVERELL / BINGARA ROAD 30 KMS
EAST OF BINGARA TAKE TOWARDS NOONAMBEEN ROAD TO SOUTH.

CROSS NUMEROUS GRIDS.
PASS CRUMMARY ROAD ON RIGHT.
12.51 TAKE RIGHT FORK.
14.24 GRID NOONAMBEEN TAKE RIGHT FORK.
15.05 GRID TOWARRA.
15.53 PASS GRID TO OWNERS HOUSE ON LEFT. (CALL IN.)
15.59 TAKE RIGHT FORK. (MAIN TRACK)
15.84 TAKE RIGHT FORK. 16.66 IRON GATE (NEXT TO DAM)
16.81 IRON GATE.
16.89 PASS GATE ON RIGHT.
17.22 IRON GATE. 17.52 IRON GATE.
18.98 TAKE RIGHT FORK.
19.27 TURN RIGHT AT END OF FENCE. 19.80 IRON GATE.
19.65 IRON GATE.
21.39 IRON GATE YARDS ON LEFT. (TRACK GOES STRAIGHT AHEAD)
21.67 TURN RIGHT OFF TRACK AT LARGE IRON BARK TREE FOLLOW WHEEL MARKS ACROSS GULLY UP INTO SADDLE AND THEN ONTO RIDGE IN A NORTHERLY DIRECTION TO LOOSE ROCKY KNOPS OF ACTUAL TRIG HILL AT 22.72 KMS. WINCHING REQUIRED FROM HERE OR 200 METRE WALK TO STATION.

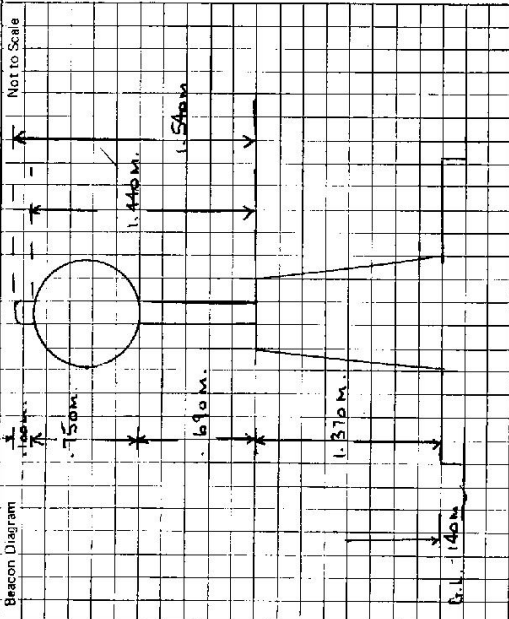

This section to be completed by officer constructing pillar.

Original station mark found/~~not found~~.
Description of mark: STAINLESS STEEL PIN
Original beacon found/~~not found~~.
Description of beacon: Cairn wood & Vane
Height Top of Vane to Top Mark: 2.765 m.
Height of mark: 0.45 above at above G.L.
Diameter of Vane: 1.010 m. Height of Cairn: 1.020 m.
Original Beacon has/~~has not~~ been destroyed by mtg.

Date _____ Record of Station