

CENTRAL MAPPING AUTHORITY

GEODETTIC SURVEY OF N.S.W.


GEODETTIC STATION RECONNAISSANCE and MAINTENANCE REPORT

Description:

1. Cleared by lanes bearing $10^{\circ} 19' M$, $105^{\circ} 10' S$, $112^{\circ} M$, $129^{\circ} 55' W$, $123^{\circ} 15' W$, $123^{\circ} 15' W$ from Trig. Mast $217^{\circ} - 223^{\circ} M$, $239^{\circ} - 242^{\circ} M$, $270^{\circ} - 273^{\circ} W$, $277^{\circ} - 306^{\circ} W$, $320^{\circ} - 346^{\circ} W$.
Note: Cross out words or figures which do not apply
2. Mast & Vanes have been painted white & black respectively. ✓
3. The ~~station~~ pillar was ~~used~~ constructed on 1.2 m. 1984 , dimensions now being:
Description of mark: ~~Steel~~ Steel Pillar Plate. ~~Steel~~ Steel plug, Bolt, G.I. Pipe
Height of mark 3.15 m. above ~~rock~~ rock/concrete; Mark is 1.5 m. above G.L.
Height of Top Vanes to Top ~~Mast~~ Mast /Pillar plate 4.45 m. Diameter of Vanes (vertical) 150 m.
Height of Cairn $.....$ m. Diameter of Cairn $.....$ m. Name Plate ~~found~~ /not found/placed.
Length of Mast 5.45 m. (~~approximate if not specified~~)
4. A. ~~Concrete~~ Concrete ~~Nail~~ set in conc/rock has been placed/~~found~~, bearing $115^{\circ} M$ from ~~Mast/Plug~~ Plug /Pillar
5. A. G.I. Pipe set in conc/rock has been placed/~~found~~, bearing $288^{\circ} M$ from ~~Mast/Plug~~ Plug /Pillar
6. A. ~~.....~~ set in conc/rock has been placed/~~found~~, bearing $.....^{\circ} M$ from Mast/Plug /Pillar
7. A. ~~.....~~ set in conc/rock has been placed/~~found~~, bearing $.....^{\circ} M$ from Mast/Plug /Pillar
8. Action required: ~~.....~~


STANDPOINT: Concrete Pillar			STANDPOINT: Copper Nail			
Mark	Direction	Horiz. Distance	Height Difference	Direction	Horiz. Distance	Height Difference
NAUMEA (P)	$0^{\circ} 00' 00''$		above standpt.	$0^{\circ} 00' 00''$		above standpt.
G.I. PIPE	$105^{\circ} 06' 57''$	3.54	below standpt.	$133^{\circ} 59' 13''$	5.42	below standpt.
MALROY G.S.	$190^{\circ} 12' 08''$		above standpt.	$170^{\circ} 30' 27''$	2.87	above standpt.
DINGGA G.S.	$287^{\circ} 43' 25''$		above standpt.	$190^{\circ} 11' 55''$		above standpt.
MALINTIRE (P)	$313^{\circ} 58' 18''$		below standpt.	$287^{\circ} 42' 34''$		below standpt.
COPPER NAIL	$350^{\circ} 29' 51''$	2.872	below standpt.	NO VISION STOPED!		below standpt.

Prepared by: D. J. KAIN Checked: AS 29/1/85 Noted on U.T.M. Card 198

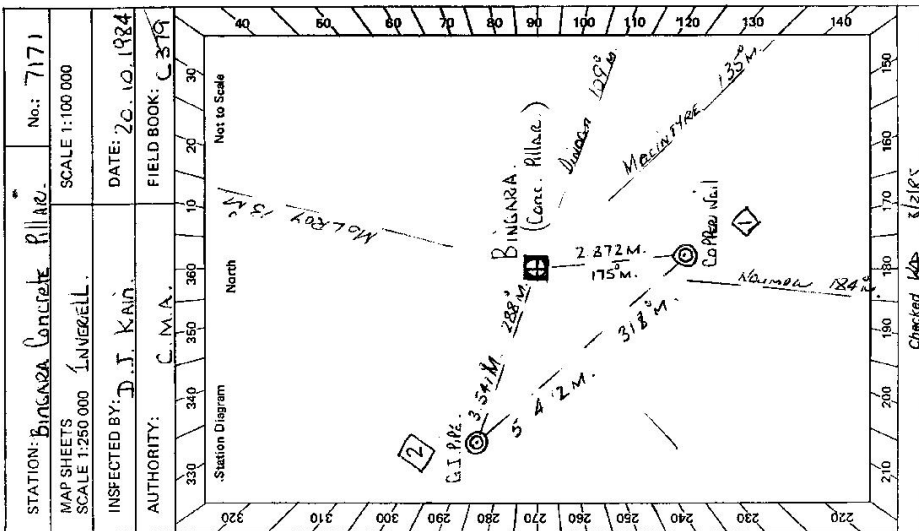

Checked HP 8/2/85

6: 2733-2 D. West, Government Printer

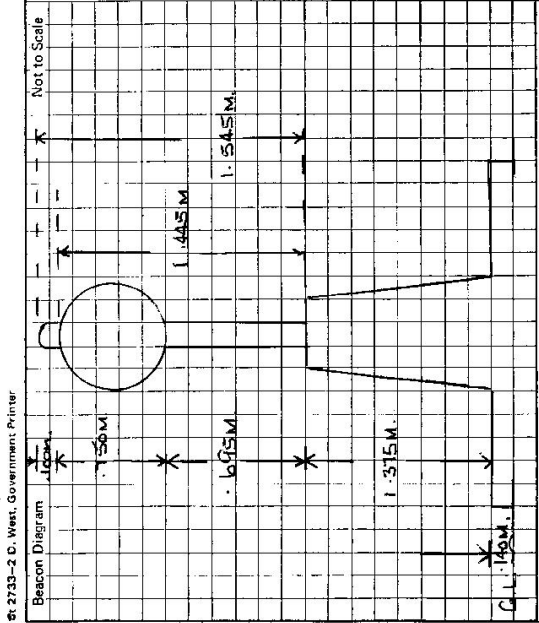

This section to be completed by officer constructing pillar.

Original station mark found/not found.

Description of mark: NEW

Original beacon found/not found.

Description of beacon: NEW

Height Top of Vanes to Top Mark NO m.

Height of mark NO m. above below G.L.

Diameter of Vanes NO m.

Original Beacon has/has not been destroyed by me.

FREE HOLD LAND MR. CAROL CLASER.
Owner's Name: MR. CAROL CLASER.
Address: AMAROO PARK.
ANIMATING ROAD, ANIMATING ROVER.
Phone: (02) 679 1251

STATION BINGARA Concrete Pillar 7171

Contact Manager MR. JOHN EDWARDS
Address: 78 Cunningham Street,
Phone: (067) 241 0357
"ZABA" (067) 241 376

ACCESS "ZABA" (067) 241 376

Access Report of 10/10/1984 was found suitable/unsuitable.

KLMS.

- 0.00 AT BINGARA POST OFFICE TRAVEL TOWARD BARRABA.
- 0.18 TURN RIGHT TO "NORABRI" (CUNNINGHAM STREET.)
- 8.76 PASS SAFETY RAMP ON L.H.S. "ZABA"
- 10.43 TURN LEFT THROUGH IRON GATE "Z"
- 10.65 THROUGH IRON GATE "Z"
- 11.03 PASS TRACK ON R.H.S.
- 11.38 TAKE TRACK ON REAR OF HOMESTEAD. (CALL IN)
- 11.51 PASS TRACK ON R.H.S AND PASS MACHINERY SHED ON R.H.S.
- 11.75 THROUGH DOUBLE IRON GATES.
- 12.12 THROUGH DOUBLE IRON GATES.
- 13.22 THROUGH DOUBLE IRON GATES.
- 14.10 THROUGH DOUBLE IRON GATES.
- 14.58 THROUGH DOUBLE IRON GATES.
- 15.27 TRACK GOES AROUND DAM AND BANK.
- 15.77 THROUGH DOUBLE IRON GATES, TURN LEFT AND FOLLOW
- 16.58 THROUGH DOUBLE IRON GATES, TRACK ALONG FENCE.

17.91 THROUGH IRON GATE AT FENCE CORNER THEN TRACK (CROSSES OLD FENCE.)

18.86 BINGARA Concrete Pillar.

{ 17.91 TO 18.86 KLMS. VARIABLE TRACK ROUGHLY FOLLOWS TO EAST OF OLD FENCE BEFORE MOVING INTO LONG GRASS AT TOP OF HILL.

Date

Record of Station

Batch Id: 1569

LAND INFORMATION CENTRE

GEODETIC SURVEY OF A.S.W.

GEODETIC STATION RECONNAISSANCE and MAINTENANCE REPORT

STATION: **BINGARA (Pillar)** No.: **7171**

MAP SHEET
SCALE 1:250 000


INSPECTED BY: **D. J. Kain**

DATE: **19.3.1991**

AUTHORITY: **L.I.C.**
FIELD BOOK: **NIL**

Description: *Note: Cross out word or words which do not apply*

1. Cleared by Janes bearing..... **Station was cleared for G.P.S. from Trig. Mast**
2. Mast & Vanes have been painted white & black respectively.
3. The station/pillar was unpiled/not unpiled/constructed on..... **19.....**, dimensions now being:
 - Description of mark..... should be explicit, e.g., S/Steel Pillar Plate, Steel plug, Brass plug, Bolt, G.I. Pipe
 - Height of mark.....m. ^{above} rock/concrete; Mark is.....m. ^{above} G.L.
 - Height of Top Vanes to Top Mark/Pillar platem. Diameter of Vanes (vertical).....m.
 - Height of Cairn.....m. Diameter of Cairn.....m. Name Plate found/not found/placed.
 - Length of Mastm. (approximate if not unpiled)
4. A.....set in conc/rock has been placed/found, bearing.....°M from Mast/Plug/Pillar
5. A.....set in conc/rock has been placed/found, bearing.....°M from Mast/Plug/Pillar
6. A.....set in conc/rock has been placed/found, bearing.....°M from Mast/Plug/Pillar
7. A.....set in conc/rock has been placed/found, bearing.....°M from Mast/Plug/Pillar
8. Action required:.....

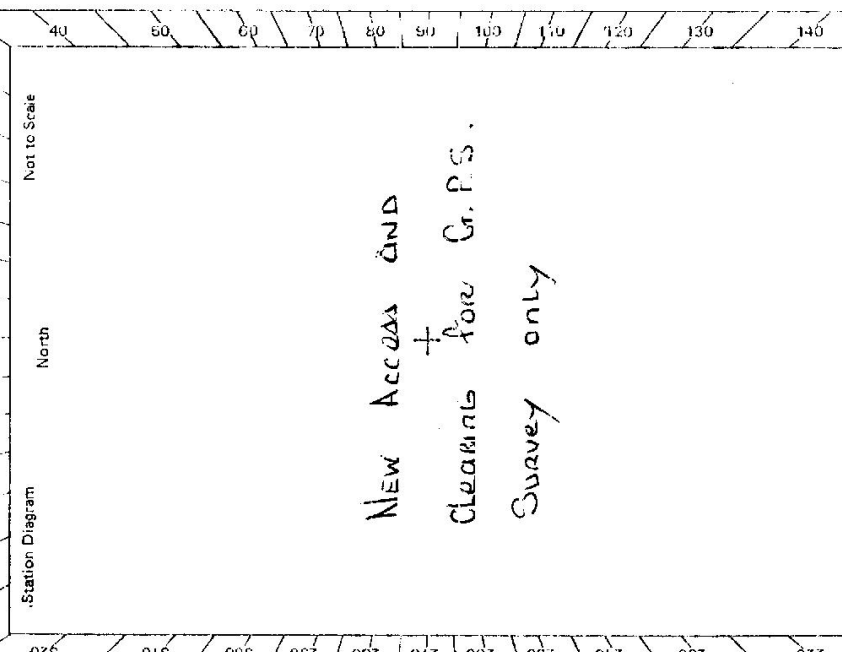

STANDPOINT:			
Mark	Direction	Horiz. Distance	Height Difference
			above standpt.
			below
			above standpt.
			below
Prepared by: **D. Kain** Checked: **Noted on U.T.M. Card**

