

GEODETTIC SURVEY OF N.S.M.

CENTRAL MAPPING AUTHORITY


GEODETTIC STATION RECONNAISSANCE and MAINTENANCE REPORT

- Description:
- Cleared by lanes bearing 360° ✓ *Note: Cross out word or words which do not apply*
 - Mast & Vanes have been painted white & black respectively, from Trig. Mast
 - The station/pillar was ~~replaced~~ ~~not replaced~~ /constructed on 10 Nov. 1984, dimensions now being: Description of mark PIVOT PLATE should be explicit, e.g. S/Steel Pillar Plate, Steel plug, Brass plug, Bolt, G.I. Pipe
Height of mark 1.370 m. ^{above} ~~below~~ rock/concrete; Mark is 530 m. ^{above} ~~below~~ G.L.
Height of Top Vanes to Top Mark/Pillar plate 1.425 m. Diameter of Vanes (vertical) 0.760 m.
Height of Cairn..... m. Diameter of Cairn..... m. Name Plate NOT placed.
Length of Mast..... m. (approximate if not unplied)
 - BRASS TRIG PIN set in ~~rock~~ ~~rock~~ /found, bearing 265 °M from Mast/Plug/Pillar
 - COPPER NAIL set in conc/rock has been placed/found, bearing 175 °M from Mast/Plug/Pillar
 - A..... set in conc/rock has been placed/found, bearing..... °M from Mast/Plug/Pillar
 - A..... set in conc/rock has been placed/found, bearing..... °M from Mast/Plug/Pillar


Action required:

STANDPOINT: SIS PILLAR PLATE		STANDPOINT: BRASS TRIG PIN	
Mark	Direction	Horiz. Distance	Height Difference
WAITMAN C.S.P	0 00 00	0 00 00	above standpt.
COPPER NAIL	166 41 20	5.227	below standpt.
BRASS TRIG PIN	256 09 10	4.092	below standpt.
NARRAWA C.S.P	300 07 45	3.000	below standpt.
WINDUVELLA C.S.P	316 00 35	3.160	below standpt.

Prepared by: LC Checked: MS 27/11. Noted on U.T.M. Card MS 21/12/95

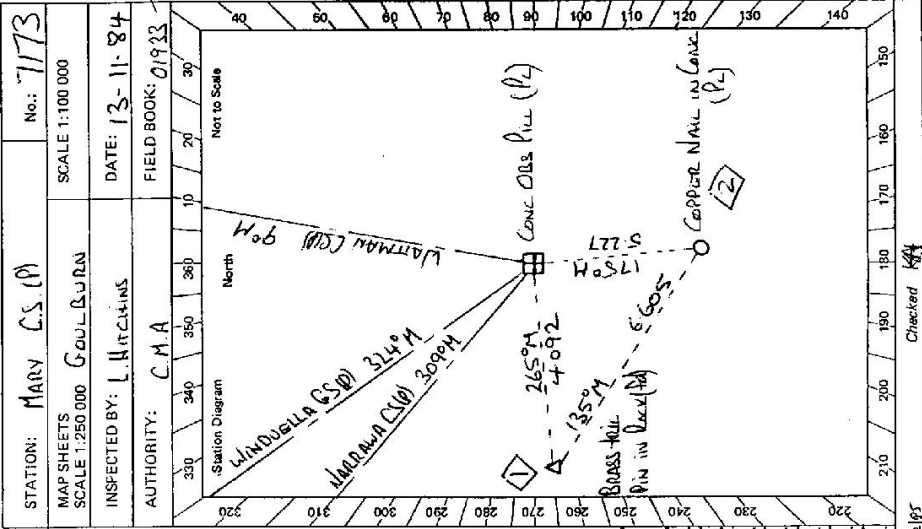

2733-2 D. West Government Printer

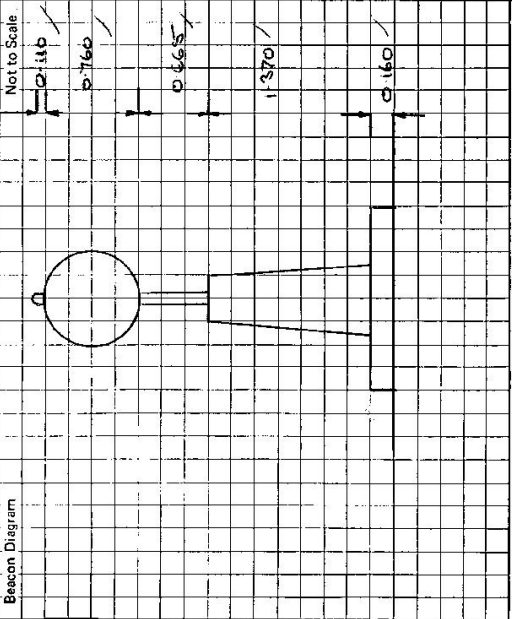

This section to be completed by officer constructing pillar.

Original station mark found/~~not found~~.....

Description of mark: ~~As follows~~ this Pillar in Rock.....

Original beacon found/~~not found~~.....

Description of beacon: ~~As follows~~ Chalked Cairn.....

Height Top of Vane to Top Mark m.

Height of mark 0.52m above rock/~~0.750m~~ below G.L.

Diameter of Vane 0.170 m. Height of Cairn m.

Original Beacon has ~~been~~ destroyed by me.

STATION

MARY CS (P) TS 7173

ACCESS OWNER: TO S FAISIA
 Current Occupation: "ASHWELL"
 Address: 30 DAL RANE
 Phone: 048 - 483139

Owner's Name: TO RESERVE No 10984
 Address: NO 10984
 Phone: 048 - 483139
TO S FAISIA

ACCESS 13-11-1984

Access Report of 13-11-1984 to was found not suitable for installation.

00 CROOKWELL PD HEAD TOWARDS BATHURST BRINDA.
 08 TURN LEFT ONTO CUNNING ROAD.
 12.95 PASS BOODWA ROAD ON RIGHT.
 13.2 TAKE CUNNING ROAD TO RIGHT.
 24.1 TURN LEFT TOWARDS COULBURN.
 24.9 TURN RIGHT AND FOLLOW TRACK BACK TO IRON GATE. OWNERS HOUSE IS 53 FURTHER ALONG COULBURN ROAD THEN TURN LEFT FOR I.O
 PROPERTY NAME "ASHWELL"
 25.05 THROUGH IRON GATE THEN TURN RIGHT AND FOLLOW FENCE.
 25.5 TURN LEFT AT FENCE CORNER AND FOLLOW FENCE UP HILL.
 26.1 THROUGH IRON GATE THEN VEER LEFT + FOLLOW TRACK UP TO TRIC.
 26.65 MARY CS (P)

* IN WEST CONDITIONS CONTINUE STRAIGHT AHEAD AT 25.05 AND TRAVEL AROUND HIGH SIDE OF Paddock, AND WATCH OUT FOR BOCCY SECTIONS.

Record of Station

Date

Date	Record of Station