


STATION: CUDGEN No.: 5000
 MAP SHEET SCALE 1:250 000 TWEED HEADS
 INSPECTED BY: D. KINLISIDE DATE: 25. 4. 80
 AUTHORITY: C.M.A. FIELD BOOK: 18 53

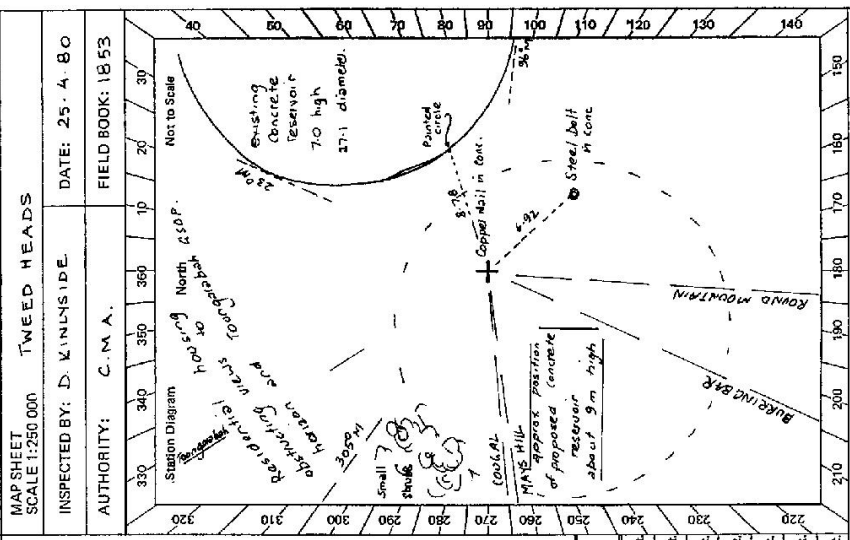

CENTRAL MAPPING AUTHORITY
 GEODETIC SURVEY OF NSW.
 GEODETIC STATION RECONNAISSANCE and MAINTENANCE REPORT

Description: Note: Cross out word or words which do not apply
 1. Cleared by lanes bearing. See diagram. from Trig, Mast
 2. Mast & Vanes have been painted white & black respectively.
 3. The station/pillar was unpiled/ret-unnished/constructed on 19 dimensions new being:
 Description of mark: Cu Nail should be explicit, e.g. S/Steel Pillar Plate, Steel plug, Brass plug, Bolt, G.I. Pipe
 Height of mark: 0.0 m. above below
 Height of Top Vanes to Top Mark/Pillar plate: m. Diameter of Vanes (vertical): m.
 Height of Cairn: m. Diameter of Cairn: m. Name Plate found/not found/placed.
 Length of Mast: m. (approximate if not supplied) Cairn, mast & vanes not found.
 4. A. Steel bolt set in conc/feek has been placed/round, bearing 130.0° M from Mast/Plug/Pillar Cu Nail
 5. A. Black Painted circle set in conc/feek has been placed/round, bearing 73.0° M from Mast/Plug/Pillar Cu Nail
 6. A. set in conc/rock has been placed/round, bearing 0° M from Mast/Plug/Pillar
 7. A. set in conc/rock has been placed/round, bearing 0° M from Mast/Plug/Pillar
 8. Action required: Construct pillar in position with new resin. which will be built by Tweed Shire Council, Murwillumbah, a found Dec 80

STANDPOINT: Copper Nail

Mark Required	Direction signified	Horiz. Distance	Height Difference	Mark	Direction	Horiz. Distance	Height Difference
MAYS HILL (hill)	263° M		above standpt				above standpt
ROUND MOUNTAIN	184° M		above standpt				above standpt
TOONGARABAH			below				below
OTHERS			below				below
COOGA hill	265° M		above standpt				above standpt
BUKINGBAR hill	204° M		above standpt				above standpt
			below				below

Prepared by: D. Kinlisside 13. 5. 80 Checked: 19/10/1980 Noted on U.T.M. Card
 Checked

GS 24

STATION C.U.D.G.E.N TS-7174							
<p>Owner's Name: <i>Tweed R. and Shire Council</i></p> <p>Address: <i>Timbulgam Road</i></p> <p>Phone: <i>72 229 933</i></p> <p>Current Occupant:</p> <p>Address:</p> <p>Phone:</p> <p>Access: <i>25-4-1980</i></p> <p>Access Report of: <i>24/4/1971 was found suitable/unsuitable, amended</i></p> <p>0-00 Kingscliff P.O heading north towards Tweed Heads</p> <p>0-09 Turn LEFT into Seaview Street</p> <p>0-36 Turn RIGHT into Rob Roy Crescent</p> <p>0-82 Turn LEFT into Gibson Street</p> <p>0-91 Turn RIGHT</p> <p>1-09 Reservoir on R.H.S.</p>	<p>Record of Station</p> <table border="1" style="width: 100%; border-collapse: collapse;"> <thead> <tr> <th style="width: 15%;">Date</th> <th>Record of Station</th> </tr> </thead> <tbody> <tr> <td style="text-align: center;">1-4-80</td> <td>Permission for access for construction of rooftop pily in conjunction with new reservoir approved verbally by John Henry Town Planning Dept. Tweed R. and Shire Council. <i>Planning Division approved.</i></td> </tr> <tr> <td style="text-align: center;">3/10/82</td> <td>Letter to Mack Shire written by CTS (S.S/10/82) Reply recd 10/10/82. <i>see 1574/82</i></td> </tr> </tbody> </table>	Date	Record of Station	1-4-80	Permission for access for construction of rooftop pily in conjunction with new reservoir approved verbally by John Henry Town Planning Dept. Tweed R. and Shire Council. <i>Planning Division approved.</i>	3/10/82	Letter to Mack Shire written by CTS (S.S/10/82) Reply recd 10/10/82. <i>see 1574/82</i>
Date	Record of Station						
1-4-80	Permission for access for construction of rooftop pily in conjunction with new reservoir approved verbally by John Henry Town Planning Dept. Tweed R. and Shire Council. <i>Planning Division approved.</i>						
3/10/82	Letter to Mack Shire written by CTS (S.S/10/82) Reply recd 10/10/82. <i>see 1574/82</i>						
<p>Beacon Diagram</p> <p>Not to Scale</p> <p>This section to be completed by offset constructing pillar.</p> <p>Original station mark found/not found.</p> <p>Description of mark:</p> <p>Original beacon found/not found.</p> <p>Description of beacon:</p> <p>Height Top of Vanes to Top Mark.....m.</p> <p>Height of mark.....m. above G.L. below</p> <p>Diameter of Vanesm. Height of Cairnm.</p> <p>Original Beacon has/has not been destroyed by me.</p>	<p>Station Information</p> <p>Owner's Name: <i>Tweed R. and Shire Council</i></p> <p>Address: <i>Timbulgam Road</i></p> <p>Phone: <i>72 229 933</i></p> <p>Current Occupant:</p> <p>Address:</p> <p>Phone:</p> <p>Access: <i>25-4-1980</i></p> <p>Access Report of: <i>24/4/1971 was found suitable/unsuitable, amended</i></p> <p>0-00 Kingscliff P.O heading north towards Tweed Heads</p> <p>0-09 Turn LEFT into Seaview Street</p> <p>0-36 Turn RIGHT into Rob Roy Crescent</p> <p>0-82 Turn LEFT into Gibson Street</p> <p>0-91 Turn RIGHT</p> <p>1-09 Reservoir on R.H.S.</p>						

TS 7174

CENTRAL MAPPING AUTHORITY

GEODETIC STATION RECONNAISSANCE and MAINTENANCE REPORT

Description:

Note: Cross out word or words which do not apply

1. Cleared by lanes bearing Q obstructed intermittently by housing from Trig. Mast + water reservoir from 805 M 4 56 M.
 2. ~~The station pillar was replaced by a concrete pillar with a diameter of 100 mm.~~
 3. The station pillar was replaced by a concrete pillar with a diameter of 100 mm. found 1981, dimensions now being 6 - 6.
- Description of mark Cu Nail could be explicit, e.g. S/Steel Pillar Plate, Steel plug, Brass plug, Bolt, G.I. Pipe
- Height of mark 0.0 m. above level concrete; Mark is 0.0 m. above G.L.
- Height of Top Vane to Top Mark of the plate 0 m. Diameter of Vane (vertical) 0 mm.
- Height of Vane 0 mm. Diameter of Vane (horizontal) 0 mm. Name Plate found not found placed cairn mast + vane not found
- Length of Mast 0 m. (approximate if not specified)
4. A Bolt in Kerb set in conc/rock has been placed found, bearing 140 ° M from Mast/Pillar/Plate cu nail
 5. A Spike in Kerb set in conc/rock has been placed found, bearing 184 ° M from Mast/Pillar/Plate cu nail
 6. A PM No 44431 set in conc/rock has been placed found, bearing 211 ° M from Mast/Pillar/Plate cu nail
 7. A Bolt in Conc set in conc/rock has been placed found, bearing 135 ° M from Mast/Pillar/Plate cu nail
 8. Action required: 0

STANDPOINT: Copper nail (5000-0) STANDPOINT: PM 44431 (5000-2)

Mark	Direction	Horiz. Distance	Height Difference	Mark	Direction	Horiz. Distance	Height Difference
ROUND MOUNTAIN (5931-0)	0° 00' 00"	0° 00' 00"	above standpt	ROUND MOUNTAIN (5931-0)	0° 00' 00"	0° 00' 00"	above standpt
PM 44431 (5000-2)	20° 51' 30"	33.818	2.458	MAYS HILL (6690-0)	79° 06' 14"	19.0614	above standpt
MAYS HILL (6690-0)	78° 52' 57"	6.925	0.014	Cu Nail in conc (5000-0)	200° 56' 24"	33.818	above standpt
Bolt in conc (5000-1)	313° 52' 30"	58.862	2.197	Bolt in conc (5000-1)	212° 31' 12"	31.760	above standpt
Bolt in Kerb (5000-4)	314° 33' 49"	46.929	2.253	Bolt in Kerb (5000-4)	288° 16' 32"	54.848	above standpt
Spike in Kerb (5000-3)	346° 11' 10"	46.929	2.253	Spike in Kerb (5000-3)	301° 05' 14"	27.116	above standpt

Prepared by 2110 Checked: 4/4/22 Noted on U.T.M. Card

STATION: CUDGEN No: 5000

MAP SHEET: Tweed Head's

SCALE: 1:250 000

INSPECTED BY: D. HALLS + C. ZAHOR DATE: 6-6-81

AUTHORITY: C.M.A. FIELD BOOK: 104

STANDPOINT: Bolt in conc. (5000-1)

Mark	Direction	Horiz. Distance	Height Difference
ROUND MTN (5931-0)	0° 00' 00"	0° 00' 00"	above standpt.
PM 44431 (5000-2)	32 24 08	31.760	2.444
MAYS HILL (6690-0)	78 52 28	6.925	0.014
Cu Nail in conc (5000-0)	33 50 00	6.925	0.014
Bolt in kerb (5000-4)	314 37 17	51.942	2.783
Spike in kerb (5000-3)	351 18 18	41.252	2.239

STANDPOINT: Spike in Kerb (5000-3)

Mark	Direction	Horiz. Distance	Height Difference
ROUND MTN (5931-0)	0° 00' 00"	0° 00' 00"	above standpt.
MAYS HILL (6690-0)	79 01 38	19.0614	above standpt.
PM 44431 (5000-2)	20 55 24	27.116	2.203
Cu Nail in conc (5000-0)	166 06 32	46.928	2.253
Bolt in conc (5000-1)	171 15 38	41.252	2.239
Bolt in kerb (5000-4)	262 01 34	31.034	1.544

STANDPOINT: Bolt in Kerb (5000-4)

Mark	Direction	Horiz. Distance	Height Difference
ROUND MTN (5931-0)	0° 00' 00"	0° 00' 00"	above standpt.
MAYS HILL (6690-0)	79 49 04	19.0614	above standpt.
Spike in kerb (5000-3)	81 48 27	31.034	1.544
PM 44431 (5000-2)	99 53 50	54.848	0.339
Cu Nail in conc (5000-0)	134 16 03	58.862	2.797
Bolt in conc (5000-1)	134 21 37	51.942	2.783

Checked

SR 2733-1

CENTRAL MAPPING AUTHORITY

GEODETIC SURVEY OF N.S.W.

GEODETIC STATION RECONNAISSANCE and MAINTENANCE REPORT

Description:

- 1. Cleared by lanes bearing 316° $15'10.7''$ from Trig. Mast
- 2. Mast & Vanes have been painted white & black respectively.
- 3. The station/pillar was unspiled/unspiled/constructed on 19..... dimensions now being:

Description of mark..... should be explicit, e.g., S/Steel Pillar Plate, Steel plug, Brass plug, Bolt, G.I. Pipe

Height of mark..... m. ^{above}/_{below} rock/concrete; Mark is..... m. ^{above}/_{below} G.L.

Height of Top Vanes to Top Mark/Pillar plate..... m. Diameter of Vanes (vertical)..... m.

Height of Cairn..... m. Diameter of Cairn..... m. Name Plate found/not found/placed.

Length of Mast..... m. (approximate if not unspiled)

- 4. A. ~~PM 44431~~ set in ~~concrete~~ has been placed/found, bearing 228° $0'$ $0''$ M from ~~Mast/Pillar~~ (Proposed)
- 5. A. Spike in kerb set in concrete has been placed/found, bearing 125° $0'$ $0''$ M from ~~Mast/Pillar~~ PM 44431
- 6. A. Bolt in kerb set in concrete has been placed/found, bearing 86° $0'$ $0''$ M from ~~Mast/Pillar~~ Spike
- 7. A. ~~PM 44431~~ set in concrete has been placed/found, bearing 305° $0'$ $0''$ M from ~~Mast/Pillar~~ Spike
- 8. Action required: ERECT ROOF TOP PILLAR + BEACON

STANDPOINT: Centre of platform

Mark	Direction	Horiz. Distance	Height Difference	Mark	Direction	Horiz. Distance	Height Difference
BIRON BAY L/H	170° M		above standpt.				above standpt.
ROUND MOUNTAIN	181° M		above standpt.				above standpt.
TOWERS	219° M	c. 80 ky	above standpt.				above standpt.
MT. WARNING	240° M		above standpt.				above standpt.
TONGARABAH GS.	347° M		above standpt.				above standpt.
POINT DANGER	348° M		above standpt.				above standpt.
FINIGAL L/H	359° M		above standpt.				above standpt.

Prepared by: G. CROSS 1/10/84

Checked: A.J. 8/1/84

Checked

S.O. 1407

Proposed STATION: CUDGEN (Resv) No.: 7174

MAP SHEETS SCALE 1:250 000 TWEED HEADS

INSPECTED BY: G. CROSS DATE: 25/9/84


AUTHORITY: CMA FIELD BOOK: ---

STATION: *CADGLEN G.S.P.* No.: *7174*

MAP SHEET SCALE 1:250 000

INSPECTED BY: *P.B.T.S.* DATE: *12.11.84*

AUTHORITY: *C.M.A.* FIELD BOOK: *1941*

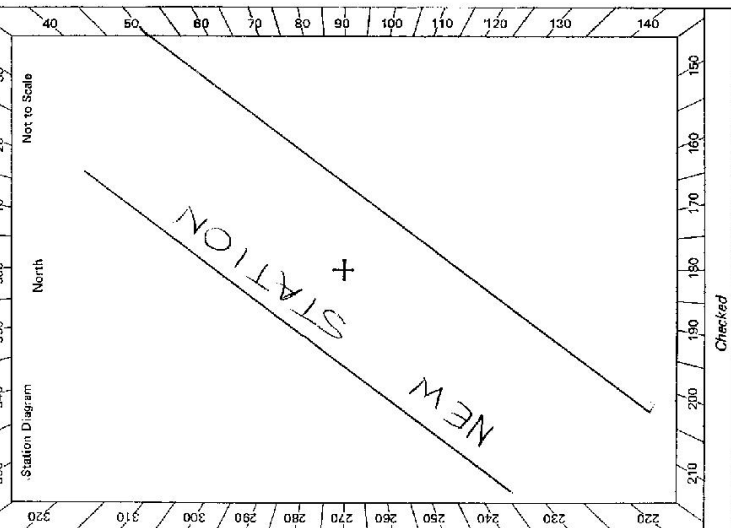

CENTRAL MAPPING AUTHORITY
 GEODETIC SURVEY OF M.S.W.
 GEODETIC STATION RECONNAISSANCE and MAINTENANCE REPORT

Description: *Note: Cross out word or words which do not apply*

1. Cleared by lances bearing *360° M* from Trig. Mast
2. Mast & Vanes have been painted white & black respectively. ✓
3. The ~~marker/pillar~~ was ~~replaced/reconstructed~~ constructed on *12th November 84*, dimensions now being: Description of mark: *Red Top Pillar* would be explicit, e.g., S/Steel Pillar Plate, Steel plug, Brass plug, Bolt, G.I. Pipe
 Height of mark: *1.887* m, ^{above} ~~rock/concrete~~ ^{below} ~~mark~~, Mark is *12.000* m, ^{above} ~~rock/concrete~~ ^{below} ~~mark~~. ✓
 Height of Top Vanes to Top ~~marker/pillar~~ plate *1.600* m. ✓ Diameter of Vanes (vertical) *0.755* m.
 Height of Cairn: m. Diameter of Cairn: m. Name Plate ~~replaced/reconstructed~~ placed.
 Length of Mast: m. (approximate if not unplied)
4. A set in conc/rock has been placed/found, bearing° M from Mast/Plug/Pillar
5. A set in conc/rock has been placed/found, bearing° M from Mast/Plug/Pillar
6. A set in conc/rock has been placed/found, bearing° M from Mast/Plug/Pillar
7. A set in conc/rock has been placed/found, bearing° M from Mast/Plug/Pillar
8. Action required: *Completed - Done by G. Dickson, 5/12/84*

STANDPOINT:				STANDPOINT:			
Mark	Direction	Horiz. Distance	Height Difference	Mark	Direction	Horiz. Distance	Height Difference
			above standpt.				above standpt.
			below				below
			above standpt.				above standpt.
			below				below
Prepared by: *P.B.T.S. M.H.R.* Checked: *A.S. 21/11* Noted on U.I.M. Card

Checked

GS 24

STATION CADGEN (S.I.P) TS 7174	Owner's Name: TANED RIVER SHIRE COUNCIL Address: TUMBLEGUM ROAD Phone: 732 993 MR MICHAEL TAYLOR OR ✓ MR DON Mc MILLSTER Access Report of:19.....was found suitable/unsuitable. PHONE: 13-11-1984 ACCESS
Beacon Diagram Not to Scale	<p>BEACON WITH SAND PILL & LADDER MADE WAY DOWN WATER TANK.</p>
This section to be completed by officer constructing pillar.	Original station mark found/not found. Description of mark: Original beacon found/not found. Description of beacon: Height Top of Vanes to Top Markm. Height of markm. above G.L. below Diameter of Vanesm. Height of Cairnm. Original Beacon has/has not been destroyed by me.
PLEASE NOTE EXTENSION LADDERS REQUIRED TO REACH STEEP LADDER APPROX 6 METRE. ✓ LADDER OBTAINABLE FROM KINGSLIFF HIRE <i>J. Wilson</i>	KA FERTILE ROAD TO KINGSLIFF ROAD SOUTH 0/16 TURN RIGHT AT KINGSABOUT INTO OLGA STREET. 0/27 CONTINUE THROUGH BOUND ABOUT 0/51 TURN RIGHT INTO DIVISION STREET 0/63 TURN LEFT INTO Mc HAIL STREET 0/91 TURN LEFT INTO GIBSON STREET. 0/99 TURN RIGHT INTO FULLANS STREET 1/18 TURN RIGHT AT REVERVOIRS.
Date	Record of Station

GEODETIC SURVEY OF N.S.W.

CENTRAL MAPPING AUTHORITY

GEODETIC STATION RECONNAISSANCE and MAINTENANCE REPORT

STATION: **CUDGEN G.S.** No.: **7174**
 MAP SHEETS SCALE 1:250 000 **TWEED HEADS** SCALE 1:100 000
 INSPECTED BY: **G. DICKSON** DATE: **5-12-1984**
 AUTHORITY: **C.M.A.** FIELD BOOK: **C444**
 STANDPOINT: **PM 4-4-4-31 (7174-2)**

Mark	Direction	Horiz. Distance	Height Difference
ROUND MOUNTAIN (P)	0 00 00		above standpt
CUDGEN (P) (7174-0)	62 18 22	29.670	12.584 below standpt
FINGAL (P)	162 14 13		above standpt
BOLT IN KERB (7174-4)	355 02 10	47.480	0.962 below standpt

STANDPOINT: **GILFIRE IN SOIL PL. (7174-5)**

Description:
 1. Cleared by lanes bearing **360°**
 2. Mast & Vanes have been painted white & black respectively.
 3. The ~~structure~~ pillar was ~~replaced~~ constructed on ~~12/1/1984~~ **12/1/1984**.
 Description of mark: **Roof top. Pillar.**
 Height of mark: **1.487** m. above ~~base~~ concrete platform.
 Height of Top Vanes to Top ~~Mark~~ Pillar plate: **1.00** m. Diameter of Vanes (vertical): **0.755** m.
 Height of ~~Centre~~ platform above G.L. is **12.0** m. Diameter of ~~Centre~~ **Centre** of ~~Centre~~ **Centre**.
 Length of Mast: m. (approximate if not applied)

4. A..... set in conc/rock has been placed/found, bearing.....°M from Mast/Plug/Pillar
 5. A..... set in conc/rock has been placed/found, bearing.....°M from Mast/Plug/Pillar
 6. A..... set in conc/rock has been placed/found, bearing.....°M from Mast/Plug/Pillar
 7. A..... set in conc/rock has been placed/found, bearing.....°M from Mast/Plug/Pillar
 8. Action required:.....

Mark	Direction	Horiz. Distance	Height Difference
ROUND MOUNTAIN (P)	0 00 00		above standpt
DRILL HOLE IN KERB (7174-3)	56 12 04	24.272	12.969 below standpt
MAYS HILL (P)	78 50 47		above standpt
FINGAL (P)	162 39 48		above standpt
GILFIRE IN SOIL (7174-5)	242 29 54	29.670	12.584 below standpt

STANDPOINT: **ROCKET PILLAR PLATE (7174-0)**

STANDPOINT: **DRILL HOLE IN KERB (7174-6)**

Mark	Direction	Horiz. Distance	Height Difference
ROUND MOUNTAIN (P)	0 00 00		above standpt
PM 44431 (7174-2)	18 49 46	11.068	0.244 below standpt
MAYS HILL (P)	79 01 58		above standpt
CUDGEN (P)	236 21 26	24.272	12.969 below standpt
SPIKE IN KERB (7174-3)	321 14 28	31.385	0.044 below standpt
CENTRE OF OLD REC (7174-7)	218 36 25	42.056	below standpt

STANDPOINT: **BOLT IN KERB (7174-4)**

Mark	Direction	Horiz. Distance	Height Difference
ROUND MOUNTAIN (P)	0 00 00		above standpt
SPIKE IN KERB (7174-3)	81 47 44	31.027	0.534 below standpt
MAYS HILL (P)	78 49 04		above standpt
PM 44431 (7174-2)	99 53 31	54.837	0.333 below standpt
GILFIRE IN SOIL (7174-5)	175 00 24	47.480	0.962 below standpt

STANDPOINT: **SPIKE IN KERB (7174-3)**

STANDPOINT: **BOLT IN KERB (7174-4)**

Prepared by: **12/1/85** Checked: **12/1/85**
 Noted on U.T.M. Card



S.O. 1407

