





GEODETTIC SURVEY OF N.S.W.

CENTRAL MAPPING AUTHORITY


GEODETTIC STATION RECONNAISSANCE and MAINTENANCE REPORT

STATION: BEN NEVIS \* **75**  
Map 7182

MAP SHEET SCALE 1:250 000 **Crofton**

INSPECTED BY: **N. Krahe** DATE: **7/8/78**

AUTHORITY: **CMA 67/2/2** FIELD BOOK: **-**

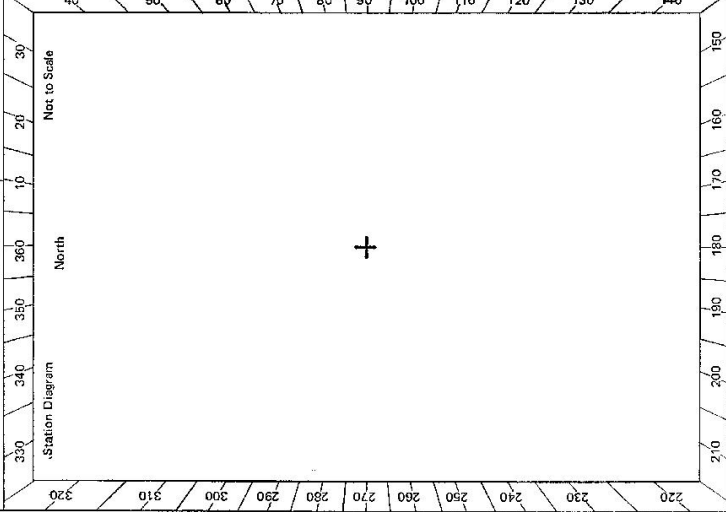

- Description: *Note: Cross out word or words which do not apply*
- Cleared by lanes bearing..... *3c.* ..... from Trig, Mast
  - Mast & Vanes have been painted white & black respectively.
  - The station/~~pillar~~ ~~was unpiled~~/not unpiled/constructed on..... 19....., dimensions now being: Description of mark..... should be explicit, e.g., S/Steel Pillar Plate, Steel plug, Brass plug, Bolt, G.I. Pipe Height of mark.....m. <sup>above</sup> <sub>below</sub> rock/concrete; Mark is.....m. <sup>above</sup> <sub>below</sub> G.L.
  - Height of Top Vanes to Top Mark/Pillar plate ..... (6.1m) Diameter of Vanes (vertical).....m.
  - Height of Cairn.....m. Diameter of Cairn.....m. Name Plate found/not found/placed.
  - Length of Mast.....m. ~~Box in that if not unpiled~~
  - A..... set in conc/rock has been placed/found, bearing.....°M from Mast/Plug/Pillar
  - A..... set in ~~conc/rock~~ <sup>conc/rock</sup> has been placed/found, bearing.....°M from Mast/Plug/Pillar
  - A..... set in conc/rock has been placed/found, bearing.....°M from Mast/Plug/Pillar
  - A..... set in conc/rock has been placed/found, bearing.....°M from Mast/Plug/Pillar
  - Action required: *new pillar*

STANDPOINT:

Mark	Direction	Horiz. Distance	Height Difference	Mark	Direction	Horiz. Distance	Height Difference
			above standpt.				above standpt.
			below standpt.				below standpt.
			above standpt.				above standpt.
			below standpt.				below standpt.
Prepared by: **K. Zaara for N. Krahe** Checked: **6/8/78** *Noted on U.T.M. Card*



7182

GEODETIC SURVEY OF N.S.W.

CENTRAL MAPPING AUTHORITY

GEODETIC STATION RECONNAISSANCE and MAINTENANCE REPORT

Description:

1. Cleared by lanes bearing  $360^\circ$  *except for 4 nearby trees* from Trig. Mast

2. Mast & Vanes have been painted white & black respectively.

3. The station/pillar was unpiled/not unpiled/constructed on  $19$  m, dimensions now being:

Description of mark should be explicit, e.g., S/Steel Pillar Plate, Steel plug, Brass plug, Bolt, G.I. Pipe

Height of mark  $0$  m, above below rock/concrete; Mark is  $0$  m, above below G.L.

Height of Top Vanes to Top Mark/Pillar plate  $0$  m. Diameter of Vanes (vertical)  $0.9$  m.

Height of Cairn  $1$  m. Diameter of Cairn  $2$  m. Name Plate found/not found/placed.

Length of Mast  $3$  m. (approximate if not unpiled)

4. A. *G.I. Pipe* set in conc/rock has been placed/found, bearing  $0$  M from Mast/Plug/Pillar

5. A. *S. 5 m* set in conc/rock has been placed/found, bearing  $0$  M from Mast/Plug/Pillar

6. A. set in conc/rock has been placed/found, bearing  $0$  M from Mast/Plug/Pillar

7. A. set in conc/rock has been placed/found, bearing  $0$  M from Mast/Plug/Pillar

8. Action required: *Construct concrete fella and clear nearby bushes*

STANDPOINT:

Mark	Direction	Horiz. Distance	Height Difference	Mark	Direction	Horiz. Distance	Height Difference
			above standpt				above standpt
			below				below
			above standpt				above standpt
			below				below
Prepared by: *Ben Grahame*

9/1/18

Checked: *Ben Grahame*


Notes on U.T.M. Grid

STATION: *BEN NEVIS* No.: *263*

MAP SHEET SCALE 1:250 000 *CRATTON*

INSPECTED BY: *P. GARROD* DATE: *26/7/82*

AUTHORITY: *CMAA* FIELD BOOK: *2010*

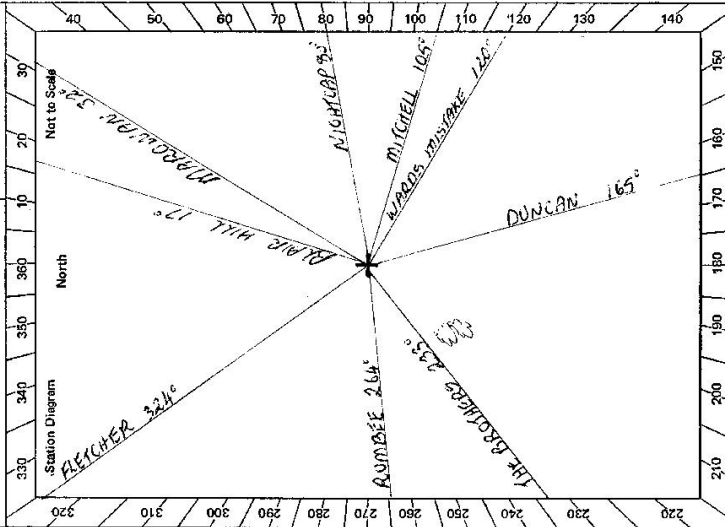



CENTRAL MAPPING AUTHORITY GEODETTIC SURVEY OF N.S.W.

**GEODETTIC STATION RECONNAISSANCE and MAINTENANCE REPORT**

STATION: **BEN NEVIS (P)** No.: **7182**

MAP SHEET SCALE 1:250 000 **GRAFTON**

INSPECTED BY: **G FORD** DATE: **8-12-84**

AUTHORITY: **C. M. A** FIELD BOOK: **C 377**

Station Diagram

Not to Scale

320 330 340 10000

- Description:
- Cleared by lanes bearing  $360^\circ$  ✓ *Note: Cross out word or words which do not apply*
  - Mast & Vanes have been painted white & black respectively. ✓
  - The station/pillar was ~~unplaced/not unplaced~~/constructed on  $5.2$ ..... $19.34$ ..... dimensions now being:
  - Description of mark: **SK PILLAR PLATE**..... should be explicit, e.g., S/Steel Pillar ~~Plate~~/~~Steel plug~~/~~Press plug~~/~~Post~~/~~G.I. Pipe~~
  - Height of mark  $1.375$ .....m. <sup>above</sup> ~~below~~ rock/concrete; Mark is  $1.525$ .....m. <sup>above</sup> ~~below~~ G.L.
  - Height of Top Vanes to Top Mark/Pillar plate  $1.440$ .....m. Diameter of Vanes (vertical)  $0.750$ .....m.
  - Height of Cairn.....m. Diameter of Cairn.....m. Name Plate ~~found/not found~~/placed,  $17/6/86$ .
  - Length of Mast.....m. (approximate if not unplaced)
  - A **BRASS PIVLS**..... set in conc/rock has been placed/found, bearing  $323^\circ$ ..... $0^\circ$ M from Mast/Plug/Pillar ✓
  - A **SSM**..... set in conc/rock has been placed/found, bearing  $260^\circ$ ..... $0^\circ$ M from Mast/Plug/Pillar
  - A **G.I. PIPE**..... set in conc/rock has been placed/found, bearing  $313^\circ$ ..... $0^\circ$ M from Mast/Plug/Pillar
  - A..... set in conc/rock has been placed/found, bearing..... $0^\circ$ M from Mast/Plug/Pillar
  - Action required:.....


STANDPOINT: <b>CONC PILLAR</b>			STANDPOINT: <b>BRASS TRIG PIVLS</b>				
Mark	Direction	Horiz. Distance	Height Difference	Direction	Horiz. Distance	Height Difference	
RUMBEE (P)	0 00 00	✓	above standpt	0 00 00	✓	above standpt	
SSM	33 37 30	2.317	below standpt	G.I. PIPE	89 54 30	2.025	below standpt
G.I. PIPE	91 59 40	4.211	below standpt	MAROWAN (P)	127 26 40	✓	below standpt
TRIG PIVLS	94 00 00	2.193	below standpt	MITCHELL (P)	201 49 20	✓	below standpt
MAROWAN (P)	127 26 00	✓	below standpt	CONC. PILLAR	273 55 20	2.190	below standpt
MITCHELL (P)	201 47 40	✓	below standpt	SSM	326 35 20	2.267	below standpt
			below standpt			below	

Prepared by: **G Ford** Checked: **AS 29/1** Noted on U.T.M. Card **App**

Checked **WA 8/2/85**

St 2735-2 D. West, Government Printer

STATION **BEN NEVIS \* (P)** **7182**

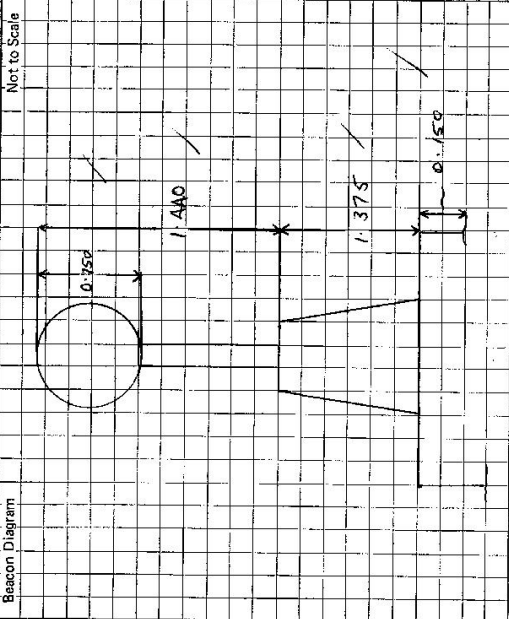

Owner's Name: **MR D B SMITH**  
 Address: **BEN NEVIS**  
 Phone: **GLENGOE VAL**  
**067-333263**  
 Access Report of: **8/12/19** was found suitable/unavailable.

Current Occupant:  
 Address:  
 Phone:

**0.00 GLENGOE P.O. HEAD SOUTH**  
**0.10 TURN LEFT INTO "BACKWATER ROAD"**  
**0.50 FOLLOW BITUMEN TO LEFT**  
**6.15 WOODEN BRIDGE**  
**8.55 PASS ROAD TO GLEN INNES ON LEFT**  
**10.50 PASS ROAD TO MT SLOW ON LEFT**  
**11.30 TURN RIGHT OVER GRAD SIGN "BEN NEVIS GM"**  
**12.55 STRAIGHT AHEAD OVER GRAD**  
**14.15 GRID**  
**14.90 TURN RIGHT THROUGH IRON GATE AND FOLLOW TRACK**  
**(OWNER LIVES STRAIGHT AHEAD TURN LEFT AFTER**  
**1.8 KM AND FOLLOW TRACK TO HOUSE)**  
**15.05 TURN RIGHT OFF TRACK AND MAKE OWN WAY UP SPUR**  
**15.4 UP STEEP PINCH THROUGH ROCKS TO TRIG (SOMETIMES)**

This section to be completed by officer constructing pillar.

Original station mark found/~~not found~~:  
 Description of mark: **BRASS PLYG**  
 Original beacon found/~~not found~~:  
 Description of beacon: **CAIRN POLE & DISC**  
 Height Top of Vanes to Top Mark: **3.480** m.  
 Height of mark: **0.25** m. above rock/~~0.100~~ m. below G.L.  
 Diameter of Vanes: **0.200** m. Height of Cairn: **1.400** m.  
 Original Beacon has/~~has not~~ been destroyed by me.

Date	Record of Station