

Proposed Station

CENTRAL MAPPING AUTHORITY

GEODETIC SURVEY OF N.S.W.

GEODETIC STATION RECONNAISSANCE and MAINTENANCE REPORT

Description:

1. Cleared by lanes bearing..... *Note: Cross out word or words which do not apply*

2. Mast & Vanes have been painted white & black respectively.

3. The station/pillar was unpiled/not unpiled/constructed on..... 19....., dimensions now being:

Description of mark..... should be explicit, eg., S/Steel Pillar Plate, Steel plug, Brass plug, Bolt, G.I. Pipe

Height of mark..... m. above rock/concrete; Mark is..... m. above G.L.

Height of Top Vanes to Top Mark/Pillar plate..... m. Diameter of Vanes (vertical)..... m.

Height of Cairn..... m. Diameter of Cairn..... m. Name Plate found/not found/placed.

Length of Mast..... m. ~~Approximate if not impiled~~

4. A..... set in conc./rock has been placed/found, bearing..... °M from Mast/Plug/Pillar

5. A..... set in conc./rock has been placed/found, bearing..... °M from Mast/Plug/Pillar

6. A..... set in conc./rock has been placed/found, bearing..... °M from Mast/Plug/Pillar

7. A..... set in conc./rock has been placed/found, bearing..... °M from Mast/Plug/Pillar

8. Action required..... *SEE 55/11/1030*

STANDPOINT:

STANDPOINT:

Mark	Direction	Horiz. Distance	Height Difference	Mark	Direction	Horiz. Distance	Height Difference
			above standpt				above standpt
			below				below
			above standpt				above standpt
			below				below
Prepared by: *Gl...*

Checked:

Noted on U.T.M. Card

SR 2733-1

STATION: **NOORINGA** No.: **7184**

MAP SHEET SCALE 1:250 000

INSPECTED BY: **A. GARSDIE** DATE: **14-8-82**

AUTHORITY: **CMA** FIELD BOOK: **2011**

Station Diagram

Not to Scale

St 2735-2 D. West, Government Printer

STATION NOORINGA TS 7184

Owner's Name: KA & DM BULL Current Occupant: ~~.....~~
 Address: "Nooringa" Gum Flat Address: ~~.....~~
 Phone: 067 236 255 Phone: ~~.....~~

ACCESS 14-8-1982

Not to Scale

--	--	--	--

~~Ann. Access Report of the...~~
0-0 Bridge over Macintyre River at INVERELL.
3-55 Head west on Gwydir Hwy towards Inverell.
11-8 Turn left towards Popetun Dam
12-9 Pass road to Gwydir Hwy and Robroy on right.
17-45 Gum Flat.
19-0 Pass road to Gwydir Hwy on right.
20-65 Pass Whitshire Rd on right.
23-25 Pass track to "Gowrie" on left.
28-3 Turn right in to Ocus Rd.
28-3 ~~Pass white house on right.~~
28-7 Pass owners house "Nooringa" on right. (Call in)
28-75 Causeway.
28-8 Pass white house on right.
28-95 Turn right through iron gate, then left.
28-99.0 Iron gate, follow track south.
29-7 Track veers right.
29-85 Iron gate then veer slightly left up hill.
30-1 Through tall gateposts in old fence and veer right.
30-9 Top of hill.

Date	Record of Station

This section to be completed by officer constructing pillar.

Original station mark found/not found. _____

Description of mark: _____

Original beacon found/not found. _____

Description of beacon: _____

Height Top of Vanes to Top Mark: _____ m.
above G.L.
below

Height of mark: _____ m. above G.L.
 _____ m. below

Diameter of Vanes: _____ m. Height of Cairn _____ m.

Original Beacon has/has not been destroyed by me. _____

CENTRAL MAPPING AUTHORITY

GEODETIC SURVEY OF N.S.W.

GEODETIC STATION RECONNAISSANCE and MAINTENANCE REPORT

Description: *Note: Cross out word or words which do not apply*

1. Cleared by lanes bearing $30^{\circ} 10' 00''$ (70° 80' KUREKJANG TREE) from Trig. Mast
CLEAR FOR C.P.S.
2. Mast & Vanes have been painted white & black respectively. ✓
3. The station/pillar was ~~unplaced~~ ~~not-emptied~~ /constructed on 1.7 19.24 , dimensions now being:
Description of mark 1.7 19.24 should be explicit, e.g., S/Steel Pillar Plate, Steel plug, Brass plug, Bolt, G.I. Pipe
Height of mark 1.370 m. ^{above} rock/concrete; Mark is 1.510 m. ^{above} G.L.
Height of Top Vanes to Top Mark/Pillar plate 1.440 m. ✓ Diameter of Vanes (vertical) 1.560 m. ✓
Height of Cairn 1.540 m. Diameter of Cairn 1.560 m. Name Plate ~~found~~ /not ~~found~~ /placed.
Length of Mast 1.540 m. (approximate if not emptied) *PLACED MAY 1989*
4. A **COPPER NAIL** set in conc/rock has been placed/~~found~~, bearing $308^{\circ} 00' 00''$ M from Mast/Plug/Pillar
5. A **G.I. PIPE** set in conc/rock has been placed/~~found~~, bearing $134^{\circ} 00' 00''$ M from Mast/Plug/Pillar
6. A **CONCRETE PILLAR** set in conc/rock has been placed/~~found~~, bearing $176^{\circ} 26' 19''$ M from Mast/Plug/Pillar
7. A **CONCRETE PILLAR** set in conc/rock has been placed/~~found~~, bearing $294^{\circ} 36' 17''$ M from Mast/Plug/Pillar
8. Action required: **COPPER NAIL**.


STANDPOINT: Concrete Pillar		STANDPOINT: COPPER NAIL				
Mark	Direction	Horiz. Distance	Height Difference	Direction	Horiz. Distance	Height Difference
STIRLING (P)	$0^{\circ} 00' 00''$		above standpt.	$0^{\circ} 00' 00''$		above standpt.
G.I. PIPE	$96^{\circ} 49' 34''$	4.306	below standpt.	$141^{\circ} 39' 08''$	7.533	below standpt.
Gundamulda (P)	$142^{\circ} 36' 25''$		above standpt.	$142^{\circ} 36' 46''$		above standpt.
GRAGIN (P)	$294^{\circ} 36' 45''$		above standpt.	$176^{\circ} 26' 19''$	5.860	above standpt.
COPPER NAIL	$396^{\circ} 27' 15''$	5.855	below standpt.	$294^{\circ} 36' 17''$		below standpt.
			above standpt.			above standpt.
			below			below

Prepared by: D. KAIN.


Checked: *[Signature]* 1-1-85

Noted on U.T.M. Card *[Signature]*

Checked: *[Signature]* 28/7/85

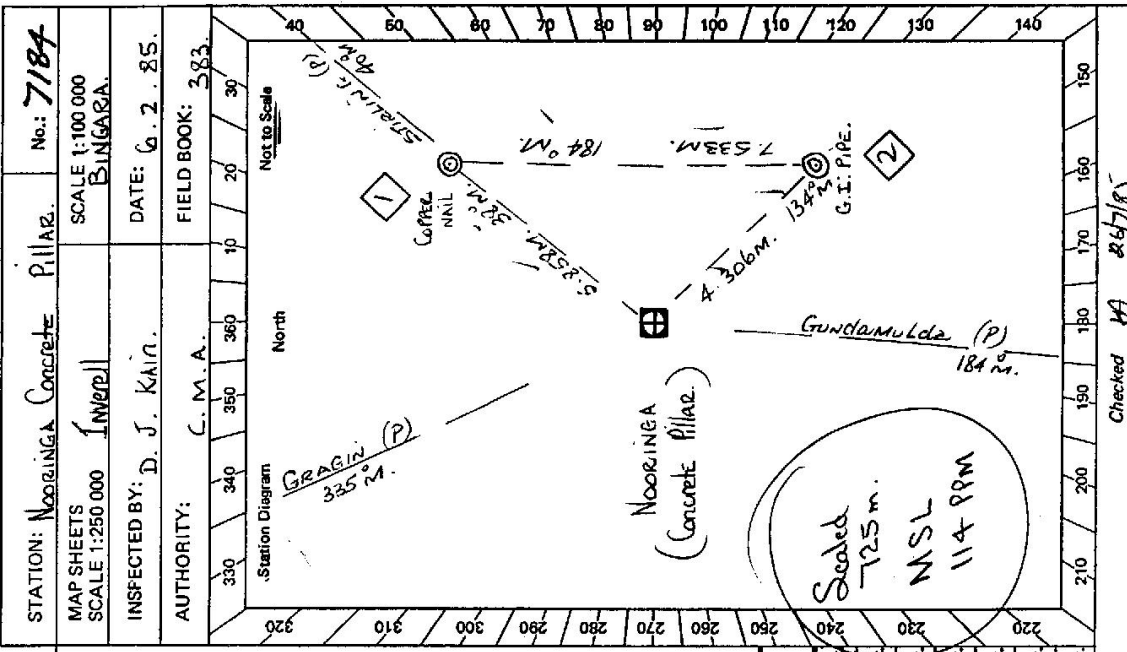

SR 2733-2 D. West, Government Printer

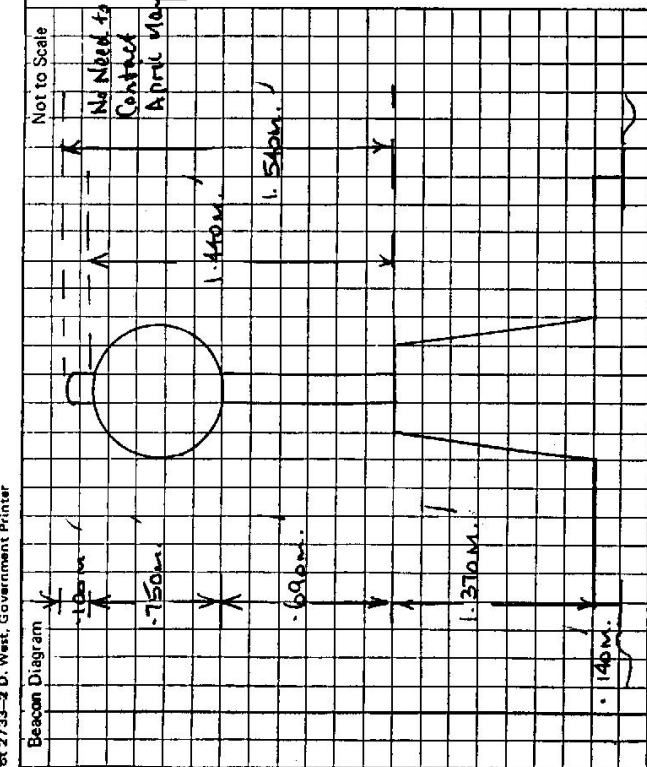

This section to be completed by officer constructing pillar.

Original station mark found/not found.

Description of mark:

Original beacon found/not found.

Description of beacon:

Height Top of Vanes to Top Mark

Height of mark

Diameter of Vanes

Original Beacon has/not been destroyed by me.

STATION Nooringa Concrete Pillar TS 7184

FREE HOLD
 Owner's Name: G. PARABANT & B. HARE & ET.
 Address: "TAVISH"
ONNIS ROAD GUM FLAT, INVERELL
 Phone: (0167) 236211

Current Occupant:
 Address:
 Phone:

ACCESS 6-2-85

Access Report of 14/8/1982 was found suitable/unsuitable.

FEATURE:

- KMS. 0.00 AT CENTRE OF ROAD BRIDGE OVER MACINTYRE RIVER AT INVERELL TRAVEL WEST ALONG GWYDIR HIGHWAY TOWARDS NARIALDA.
- 3-71 TURN LEFT TOWARDS "GRETON DAM".
- 12-20 PASS ROAD TO "GWYDIR HIGHWAY" AND "RAB ROY" ON RIGHT.
- 13-25 GUM FLAT.
- 19-53 PASS "WILTSHIRE ROAD ON RIGHT."
- 23-89 TURN RIGHT INTO "ONNIS ROAD."
- 29-43 PASS JOINT OWNERS HOUSE "Nooringa" ON RIGHT.
- 29-52 CAUSEWAY.
- 29-57 PASS OTHER JOINT OWNERS house "Tavish" on Your R.H.S. (CALL IN).
- 29-69 TURN RIGHT THROUGH IRON GATE THEN LEFT ALONG FENCE.
- 29-72 THROUGH IRON GATE, FOLLOW TRACK.
- 30-46 PASS FAINT TRACK ON LEFT.
- 30-61 IRON GATE THEN VEER SLIGHTLY LEFT UP HILL.
- 30-89 VEER RIGHT AND FOLLOW TRACK UP HILL.
- 31-73 Nooringa - Concrete Pillar.

Time: - INVERELL TO A 1 HOUR.

Date	Record of Station