

CENTRAL MAPPING AUTHORITY
Department of Lands

Trigonometrical Survey of N.S.W.

RECONNAISSANCE and MAINTENANCE REPORT

This Trig. Station has been:-

Note: Cross out word or words which do not apply

1. ~~Completely cleared to permit 360° vision to surrounding trig.~~
 2. Cleared by lanes bearing $0^{\circ} 11' 20''$ to $70^{\circ} 11' 40''$ M. 2.65 M. 2.78 M. from Trig. Mast
 3. Trig. Mast & Vanes have been painted white & black respectively.
 4. The Trig. was unpiled/~~not unpiled~~, dimensions now being: ~~.....~~
- Description of mark S.S. Trig. Pin in conc., should be explicit, e.g. Steel plug, Brass plug, Bolt, G.I. Pipe
- Height of mark..... 0.15 m above ~~.....~~ concrete ~~.....~~ 0.10 m above G.L.
- Height of Top Vanes to Top Mark 3.68 S. m. Diameter of Vanes (vertical) 1.00 m.
- Height of Cairn 1.2 m. Diameter of Cairn 1.5 m.

- Length of Mast 3.700 m. (approximate if not unpiled)
5. A G.I. Pipe set in conc/~~rock~~ has been placed 4.65 S. m. bearing 190° from Trig. Mast
 6. A G.I. Pipe (H) set in conc/~~rock~~ has been placed 17.99 S. m. bearing 270° from Trig. Mast
 7. A Cc. Nail set in conc/~~rock~~ has been placed 4.76 S. m. bearing 269° from Trig. Mast
 8. A..... set in conc/rock has been placed..... m. bearing..... $^{\circ}$ from Trig. Mast
 9. Connection G.I.P. to Cc. Nail : 5.94 m. bearing 320° M
 10. Connection..... to..... m. bearing..... $^{\circ}$ M
 11. Connection..... to..... m. bearing..... $^{\circ}$ M
 12. Connection..... to..... m. bearing..... $^{\circ}$ M
 13. Diff. Ht. S.S. Trig. Pin is 0.68 m. above Cc. Nail in conc. ✓
 14. Diff. Ht. S.S. Trig. Pin is 0.92 m. above G.I.P. in conc. ✓
 15. Diff. Ht. S.S. Trig. Pin is 1.45 m. above G.I.P. (H) in conc. ✓
 16. Diff. Ht. Cc. Nail is 1.40 m. above G.I.P. (H) in conc. ✓

Prepared by: D. FREDRIKSEN

Checked:

Noted on U.T.M. Card

Checked

STATION GRAVESEND T.S. 7186


Co: BURNETT | Ph: GRAVESEND

Map Sheet: GRAVESEND | No: 8938

Inspected by: D. FREDRIKSEN | Date: 27/10/75

Authority: C.M.A. 66/72. | Field Book: 1448 / 1475

Beacon Diagram | Not to Scale

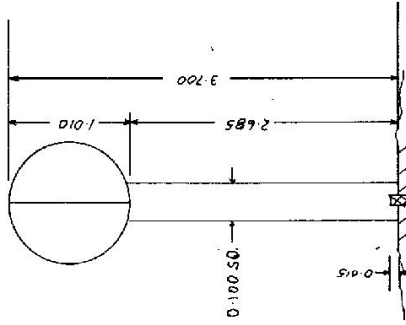

Date

23/9/75 | Station constructed by D. Mitchell
16/5/72 | Beacon left unchanged by D. Fredrikson

Record of Station

STATION GRAVESEND T.S. 7186

Owners Name: Mrs. Quinn, and son David Current Occupant:

Address: Gravesend Address:

Access 27-10-1975


FEATURE

- 0-0 GRAVESEND R.O. heading West
- 0-2 Owners house on left, stay on highway
- 2-B Bridge
- 4-1 Turn RIGHT off road cross railway line
- 4-5 Year RIGHT before cattle yards
- 4-9 Through iron gate, Head N.E. to saddle in hill, drive along East side of spur
- 5-9 Under Trig. walk to top of hill then 200m in easterly direction to Trig. 5 min. walk.

Not to Scale

Station Diagram

North

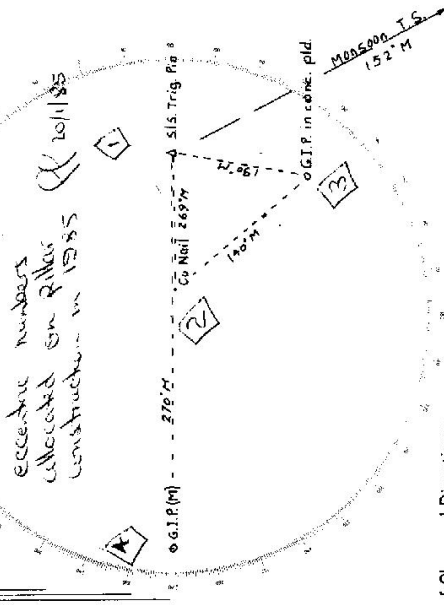

List of Observed Directions:-

Standpoint: S/S Trig. P/n.

Standpoint: G.I.P. in conc. pld.

Station	Direction	Station	Direction
MONSOON T.S.	0° 00' 00"	MONSOON T.S.	0° 00' 00"
G.I.P. in conc. pld.	39° 29'	G.I.P. (M) in conc. pld.	119° 19' 08"
Cu Nail in conc. pld.	117° 14'	Cu Nail in conc. pld.	167° 51' 00"
G.I.P. (M) in conc. pld.	117° 43' 00"	S/S Trig. P/n	219° 31'
Cu Nail in conc. pld.			
MONSOON T.S.	0° 00' 00"		
G.I.P. (M) in conc. pld.	117° 45' 04"		
S/S Trig. P/n in conc.	297° 15'		
G.I.P. in conc. pld.	347° 57' 00"		

6

GS 24


STATION GRAVESEND (S/P) Roof top IS 7186

Owner's Name:
 Address:
 Phone:

Current Occupant: A J RUMIN
 Address: GRAVESEND
 Phone: GRAVESEND 20

ACCESS

Access Report of 21.1.1985 was found suitable/unusable.
 MA FEATURE
 0.00 RD. GRAVESEND HEADS TOWARDS MOORE.
 3.93 TURN RIGHT OFF GYNDIC HIGHWAY ONTO DIRT
 TRACK & CROSS RAILWAY AVE.
 4.38 TAKE RIGHT TRACK.
 4.71 TURN LEFT THROUGH IRON GATE & HEAD SOUTH
 TOWARDS ION RIDGE - TRACK GOES ALONG TOP & SIDE
 OF THIS RIDGE, TRAILER PARK AT FIRST THEN
 BECOMES CLEAR.
 5.73 LEAVE VEHICLE NEXT TO SMALL TREE WITH BLAZE
 WALK STRAIGHT UP RIDGE AND ALONG TOP TO TRIG
 ABOUT 5 MINUTES EASY WALK.

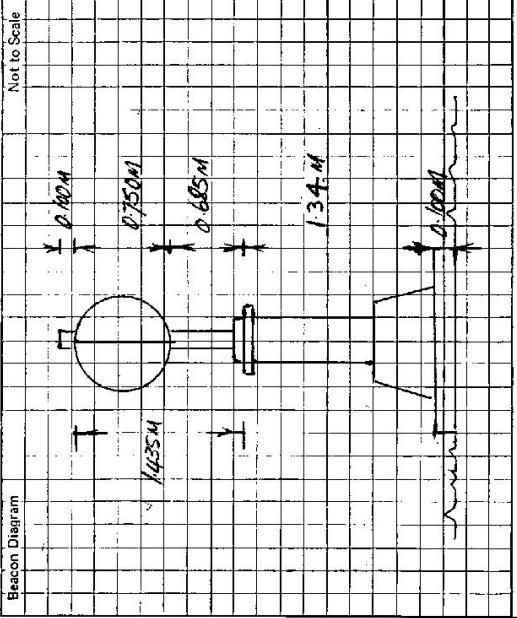

This section to be completed by officer constructing pillar.

Original station mark found/not-found: SHANKLESS STEEL P

Description of mark: SHANKLESS STEEL P

Original beacon found/not-found: CONCRETE PILE & DISC

Description of beacon: CONCRETE PILE & DISC

Height Top of Vane to Top Mark: 3.676 m.

Height of mark: 1.010 m. above G.L. / below G.L.

Diameter of Vane: 1.010 m. Height of Cairn: 0.600 m.

Original Beacon has/hasn't been destroyed by me.

Record of Station

Date

GEODETIC SURVEY OF NSW

CENTRAL MAPPING AUTHORITY

GEODETIC STATION RECONNAISSANCE and MAINTENANCE REPORT

STATION: GRAVESEND G.S.(P).


No.: 7186

MAP SHEET
SCALE 1:250 000

INSPECTED BY: P. BATES

DATE: 24 10 85

AUTHORITY: C.M.A.
FIELD BOOK: 1956

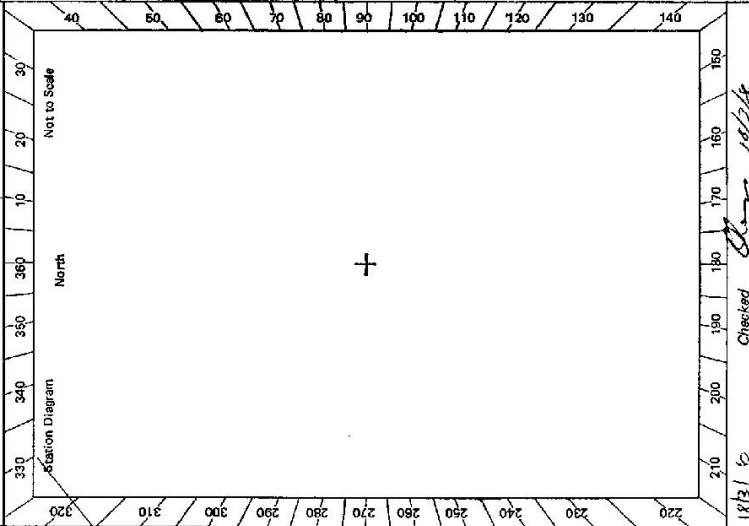

Description:
1. Cleared by lanes bearing.....
Note: Cross out word or words which do not apply
..... from Trig. Mast

2. Mast & Vanes have been painted white & black respectively.

3. The station/pillar was unpiled/not unpiled/constructed on.....19....., dimensions now being:

Description of mark.....should be explicit, e.g., S/Steel Pillar Plate, Steel plug, Brass plug, Bolt, G.I. Pipe

Height of mark.....m. ^{above} _{below} rock/concrete; Mark is.....m. ^{above} _{below} G.L.

Height of Top Vanes to Top Mark/Pillar plate.....m. Diameter of Vanes (vertical).....m.

Height of Cairn.....m. Diameter of Cairn.....m. ^{None} Plate found/not found/placed.

Length of Mast.....m. (approximate if not unpled)

4. A.....set in conc/rock has been placed/found, bearing.....°M from Mast/Plug/Pillar

5. A.....set in conc/rock has been placed/found, bearing.....°M from Mast/Plug/Pillar

6. A.....set in conc/rock has been placed/found, bearing.....°M from Mast/Plug/Pillar

7. A.....set in conc/rock has been placed/found, bearing.....°M from Mast/Plug/Pillar

8. Action required.....

STANDPOINT:

Mark	Horiz. Distance	Height Difference	Mark	Direction	Horiz. Distance	Height Difference
		above standpt.				above standpt.
		below standpt.				below standpt.
		above standpt.				above standpt.
		below standpt.				below standpt.
Prepared by: P. BATES 28.10.85

Checked: [Signature] 23.1.86

Checked: [Signature] 19/1/86

Noted on U.T.M. Card


STATION **GRAVESEND GS(P) ROOFTOP** TS 7186

Owner's Name:
 Address:
 Phone:

Current Occupant:
 Address:
 Phone:

ACCESS
 Access Report of 24/10/1985 was found suitable/unsuitable.

6-2730-2-D, West, Government Printer
 Beacon Diagram

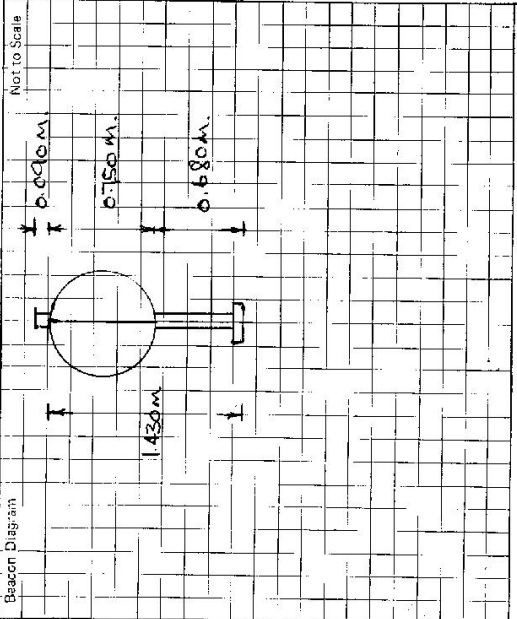

This section to be completed by officer constructing pillar.

Original station mark found/not found.

Description of mark:

Original beacon found/not found.

Description of beacon:

Height Top of Vanes to Top Markm.

Height of mark:m. above below rock/concm. below G.L.

Diameter of Vanesm. Height of Cairnm.

Original Beacon has/has not been destroyed by me.

Date	Record of Station