

CENTRAL MAPPING AUTHORITY

GEODETIC SURVEY OF N.S.W.

GEODETIC STATION RECONNAISSANCE and MAINTENANCE REPORT

Description:

1. Cleared by lanes bearing 360° with some scattered trees. *Note: Cross out word or words which do not apply*
2. Mast & Vanes have been painted white & black respectively.
3. The station/pillar was ~~not~~ supplied/not supplied/constructed on 6-3-1985, dimensions now being: Description of marks: ~~None~~ *None* should be explicit, e.g., S/Steel Pillar Plate, Steel plug, Brass plug, Bolt, G.I. Pipe
Height of mark: 3.95 m. above rock/concrete; Mark is 4.75 m. above G.L. ✓
Height of Top Vanes to Top Mark/Pillar plate 4.40 m. ✓ Diameter of Vanes (vertical) 0.755 m. ✓
Height of Cairn: _____ m. Diameter of Cairn: _____ m. Name Plate ~~found~~/not ~~found~~/placed.
- Length of Mast _____ m. (approximate if not unplied)
4. A. Brass Horiz Pin ~~set in conc/rock~~ *set in conc/rock* has been ~~placed~~/found, bearing 177° M from Mast/Plug/Pillar
5. A. C.I. Pipe _____ set in conc/rock has been placed/~~found~~, bearing 214° M from Mast/Plug/Pillar
6. A. _____ set in conc/rock has been placed/~~found~~, bearing _____ M from Mast/Plug/Pillar
7. A. _____ set in conc/rock has been placed/~~found~~, bearing _____ M from Mast/Plug/Pillar


8. Action required: _____

STANDPOINT: S/S Pillar Plate			STANDPOINT: BRASS PIN				
Mark	Direction	Horiz. Distance	Height Difference	Mark	Direction	Horiz. Distance	Height Difference
BOWLING CS (P)	0 00 00		above standpt	BOWLING CS (P)	0 00 00		above standpt
STUMPY CS	6 25 40		above standpt	STUMPY CS	6 25 35		above standpt
BLACK CS (P)	46 07 10		above standpt	BLACK CS (P)	46 08 05		above standpt
BRASS PLATE	56 21 10	5.710	1.331	MYLORA CS (P)	76 29 25		above standpt
MYLORA CS (P)	76 27 35		above standpt	G.I. PIPE	755 32 10	4.031	0.068
G.I. PIPE	93 24 40	6.601	1.406	S/S PILLAR PLATE	236 22 15	5.913	1.326

Prepared by: *[Signature]*

Checked: *[Signature]*

Noted on U.T.M. Card 491

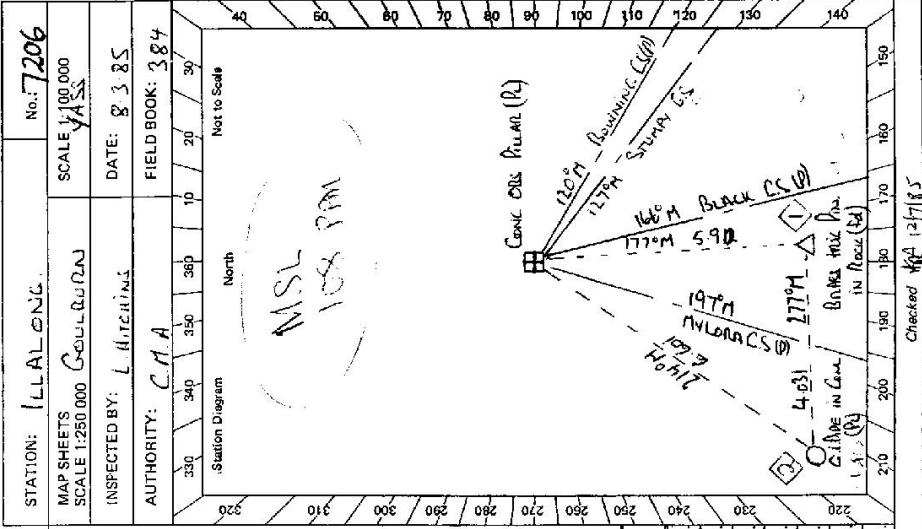

Checked: *[Signature]* 12/7/85

GS 24

STATION ILLALONG G.S (P) TS-7206

Owner's Name: ERIC LAURENCE
 Address: 'DAK DALE'
 Phone: 062 276173


Current Occupant:
 Address:
 Phone:

PLEASE CALL BEFORE ENTERING IN MET ACCESS

Access Report of 8/12/1985 was found suitable/unsuitable.

80 VASS P.O. HEAD TOWARDS MELBOURNE.
 842 PASS BOOROWA ROAD ON RIGHT
 1194 TURN RIGHT ONTO HARDEN BOUNDING ROAD CO THROUGH BOUNDING
 1332 TURN RIGHT ONTO BINGALONG RAILWAY LINE.
 2172 ROAD HOUSES RAILWAY LINE.
 2184 TURN RIGHT INTO COONDAH
 2285 CROSS RAILWAY LINE.
 2302 TAKE U TURN TO LEFT.
 2355 TURN LEFT THROUGH GATE
 2397 FERRIS BURNERS HOUSE AND SHEDS ON RIGHT, 2406, 2444, 2470, 2515.
 FOLLOW TRACK PARALLEL TO RAILWAY LINE GATES AT 2549
 2530 TAKE RIGHT FORK AROUND DAM AND THROUGH GATE AT 2549
 2569 CROSS CREEK + FOLLOW TRACK WINDING UP HILL.
 2659 HINDO GATE AND FOLLOW MOUNTAIN TRACK
 2726 GATE 1787 GATE FOLLOW TRACK AROUND HILL.
 2845 GATE FOLLOW TRACK
 2900 GATE FOLLOW TRACK
 2928 TURN LEFT + FOLLOW PRINT TRACK
 2974 GATE FOLLOW PRINT TRACK
 2987 TURN LEFT + FOLLOW TRACK UP HILL -
 3025 ILLALONG G.S (P)

Not to Scale

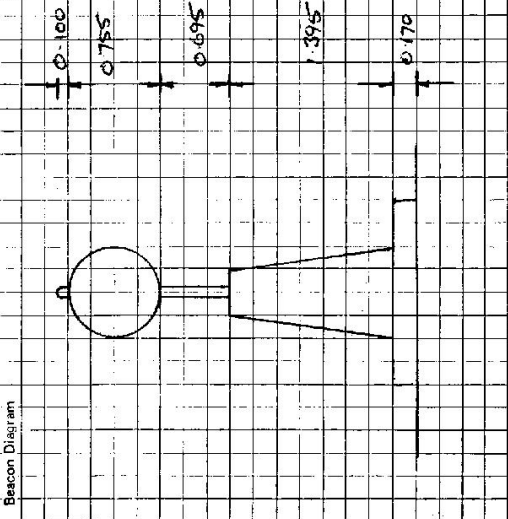

This section to be completed by officer constructing pillar.

Original station mark found/not found.

Description of mark: Beacon this is in Rock ✓

Original beacon found/lost/destroyed.

Description of beacon: Beacon ✓

Height Top of Vanes to Top Mark: 3.655 m. ✓

Height of mark: 0.200 m. above rock base, 0.250 m. above G.L., 0.250 m. below

Diameter of Vanes: 0.770 m. ✓ Height of Cairn: 1.200 m.

Original Beacon has/has not been destroyed by ms.

Date

Record of Station