

CENTRAL MAPPING AUTHORITY

GEODETTIC SURVEY OF N.S.W.

GEODETTIC STATION RECONNAISSANCE and MAINTENANCE REPORT

Description:

1. Cleared by vanes bearing.....
 Note: Cross out word or words which do not apply
 from Trig. Mast

2. Mast & Vanes have been painted white & black respectively.
 Mast & Vanes are ~~not~~ ^{not} unpiled/constructed on..... 19....., dimensions now being:

3. The station/pillar ~~is~~ ^{is} ~~not~~ ^{not} unpiled/constructed on.....
 Description of mark..... should be explicit, e.g., S/Steel Pillar Plate, Steel plug, Brass plug, Bolt, G.I. Pipe
 Height of mark.....m. above rock/concrete; Mark is.....m. above below G.L.

Height of Top Vanes to Top Mark/Pillar plate ~~is~~ ^{is}.....m. Diameter of Vanes (vertical).....m.

Height of Cairn.....m. Diameter of Cairn.....m. Name Plate found/not found/placed.

Length of Mast.....m. (approximate if not unpiled)

4. A.....set in conc/rock has been placed/found, bearing.....°M from Mast/Plug/Pillar

5. A.....set in conc/rock has been placed/found, bearing.....°M from Mast/Plug/Pillar

6. A.....set in conc/rock has been placed/found, bearing.....°M from Mast/Plug/Pillar

7. A.....set in conc/rock has been placed/found, bearing.....°M from Mast/Plug/Pillar

8. Action required: ~~Construct pillar & level bearing~~ ^{Approved by C.T.S.}.....

STANDPOINT:


Mark	Direction	Horiz. Distance	Height Difference	Mark	Direction	Horiz. Distance	Height Difference
			above standpt.				above standpt.
			below				below
			above standpt.				above standpt.
			below				below
Prepared by: *O. Moss*

Checked: *AS*

Noted on U.T.M. Card

Checked

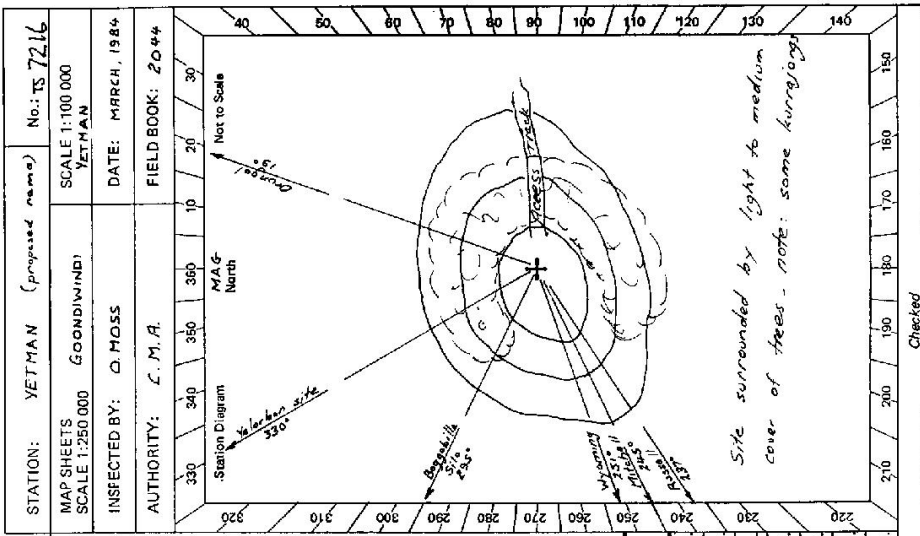

6. 2733-2 D. West, Government Printer

Beacon Diagram Not to Scale

This section to be completed by officer constructing pillar.

Original station mark found/not found.

Description of mark:

Original beacon found/not found.

Description of beacon:

Height Top of Vane to Top Mark.....m.

Height of mark.....m. above G.L. below rock/cons.....m. below G.L.

Diameter of Vane.....m. Height of Cairn.....m.

Original Beacon has/has not been destroyed by me.

STATION **TS 7216**
VETMAN.

Owner's Name:
 Address:
 Phone:
ACCESS

MANAGER Peter Knalpp
 Current Ownership Trigamon
 Address:
F.M.076...752415
 ACCESS6...SUBTON
 OWNERC...TRIGAMON
 PH. 076 153158

Access Report of2/1984 was found suitable/unsuitable.

- 88.00 Texas FO head west
- 2.10 Turn left & cross railway
- 2.10 Turn right - gravel road
- 5.68 Turn right towards Vetman
- 27.75 Turn left onto dirt track- 100m before bridge sp Middle Creek
- 28.67 Thru iron gate. (GMA LOCK)
- 29.03 Thru iron gate, turn right, passing access owners house on LHS
- 29.15 Thru wooden gate
- 29.35 Creek crossing
- 29.61 Turn left thru wire gate
- 30.07 Thru wooden gate & veer left
- 30.33 Creek crossing
- 30.42 Take left fork
- 30.96 Thru double iron gate
- 31.58 Creek crossing
- 32.84 Track goes thru pine trees
- 33.15 Cross creek & turn right at blazed tree-fallow blazes
- 33.36 Top of ridge-Holmes pillar straight ahead-veer up ridge to right
- 33.62 Top of ridge--veer left & follow ridge line
- 33.75 Entering trees follow blazed track
- 33.86 Veering left thru small clearing then onto top of ridge
- 34.5 Into cleared area make own way up hill to top at 34.7

NOTE: From intersection of Bruxner Hwy & road to Vetman (sp Vetman 1), pass road to managors house (sp Trigaron Crossing) at 11.45-Middle creek bridge is at 14.45-see 27.75 on map access

Date	Record of Station

GEODETTIC SURVEY OF N.S.W.

CENTRAL MAPPING AUTHORITY

GEODETTIC STATION RECONNAISSANCE and MAINTENANCE REPORT

Description:

1. Cleared by lanes bearing $125^{\circ} 20'$ $28^{\circ} 65'$ $75^{\circ} 84'$ $105^{\circ} 165'$ $136^{\circ} 158'$ $160^{\circ} 282'$ from Trig. Mast
 $240^{\circ} - 345^{\circ}$ $350^{\circ} - 358^{\circ}$

2. Mast & Vanes have been painted white & black respectively.
 3. The station/pillar was unpiled/not unpiled/constructed on $11^{\circ} 5'$ $19^{\circ} 85'$, dimensions now being:

Description of mark: ~~S/S~~ ~~PLUG~~ ~~PLATE~~ should be explicit, e.g., S/Steel Pillar Plate, Steel plug, Brass plug, Bolt, G.I. Pipe

Height of mark: 1.370 m. above rock/concrete; Mark is 1.470 m. above G.L.

Height of Top Vanes to Top Mark/Pillar plate 1.435 m. Diameter of Vanes (vertical) 0.250 m.

Height of Cairn m. Diameter of Cairn m. Name Plate found/lost found/placed, $11/1919$

Length of Mast m. (approximate if not unpiled)

4. A. ~~C.C. PILLAR~~ ~~MARK~~ set in conc/rock has been placed/formed, bearing 250° 0° M from Mast/Plug/Pillar

5. A. ~~G.I. PIPE~~ set in conc/rock has been placed/formed, bearing 328° 0° M from Mast/Plug/Pillar

6. A. set in conc/rock has been placed/formed, bearing 0° M from Mast/Plug/Pillar


7. A. set in conc/rock has been placed/formed, bearing 0° M from Mast/Plug/Pillar

8. Action required:

STANDPOINT: C.C. PILLAR			STANDPOINT: COPPER NAIL		
Mark	Direction	Horiz. Distance	Mark	Direction	Horiz. Distance
TEXAS (CS)	C CC 60		TEXAS (CS)	C CC 00	
ABERCROMBIE (P)	160 09 00	above standpt.	C.C. PILLAR	B 41 50 177	1.765 above standpt.
C.V. NAIL	188 40 20	above standpt.	ABERCROMBIE (P)	160 08 40	above standpt.
G.I. PIPE	269 24 40	above standpt.	G.I. PIPE	321 19 40	1.744 above standpt.
		below			below
		below			below
		below			below
		below			below

Prepared by *[Signature]* 1/4/85

Checked: *[Signature]* Noted on U.T.M. Card

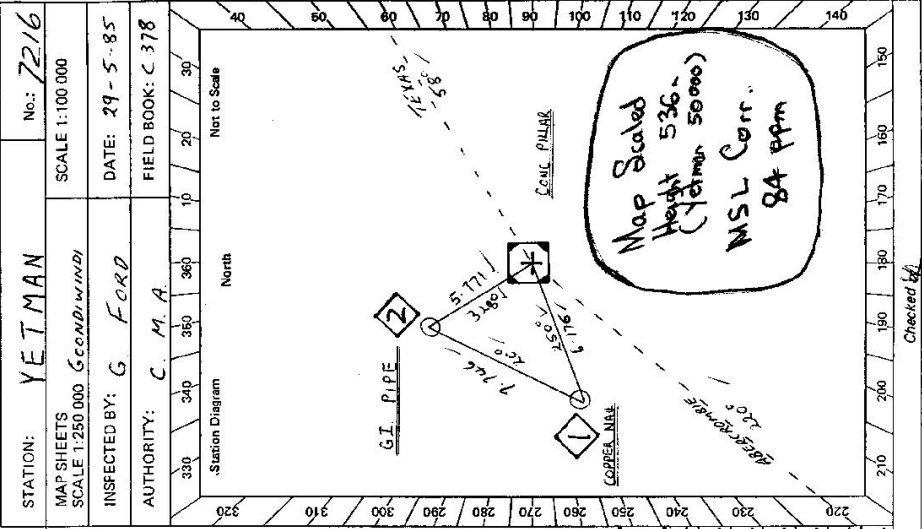


STATION: YETMAN No.: 7216

MAP SHEETS SCALE 1:250 000 SCALE 1:100 000

INSPECTED BY: G FORD DATE: 29-5-85

AUTHORITY: C. M. A. FIELD BOOK: C 378

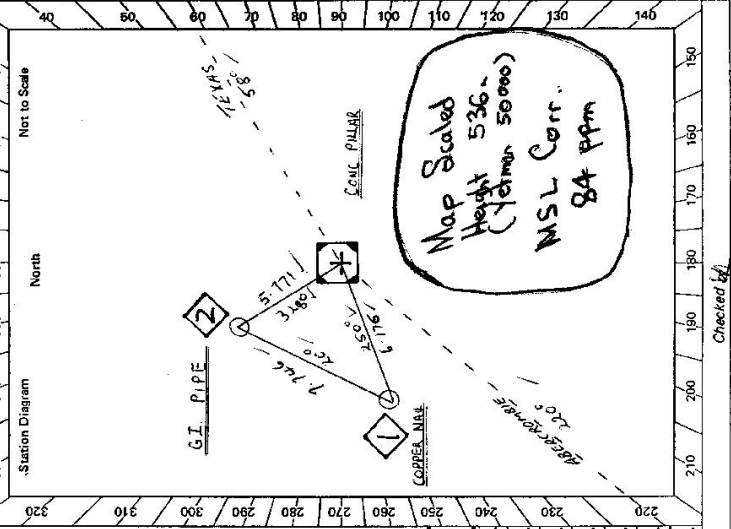

Checked by *[Signature]*

ST7216-2 D. West, Government Printer

STATION **YETMAN (P) TS 7216**

Owner's Name: **J. MAYNE**
 Address: **THE KNOLL, TEXAS**
 Phone: **(676) 531596 TEXAS**

MANAGER


Current Occupant: **PETER KNEIPP**
 Address: **TRIGAMON**
 Phone: **(076) 753115**
 VIA **YETMAN**

ACCESS OWNER: **G. SUITON**
 ADDRESS: **COOPARACK**
 PH: **076 753158**

ACCESS

Access Report of **29.5.86** was found suitable/unsuitable.

- 00.00 TEXAS PD. HEAD WEST
- 00.28 TURN LEFT & CROSS RAILWAY LINE
- 2.10 TURN RIGHT & GRAVEL ROAD
- 5.68 TURN RIGHT TOWARDS YETMAN
- 27.75 TURN LEFT INTO DIAT TRACK - 10CM BORDE BRIDGE SP MIDDLE CREEK
- 28.67 THRU IRON GATE (CMA GOLF)
- 29.03 THRU IRON GATE, TURN RIGHT, PASSING ACCESS OWNER HOUSE ON L.H.S.
- 29.15 THRU WOODEN GATE
- 29.35 CREEK CROSSING
- 29.61 TURN LEFT THRU WIRE GATE
- 30.07 THRU WOODEN GATE & VEER LEFT 30.33 CREEK CROSSING
- 30.42 TAKE LEFT CORNER 30.96 THRU DOUBLE IRON GATE [BOUNDARY FENCE]
- 31.58 CREEK CROSSING
- 32.84 TRACK GOES EAST SIDE AROUND PINE TREES [FOLLOW BLAZES]
- 33.15 CROSS CREEK & TURN RIGHT AT BLAZED TREE - FOLLOW BLAZES
- 33.36 TOP OF RIDGE - [HOLMES PILLAR STRAIGHT AHEAD] VEER UP RIDGE TO RIGHT
- 33.62 TOP OF RIDGE - VEER LEFT & FOLLOW RIDGE LINE
- 33.75 ENTERING TREES FOLLOW BLAZED TRACK
- 33.86 VEERING LEFT THRU SMALL CLEARING THEN ONTO TOP OF RIDGE
- 34.5 INTO CLEARED AREA MAKE OWN WAY UP HILL TO TOP AT 34.7

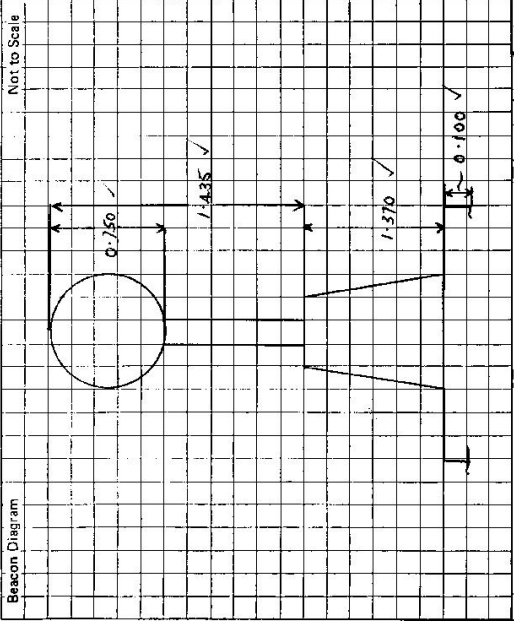

This section to be completed by officer constructing pillar.

Original station mark found/not found.

Description of mark: **NEW S.T.I.B.M. ✓**

Original beacon found/not found.

Description of beacon:

Height Top of Vanes to Top Mark m.

Height of mark: m. above G.L. below

Diameter of Vanes m. Height of Cairn m.

Original Beacon has/has not been destroyed by me.

Date

Record of Station

FROM **YETMAN** INTERSECTION OF **SALAMER HWY & ROAD TO YETMAN (SP. YETMAN I)** PASS ROAD TO **MANGES HOUSE (SP TRIGAMON CROSSING) AT 11.15 - MIDDLE CREEK BRIDGE IS AT 14.15 - SEE 27.75 ON ABOVE ACCESS**