

CENTRAL MAPPING AUTHORITY
 GEODETTIC SURVEY OF N.S.W. Batch Id: 1573
 GEODETTIC STATION RECONNAISSANCE and MAINTENANCE REPORT

- Description:
 1. Cleared by lanes bearing 360.01 Note: Cross out word or words which do not apply from Trig. Mast
 2. Mast & Vanes have been painted white & black respectively.
 3. The ~~station marker~~ marker was ~~replaced~~ replaced / ~~constructed~~ constructed on 27th August 1984, dimensions now being: ✓
 Description of mark..... should be explicit, e.g., S/Steel Pillar Plate, Steel plug, Brass plug, Bolt, G.I. Pipe
 Height of mark.....m. above rock/concrete; Mark is.....m. above G.L.
 Height of Top Vanes to Top Mark/Pillar plate.....m. Diameter of Vanes (vertical).....m.
 Height of Cairn.....m. Diameter of Cairn.....m. Name Plate found/not found/placed.
 Length of Mast.....m. (approximate if not unpled)
 4. A..... set in conc/rock has been placed/found, bearing.....°M from Mast/Plug/Pillar
 5. A..... set in conc/rock has been placed/found, bearing.....°M from Mast/Plug/Pillar
 6. A..... set in conc/rock has been placed/found, bearing.....°M from Mast/Plug/Pillar
 7. A..... set in conc/rock has been placed/found, bearing.....°M from Mast/Plug/Pillar
 8. Action required:.....

STANDPOINT:				STANDPOINT:			
Mark	Direction	Horiz. Distance	Height Difference	Mark	Direction	Horiz. Distance	Height Difference
			above standpt.				above standpt.
			below				below
			above standpt.				above standpt.
			below				below
Prepared by: P.B.T.S. 30.8.84
 Checked: [Signature]
 Noted on U.T.M. Card 31.7.85
 Checked

STATION: LOGGA DUNA Trig (H) No: 7225
 MAP SHEETS SCALE 1:250 000 MOREE SCALE 1:100 000
 INSPECTED BY: P.B.T.S. DATE: 27-8-84
 AUTHORITY: C.M.A. FIELD BOOK: 01658

Station Diagram

Not to Scale

TS: 7225
GS 24


STATION LOGGABILLA SILO BEACON

Owner's Name: C. RAIN HANDLING AUTHORITY Occupant: Key Maritime Team
 Address: 11000 (INDUSTRIAL DRIVE)
11000 (INDUSTRIAL DRIVE)
ALASKA ST. HOUSTON TX 77058-0001
 Phone: 067 53 1110 Phone: 773333

ACCESS
 Access Report of 11/8/1988 was found suitable/unsuitable.
LOGGABILLA TOWN

A SPICE THE SAME IS ATTACHED TO TOP OF OLD CAP -
THE SPICE IS ATTACHED TO THE TOP OF OLD CAP -
A SPIGOT HAS BEEN PLACED CENTRE OF PLATE
APPROXIMATELY 15 MM ABOVE PLATE 2.4.85.

C.A.M. MORE SHOULD BE CONTACTED SOME DAYS
BEFORE VISIT TO ARRANGE FOR SILO TO BE OPENED

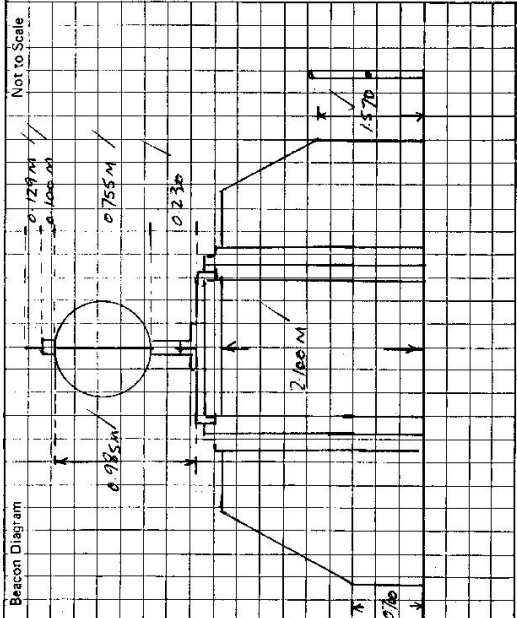

This section to be completed by officer constructing pillar.

Original station mark found/not found.

Description of mark:

Original beacon found/not found.

Description of beacon:

Height Top of Vanes to Top Mark m.
 above
 below

Height of mark m. above
 rock/conc m. below

Diameter of Vanes m. Height of Cairn m.

Original Beacon has/has not been destroyed by me.

Date	Record of Station