

CENTRAL MAPPING AUTHORITY

GEODETIC SURVEY OF INDIA

GEODETIC STATION RECONNAISSANCE and MAINTENANCE REPORT

STATION: TS HENRY WERNER (P) No: 10857

MAP SHEETS SCALE 1:100 000
SCALE 1:250 000
INSPECTED BY: H.C. BORDER
DATE: 20-5-85

AUTHORITY: C.L.O.
FIELD BOOK: SAAG

Description: 350
Note: Cross out word or words which do not apply
Cleared by lanes bearing..... from Trig. Mast

Mast & Vanes have been painted white & black respectively.

The station/pillar was ~~erected~~ constructed on 20th MAY 1985, dimensions now being:

Description of mark: S/S Pillar should be explicit, e.g., S/Steel Pillar Plate, Steel plug, Brass plug, Bolt, G.I. Pipe
Plate

Height of mark 1.40 above ~~rock~~ concrete; Mark is 1.50 above G.L.

Height of Top Vanes to Top ~~Mark~~ Pillar plate 1.41 m. Diameter of Vanes (vertical) 0.60 m.

Height of Cairn..... m. Diameter of Cairn..... m. Name Plate ~~found~~ found/placed.

Length of Mast 1.50 m. (approximate if not emptied)

A Brass Rod set in concrete has been ~~placed~~ found, bearing 17 °M from ~~Mast~~ Pillar

A Copper Spike set in concrete has been placed, bearing 200 °M from ~~Mast~~ Pillar

A..... set in conc/rock has been placed/found, bearing..... °M from Mast/Plug/Pillar

A..... set in conc/rock has been placed/found, bearing..... °M from Mast/Plug/Pillar


Action required: See F.B. SAAG/01 for station summary.

STANDPOINT: CONC PILLAR		STANDPOINT:					
Mark	Direction	Horiz. Distance	Height Difference	Mark	Direction	Horiz. Distance	Height Difference
(Plug) WELLINGTON	30 00 00		above standpt below				above standpt below
PELEY (P)	170 09 23		above standpt below				above standpt below
WELLESLEY (P)	263 26 18		above standpt below				above standpt below
Copper Spike in Conc	283 07 28	3.042	above standpt below				above standpt below
SS Rod	17 04 01	3.017	above standpt below				above standpt below

Prepared by: H.C. BORDER


Checked: VA

Noted or U.T.M. Card

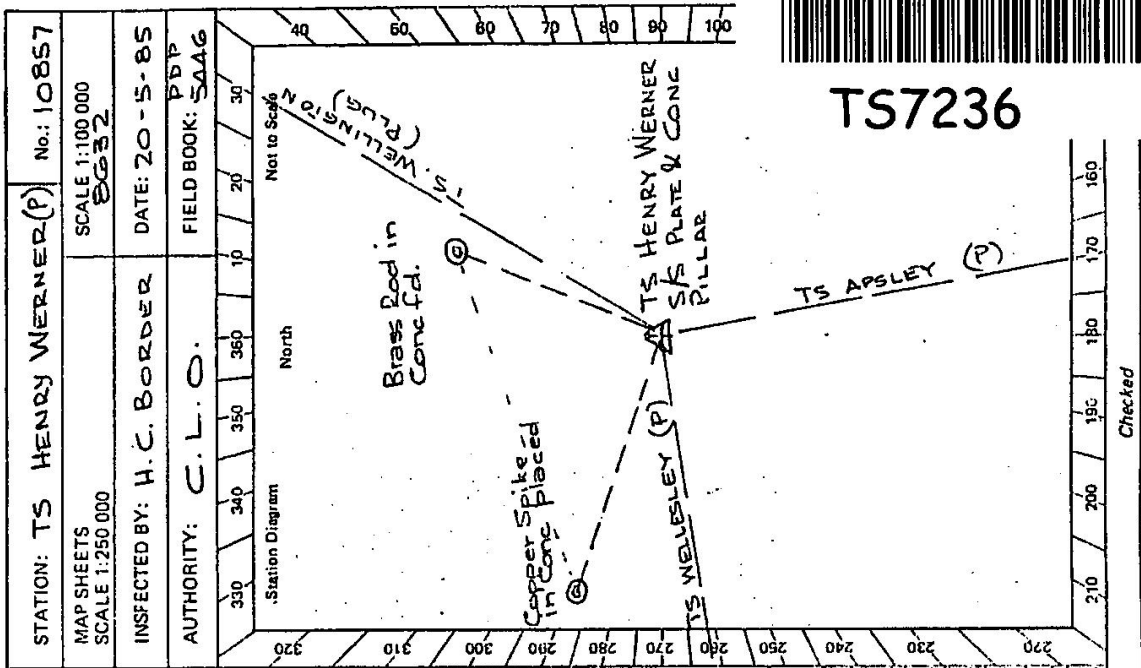


St 2733-2 D. West, Government Printer

STATION TS HENRY WERNER

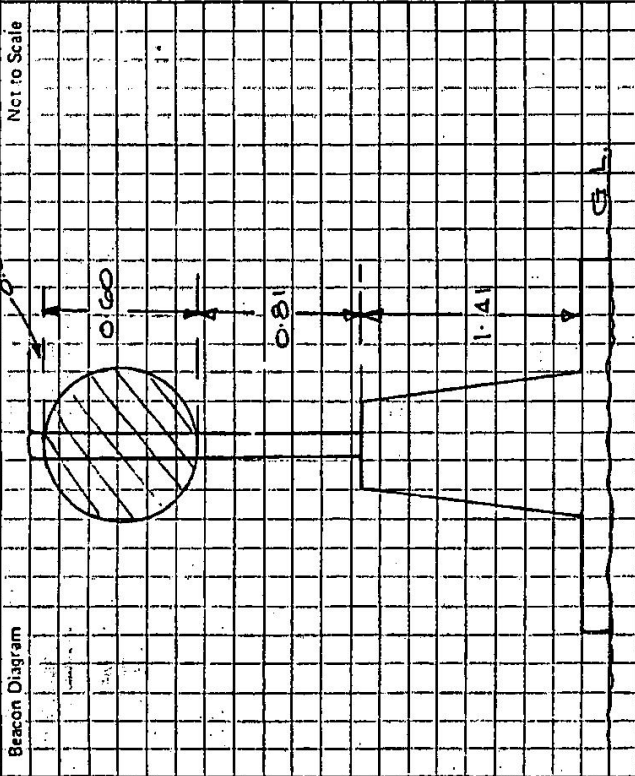

Owner's Name: UNIVERSITY OF NSW
 Address: PO. Box 1
 KENSINGTON 2033
 Phone: 697-4193

Current Occupant: AS BEFORE
 Address: AS BEFORE
 Phone: AS BEFORE

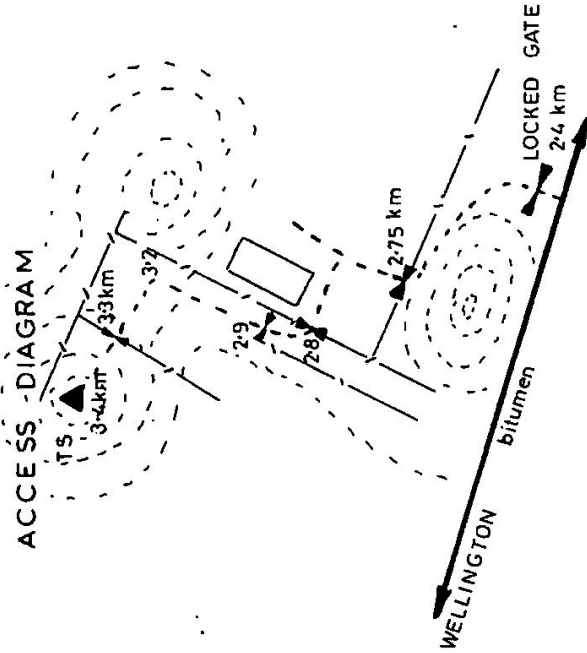

This section to be completed by officer constructing pillar.

Original station mark found/not found.
 Description of mark: NEW STATION.
 Original beacon found/not found.

Description of beacon:
 Height Top of Vanes to Top Mark:m.
 Height of mark:m. above rock/conc. below G.L.
 Diameter of Vanes:m. Height of Cairn:m.
 Original Beacon has/has not been destroyed by me.

KEY TO LOCKED GATE CAN BE OBTAINED FROM THE SURVEYOR GENERAL
 UNI/N.S.W. Research Station, located on extension of Warne Street,
 towards river (east).

- Pierce and Maxwell Street 0.0km
- Travel south along Pierce Street, swing south east past rubbish tip at 1.5km
- Cross grid at 2.0km
- Turn in through locked gate at 2.4km
- Travel round on hill left to gate 2.75km
- Through gate at west side of yards 2.9km
- Follow track to top of ridge and water tanks 3.2km
- North East along fence to gate 3.3km
- On to trig near Radio Mast 3.4km

