

GEODETIC SURVEY OF NSW

CENTRAL MAPPING AUTHORITY

GEODETIC STATION RECONNAISSANCE and MAINTENANCE REPORT

STATION: *MICKETY G.S.S. (P)* No.: *7238*

MAPSHEET SCALE 1:250 000 *Dubbo*

INSPECTED BY: *P.B.T.S.* DATE: *15.8.85*

AUTHORITY: *C.M.A.* FIELD BOOK: *C.380*

Description: *140° to 130°* Note: *Cross out word or words which do not apply*
 1. Cleared by James bearing..... from Trig. Mast

2. Mast & Vanes have been painted white & black respectively. ✓
 3. The ~~mark~~/pillar was ~~constructed on~~ *13m August 1985* dimensions now being:


Description of mark: *1/2 Pole Plate* should be explicit, e.g. S/Steel Pillar Plate, Steel plug, Brass plug, Bolt, G.I. Pipe
 Height of mark: *1380* above ~~mark~~/concrete; Mark is: *1530* above ~~mark~~/G.L.
 Height of Top Vanes to Top ~~mark~~/Pillar plate: *1430* Diameter of Vanes (vertical): *0750*
 Height of Cairn.....m. Diameter of Cairn.....m. Name Plate found/~~found~~/placed.

Length of Mast.....m. (approximate if not unpled)
 4. *Bronze Trig. Ring* set in ~~conc~~/rock has been ~~found~~/found, bearing.....°M from ~~mark~~/Pillar
 5. *G.I. Plate* set in ~~conc~~/rock has been placed/~~found~~, bearing.....°M from ~~mark~~/Pillar
 6. *A*.....set in ~~conc~~/rock has been placed/~~found~~, bearing.....°M from Mast/~~mark~~/Pillar
 7. *A*.....set in ~~conc~~/rock has been placed/~~found~~, bearing.....°M from Mast/~~mark~~/Pillar

8. Action required: *REPLACEMENT OF MARK RATE*
 STANDPOINT: *BRONZE TRIG RING* STANDPOINT: *CONC OBS PILE*

Mark	Direction	Horiz. Distance	Height Difference	Mark	Direction	Horiz. Distance	Height Difference
<i>GEURIE (P)</i>	<i>0 00 00</i>		<i>above standpt</i>	<i>GEURIE (P)</i>	<i>0 00 00</i>		<i>above standpt</i>
<i>G.I. PLATE</i>	<i>13 23 00</i>	<i>3 604</i>	<i>above standpt</i>	<i>G.I. PLATE</i>	<i>30 39 46</i>	<i>6 204</i>	<i>below standpt</i>
<i>NELLINGTON (P)</i>	<i>111 18 00</i>		<i>above standpt</i>	<i>BRONZE TRIG RING</i>	<i>51 50 50</i>	<i>2 961</i>	<i>below standpt</i>
<i>NELLESLEY (P)</i>	<i>150 41 20</i>		<i>above standpt</i>	<i>NELLINGTON (P)</i>	<i>111 17 25</i>		<i>above standpt</i>
<i>CONC OBS PILE</i>	<i>231 53 10</i>	<i>2 961</i>	<i>above standpt</i>	<i>NELLESLEY (P)</i>	<i>150 39 40</i>		<i>above standpt</i>
<i>DIBALAMBIE (P)</i>	<i>322 03 40</i>		<i>above standpt</i>	<i>DIBALAMBIE (P)</i>	<i>322 03 50</i>		<i>above standpt</i>

Prepared by: *P.B.T.S.* 20.8.85 Checked: *[Signature]* Noted on U.T.M. Card *44 5168*

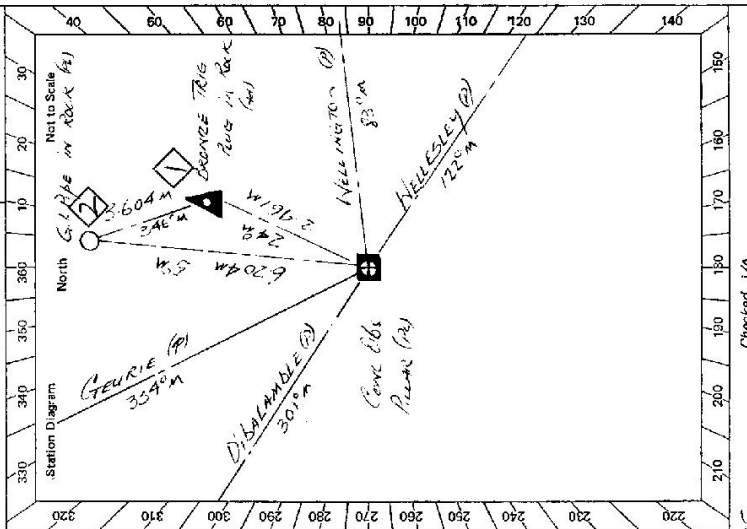

Station Diagram
 Not to Scale
 North
 G.I. RING
 BRONZE TRIG RING
 W. 190° 2
 346m
 3604m
 6204m
 3390m
 DIBALAMBIE (P)
 3017m
 CONC OBS PILE
 823m
 NELLINGTON (P)
 NELLESLEY (P)
 722m

Checked: *[Signature]*

STATION **NICKETY GS (2) TS 7238**


Owner's Name: **J. R. 8972**
 Address: **CHURCH LANE BOARDMAN**
 Phone: **01904 2400**

Access Point: **1904 2400**
 Current Occupant: **1904 2400**
 Address: **1904 2400**
 Phone: **1904 2400**

AND ACCESS

Access Report of **15/8/1985** was found suitable/unsuitable.

LEATHER
 000 WEST OFFICE NEEL INSTON HEADS TOWARDS HARRIS, DUBRO
 011 STRAIGHT AHEAD TOWARDS HARRIS
 023 BRIDGE OVER BELL XING
 076 TURN RIGHT OVER TERRA BELLA 27
 156 PASS RAMP TO MOUNT ATHOLIC RESERVE ON RIGHT
 846 PASS RAMP ON RIGHT TO ACCESS OWNERS HOUSE "MARGUERITE PARK"
 970 TURN RIGHT ON TO JEROME ROAD
 10.69 TURN RIGHT AT CREST OF HILL THROUGH LOCKED IRON GATE
 C.M.A LOCK FITTED, ALONG MOUNT TRAIL UP RIDGE TO GS.
 11.21 NICKETY GS (2)

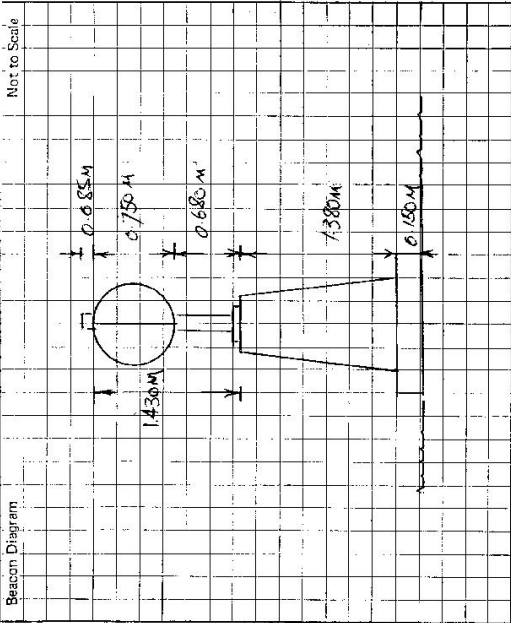

This section to be completed by officer constructing pillar.

Original station mark found/ ~~replaced~~.

Description of mark: **Bronze To. Peg**

Original beacon found/ ~~replaced~~.

Description of beacon: **Green Only**

Height Top of Vanes to Top Mark: **1.15m**

Height of mark: **0.68m** above rock/ ~~above~~ below G.L.

Diameter of Vanes: **1430** Height of Cairn: **1950**

Original Beacon has/has not been destroyed by me: **N/A**

Date	Record of Station