

CENTRAL MAPPING AUTHORITY

GEODETTIC SURVEY OF N.S.W.

GEODETTIC STATION RECONNAISSANCE and MAINTENANCE REPORT

Description:

1. Cleared by lanes bearing $175^{\circ} 33'$ $340^{\circ} - 145^{\circ}$ Note: Cross out word or words which do not apply
 from Trig. Mast

2. Mast & Vanes have been painted white & black respectively.

3. The station/pillar was ~~unplaced/not unplaced~~/constructed on 1.8 1.2 19.85 , dimensions now being:

Description of mark: ~~Sk. Plug. Plate~~ should be explicit, e.g. S/Steel Pillar Plate, Steel plug, Brass plug, Bolt, G.I. Pipe

Height of mark: 1.376 m. above below reek/concrete; Mark is 1.536 m. above below G.L.

Height of Top Vanes to Top Mark/Pillar plate 1.430 m. Diameter of Vanes (vertical) 0.750 m.

Height of Cairn m. Diameter of Cairn m. Name Plate ~~found~~/not ~~found~~/placed.

Length of Mast m. (approximate if not unplaced)

4. A. ~~C.P. REEK~~ ~~NAIL~~ set in conc/reek has been placed/~~found~~, bearing 342° M from Mast/Plug/Pillar

5. A. ~~G.I. PIPE~~ set in conc/reek has been placed/~~found~~, bearing 315° M from Mast/Plug/Pillar

6. A. set in conc/rock has been placed/~~found~~, bearing M from Mast/Plug/Pillar


7. A. set in conc/rock has been placed/~~found~~, bearing M from Mast/Plug/Pillar

8. Action required: ~~NAME~~ ~~PLATE~~ ~~TO~~ ~~BE~~ ~~PLACED~~ ~~IN~~ ~~THE~~ ~~NAME~~ ~~STATION~~ ~~.....~~

STANDPOINT: CONG PILLAR			STANDPOINT: COPPER NAIL				
Mark	Direction	Horiz. Distance	Height Difference	Mark	Direction	Horiz. Distance	Height Difference
MUNDSCAMEN (P)	0 00 00		above standpt	MUNDSCAMEN (P)	0 00 00		above standpt
COPPER NAIL	15 54 20	3.771	above standpt	BLAKNEY (P)	63 14 40		above standpt
BLAKNEY (P)	63 14 20		below	KILDARE (P)	86 03 20		below
KILDARE (P)	86 02 20		above standpt	G.I. PIPE	141 06 00	4.568	above standpt
G.I. PIPE	88 56 20	3.903	below	MARY (P)	174 51 10		above standpt
MARY (P)	174 51 00		above standpt	CONC PILLAR	195 54 30	3.772	above standpt
MERRONG (P)	314 31 20		below	MERRONG	194 30 40		below

Prepared by: *[Signature]* 27.1.86 Noted on U.T.M. Card *[Signature]*

Checked: *[Signature]*

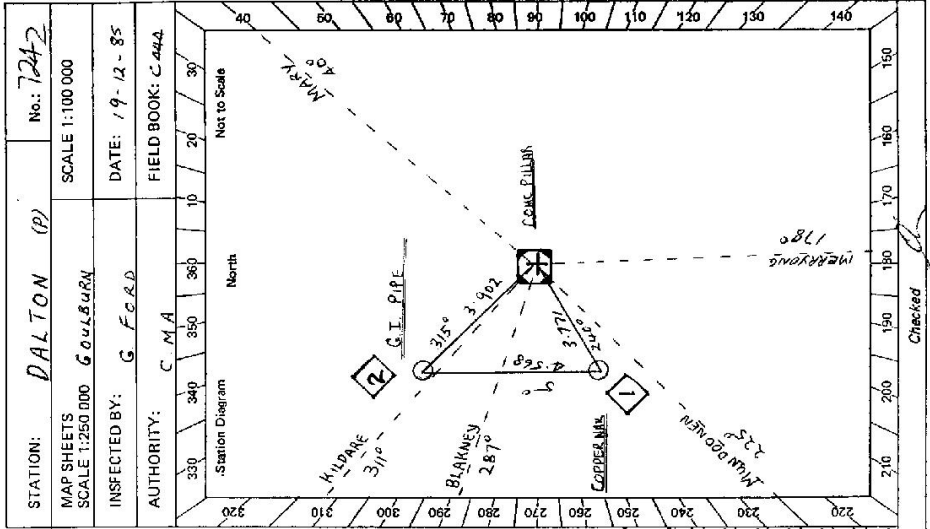

STATION: DALTON (P) No.: 1242

MAP SHEETS SCALE 1:250 000 Goulburn

INSPECTED BY: G. F. C. A. D. DATE: 19-12-85

AUTHORITY: C. M. A. FIELD BOOK: C. 444

Station Diagram
 Not to Scale
 330 340 350 1000 1100 1200 1300 1400 1500 1600 1700 1800 1900 2000 2100 2200

Checked: *[Signature]*

