

CENTRAL MAPPING AUTHORITY

GEODETTIC SURVEY OF N.S.W.

GEODETTIC STATION RECONNAISSANCE and MAINTENANCE REPORT

STATION: DENBIGH (P) No.: 7243

MAP SHEETS SCALE 1:250 000

INSPECTED BY: G FORD DATE: 10-1-86

AUTHORITY: C M A FIELD BOOK: 384

Description: 360° Note: Cross out word or words which do not apply

1. Cleared by lanes bearing..... 360°..... from Trig. Mast

2. Mast & Vanes have been painted white & black respectively. ✓

3. The station/pillar was ~~unpainted/ret-applied~~/constructed on..... 9-1-19 86..... dimensions now being:

Description of mark: S/S PILLAR..... set in conc/rock..... should be explicit, e.g., S/Steel Pillar Plate, Steel plug, Brass plug, Bolt, G.I. Pipe

Height of mark..... 3.80..... m. above below reek/concrete; Mark is..... 5.30..... m. above below G.L.

Height of Top Vanes to Top Mark/Pillar plate..... 1.442..... m. Diameter of Vanes (vertical)..... 0.756..... m.

Height of Cairn..... m. Diameter of Cairn..... m. Name Plate ~~found~~/not ~~found~~/placed.

Length of Mast..... m. (approximate if not unpiled)

4. A..... BRASS TRIG. PLUG..... set in conc/rock has been placed/found, bearing..... 196°..... °M from Mast/Plug/Pillar

5. A..... COPPER NAIL..... set in conc/reek has been placed/found, bearing..... 133°..... °M from Mast/Plug/Pillar

6. A..... set in conc/rock has been placed/found, bearing..... °M from Mast/Plug/Pillar


7. A..... set in conc/rock has been placed/found, bearing..... °M from Mast/Plug/Pillar

8. Action required..... NAME PLATE TO BE PLACED.....

STANDPOINT: STEEL PILLAR PLATE			STANDPOINT: BRASS PLUG				
Mark	Direction	Horiz. Distance	Height Difference	Mark	Direction	Horiz. Distance	Height Difference
NARRAWA (P)	0 00 00		above standpt.	NARRAWA (P)	0 00 00		above standpt.
C RAMP (CPD)	26 41 40		above standpt.	C RAMP (CPD)	26 41 10		above standpt.
COPPER NAIL	145 33 30	5 882	below standpt.	S/S PILLAR PLATE	28 44 30	4 031	below standpt.
KILDARE (P)	174 59 40		above standpt.	COPPER NAIL	104 01 50	5 427	above standpt.
BRASS TRIG. PLUG	208 45 30	4 030	below standpt.	KILDARE (P)	174 59 30		above standpt.
BLANNEY (P)	221 23 20		above standpt.	BLANNEY (P)	221 23 00		above standpt.
			below standpt.				below

Prepared by: G Ford 19/86 Checked: 22.1.86 Noted on U.T.M. Card

Checked: [Signature]

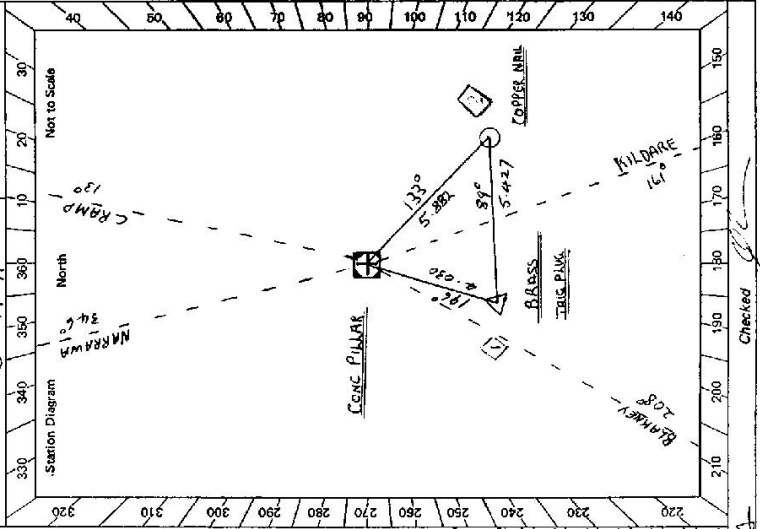


SR 2733-2 D. West, Government Printer

STATION **DENBIGH (P) TS 7243**

Owner's Name: **GARY & P.M. HASLAM**
 Address: **HILLS REST**
BIAKA RD VIA GUNNING
 Phone: **048 451123**

ACCESS OWNERS
 Current Occupant: **MR J DENBIGH**
 Address: **BEVENHOLE RD**
MR PETER COLLINS
BEVENHOLE RD 048 450209
 Phone:

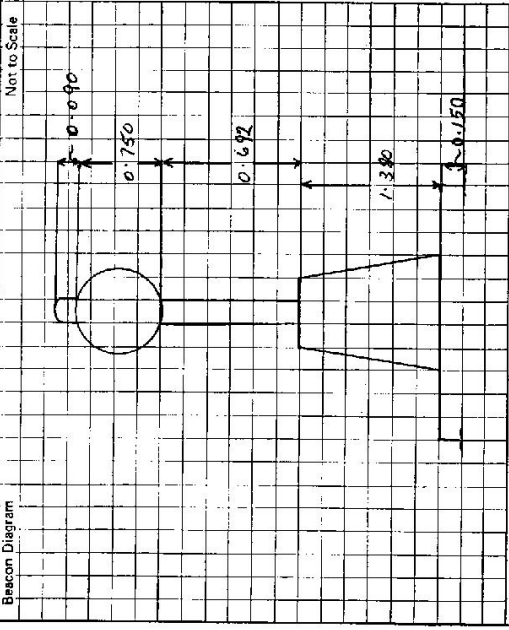

Access Report of **L. W. 19** was found suitable/unsuitable.
DALTON IS 11.6 KM NORTH OF GUNNING

0.00 DARTON P.O. HEAD WEST
0.05 TURN RIGHT TOWARDS BEVENHOLE 25 RUGBY ST
13.90 TAKE LEFT FORK BEVENHOLE 10 RUGBY ST
18.55 PASS ROAD TO YARD 39 ON LEFT STRAIGHT AHEAD RUGBY ST
25.54 TURN RIGHT SIGN CROCKWELL RD
26.42 CROSS KACHLAN RIVER
27.26 THROUGH GATE ON LEFT FOLLOW TRACK STRAIGHT AHEAD

28.40 THROUGH IRON GATE TURN RIGHT AND FOLLOW TRACK
28.67 CROSS CREEK
28.76 THROUGH GAP IN FENCE CONTINUE STRAIGHT AHEAD
30.53 THROUGH IRON GATE TAKE TRACK KEEPING LEFT
31.47 THROUGH IRON GATE TURN LEFT AND FOLLOW RIDGE TO TRIG
32.76 DENBIGH C.S.

1ST ACCESS OWNERS HOUSE ON LEFT [MR J DENBIGH]
 2ND ACCESS OWNERS HOUSE CONTINUE ALONG MAIN RD 1ST RAMP ON LEFT APPROX 2KM FROM RD [PETER COLLINS]

This section to be completed by officer constructing pillar.

Original station mark found/~~not found~~.

Description of mark: **BRASS PLUG**

Original beacon found/~~not found~~.

Description of beacon: **CALUM POLE & DISC**

Height Top of Vanes to Top Mark: **1.100** m.

Height of mark: **0.05** m. above rock base **0.165** m. below G.L.

Diameter of Vanes: **0.940** m. Height of Calum: **1.100** m.

Original Beacon has/had not been destroyed by me.

Date	Record of Station