

CENTRAL MAPPING AUTHORITY

GEODETTIC SURVEY OF M.S.M.

GEODETTIC STATION RECONNAISSANCE and MAINTENANCE REPORT

Description:

1. Cleared by lanes bearing  $237^{\circ} - 205^{\circ}$  Note: Cross out word or words which do not apply from Trig. Mast

2. Mast & Vanes have been painted white & black respectively.

3. The station/pillar was ~~replaced~~ constructed on  $18-12-1985$ , dimensions now being:

Description of mark:  $5/8$  ~~BLANK~~ ~~PI~~ ~~PLATE~~, should be explicit, e.g., S/Steel Pillar Plate, Steel plug, Brass plug, Bolt, G.I. Pipe

Height of mark:  $1.370$  m. above below reek/concrete; Mark is  $1.550$  m. above below G.L.

Height of Top Vanes to Top Mast/Pillar plate  $1.435$  m. Diameter of Vanes (vertical)  $0.250$  m.

Height of Cairn.....m. Diameter of Cairn.....m. Name Plate found/not found/placed.

Length of Mast.....m. (approximate if not unplied)

4. A...COPPER...MH.....set in conc/reek has been placed/found, bearing  $126^{\circ}$  M from Mast/Plug/Pillar

5. A...G.I. PIPE.....set in conc/reek has been placed/found, bearing  $13^{\circ}$  M from Mast/Plug/Pillar


6. A.....set in conc/rock has been placed/found, bearing.....M from Mast/Plug/Pillar

7. A.....set in conc/rock has been placed/found, bearing.....M from Mast/Plug/Pillar

8. Action required: NAME, DATE, SET, BE PLACED, NEW STATION.....

STANDPOINT: CONC PILLAR		STANDPOINT: COPPER NAIL	
Mark	Direction	Mark	Direction
BLANKNEY (P)	C 00 00	BLANKNEY (P)	C 00 00
NARRAWA (P)	26 11 20	CONC PILLAR	43 42 40
G.I. PIPE	106 37 50	G.I. PIPE	75 02 50
MARY (P)	167 57 00	NARRAWA (P)	76 10 30
COPPER NAIL	223 43 00	MARY (P)	167 56 00
MUNDORONG	282 45 40	MUNDORONG	282 45 40

Prepared by: *[Signature]* 23/12/85 Checked: *[Signature]* 22.1.86 Noted on U.T.M. Card *[Signature]*

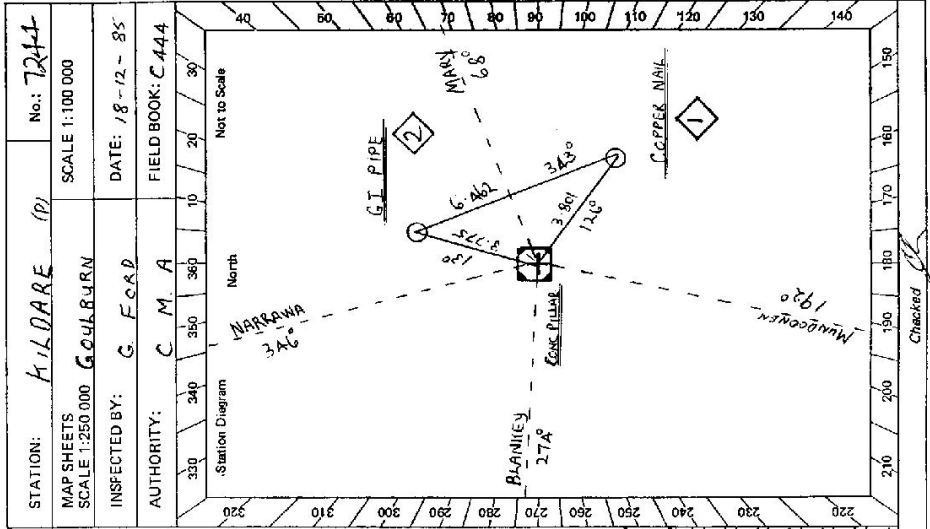

STATION: HILDARE (P) No.: 7244  
 MAP SHEETS SCALE 1:250,000 Goulburn  
 INSPECTED BY: G. FORD DATE: 18-12-85  
 AUTHORITY: C.M.A. FIELD BOOK: C.444  
 Station Diagram  
 Not to Scale  
 Checked *[Signature]*

