

TS-7249

GEODETIC SURVEY OF N.S.W.

CENTRAL MAPPING AUTHORITY

GEODETIC STATION RECONNAISSANCE and MAINTENANCE REPORT

STATION: **GWYNNE**
 No: **2389**
 MAP SHEETS SCALE 1:250 000 **GOULBURN**
 SCALE 1:100 000 **YASS**
 INSPECTED BY: **K HADDON**
 DATE: **20-9-83**
 AUTHORITY: **CMA**
 FIELD BOOK: **C300**

Description: *Note: Cross out word or words which do not apply*

1. Cleared by lances bearing..... from Trig. Mast

2. ~~Mast & Vanes have been painted white & black respectively.~~

3. The station/pillar was unpiled/not unpiled/constructed on..... 19....., dimensions now being:

Description of mark..... should be explicit, e.g., S/Steel Pillar Plate, Steel plug, Brass plug, Bolt, G.I. Pipe

Height of mark..... m. above rock/concrete; Mark is..... m. above G.L. below

Height of Top Vanes to Top Mark/Pillar plate m. Diameter of Vanes (vertical)..... m.

Height of Cairn..... m. Diameter of Cairn..... m. Name Plate found/not found/placed.

Length of Mast m. (approximate if not unpiled)


4. A..... set in conc/rock has been placed/found, bearing..... ° M from Mast/Plug/Pillar

5. A..... set in conc/rock has been placed/found, bearing..... ° M from Mast/Plug/Pillar

6. A..... set in conc/rock has been placed/found, bearing..... ° M from Mast/Plug/Pillar

7. A..... set in conc/rock has been placed/found, bearing..... ° M from Mast/Plug/Pillar

8. Action required: *Not suitable for 1:4000 Survey at Goulburn*

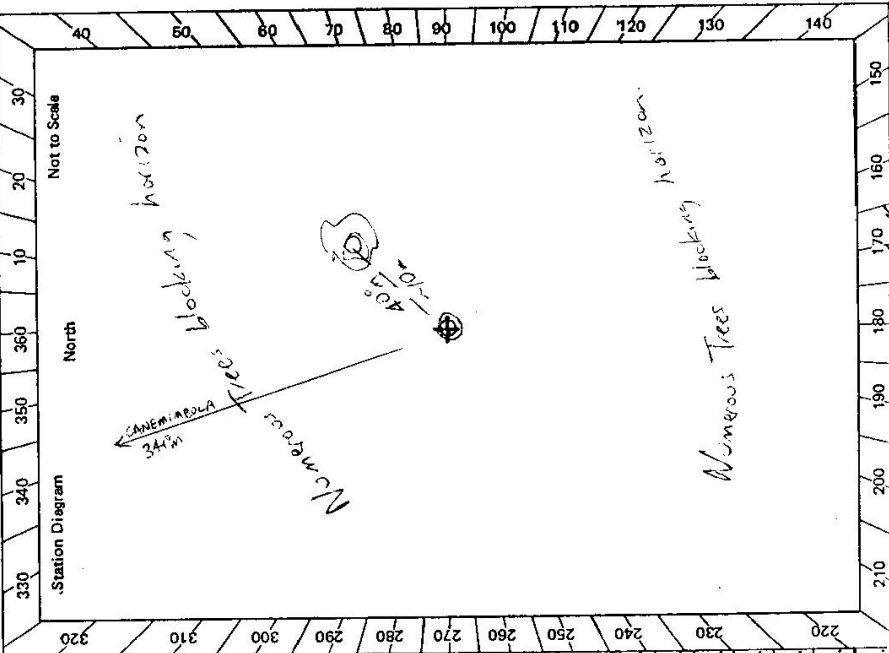

STANDPOINT:				STANDPOINT:			
Mark	Direction	Horiz. Distance	Height Difference	Mark	Direction	Horiz. Distance	Height Difference
			above standpt.				above standpt.
			below				below
			above standpt.				above standpt.
			below				below
Prepared by: **K.J. Haddon**

Noted on U.T.M. Card **111**

Checked: **[Signature]** 6.4.84

STATION GWYNNE TS-7249


Owner's Name: J M MCG RATH
 Address: "Hopefield"
 Via Boorowa
 Phone: 063 853160

Current Occupant:
 Address:
 Phone:

ACCESS

Access Report of 20/11/1983 was found suitable/unsuitable.

- 00 Boorowa Post Office. Head north towards Coura
- 0-2 Turn right towards Crockwell
- 0-65 Turn left
- 0-9 Turn right
- 1-8 Straight ahead
- 6-3 Straight ahead towards Rye Park
- 7-2 Turn right onto gravel road.
- 9-8 Grid
- 10-65 Gateway. "Hopefield"
- 11-4 Grid
- 12-7 Straight ahead over grid.
- 13-5 (Owners residence through gateway to left) SEE OWNER
- 14-2 Turn right, follow track up hill to south west. and 2 Grades
- 14-65 Turn right, go through gate, into wheat field. Head west between fence and
- 14-9 At trig, away from fence, head north to top of hill

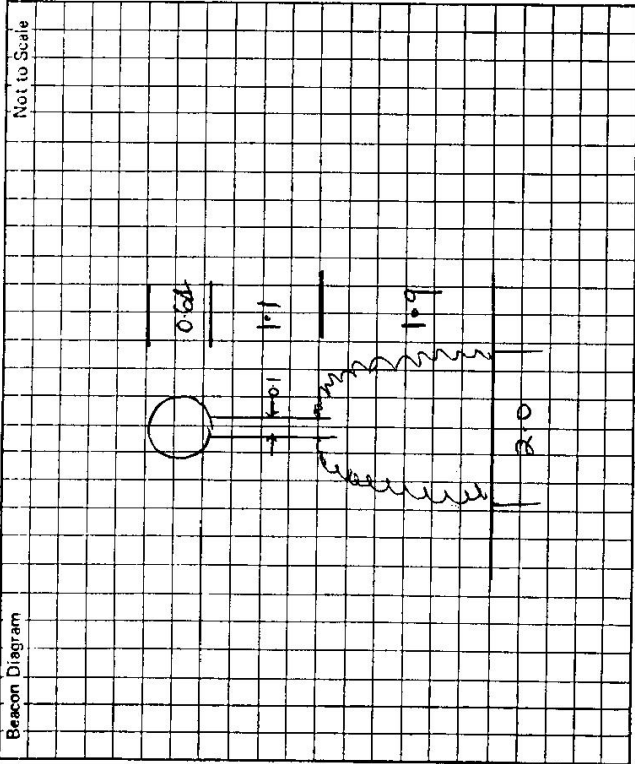

This section to be completed by officer constructing pillar.

Original station mark found/not found.

Description of mark:

Original beacon found/not found.

Description of beacon:

Height Top of Vanes to Top Mark.....m.

Height of mark.....m. above
 rock/conc.....m. below
 G.L.

Diameter of Vanesm. Height of Cairnm.

Original Beacon has/has not been destroyed by me.

Date	Record of Station

CENTRAL MAPPING AUTHORITY

GEODEIC SURVEY OF N.S.W.

GEODEIC STATION RECONNAISSANCE and MAINTENANCE REPORT

Description: 48° 74' 85.90" 205° 21' 5" 190° 30' 340-554' H.A.
 1. CLEARING - lanes bearing ~~...~~
 IT MAY BE POSSIBLE TO SEE OUT BETWEEN TOWER UNDER LARGE TREES OTHER THAN IN THESE LANES
 2. Mast & Vanes have been painted white & black respectively
 3. The station/pillar was unpainted/constructed on ~~...~~
 PILLAR IN SHADE UNTILL AFTERNOON.
 NO SOCKLING NEEDED
 13th FEB. 1986, dimensions now being:

Description of mark ~~...~~ should be explicit, e.g., S/Steel Pillar Plate, Steel plug, Brass plug, Bolt, G.I. Pipe
 Height of mark ~~...~~ m.
 Mark is ~~...~~ m.
 Diameter of Vanes (vertical) ~~...~~ m.


Height of Cairn ~~...~~ m. Diameter of Cairn ~~...~~ m. Name Plate ~~...~~
 Length of Mast ~~...~~ m. (approximate if not unpiled)
 4. A. BRASS TRIC. PIN ~~...~~ set in conc/rock has been placed/found, bearing 237° M from Mast/Plug/Pillar
 5. A. COPPER NAIL ~~...~~ set in conc/rock has been placed/found, bearing 259° M from Mast/Plug/Pillar
 6. A. G.I. PIPE ~~...~~ set in conc/rock has been placed/found, bearing 145° M from Mast/Plug/Pillar
 7. A. ~~...~~ set in conc/rock has been placed/found, bearing ~~...~~ M from Mast/Plug/Pillar

8. Action required: PILLAR TO G.I. PIPE TO BE MEASURED MEASURED (A.S.) WHICH

STANDPOINT: SIS PILLAR PLATE			STANDPOINT: BRASS TRIC. PLUG				
Mark	Direction	Horiz. Distance	Height Difference	Mark	Direction	Horiz. Distance	Height Difference
CANEMMOROLA (P)	0 00 00		above standpt	CANEMMOROLA (P)	0 00 00		above standpt
POOMAN (P)	80 37 35		below standpt	CONC PILLAR	76 32 35	2 332	1 370
G.I. PIPE	164 55 35	VERT ANGLE HT MAST 92.22 45	below standpt	POOMAN (P)	80 36 25		above standpt
TRIC PLUG	256 34 55	2 331	above standpt	G.I. PIPE	162 29 00	VERT ANGLE HT MAST 92.22 45	below standpt
COORAMMA (P)	274 50 05		below standpt	COORAMMA (P)	274 49 10		above standpt
COPPER NAIL	278 39 30	7 769	above standpt	COPPER NAIL	287 31 20	5 679	above standpt
			below standpt				below standpt

Prepared by: *L.C.M.* Checked: *L.C.M.* Noted on U.T.M. Card

STATION: GUYANNE G.S. (P) TS No.: 7249
 MAP SHEETS SCALE 1:250 000 GOULBURN SCALE 1:100 000 YASS
 INSPECTED BY: L. HITCHINS DATE: 14-2-86
 AUTHORITY: C.M.A. FIELD BOOK: C 384

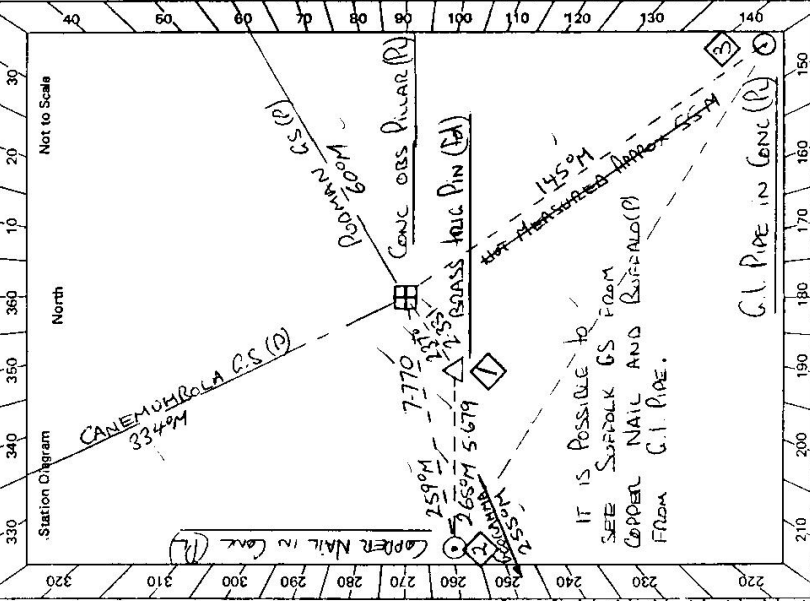

Checked



GS 24

STATION	GWINNE GS (P) 75 7249
<p>Owner's Name: <u>SITUATED ON A</u></p> <p>Address: <u>RESERVE ROAD</u></p> <p>Phone:</p>	<p>SURROUNDING LANDS + ACCESS</p> <p>Current Occupant: <u>IRWIN M. M. GRATH</u></p> <p>Address: <u>HOPEFIELD</u></p> <p>Phone: <u>063 853160</u></p>
<p>ACCESS</p> <p>Access Report of 20.9.1983 was found suitable/unsuitable.</p> <p>00 BOOROWA DO. HEAD NORTH TOWARDS CORNER</p> <p>02 TURN RIGHT TOWARDS CROOKWELL</p> <p>065 TURN LEFT</p> <p>09 TURN RIGHT</p> <p>18 STRAIGHT AHEAD TOWARDS RYE PARK</p> <p>63 TURN RIGHT AHEAD ONTO GRAVEL ROAD</p> <p>72 CROSS GRID GATE "HOPEFIELD"</p> <p>10.65 THROUGH GATE "HOPEFIELD"</p> <p>11.4 CROSS GRID</p> <p>12.7 STRAIGHT AHEAD OVER GRID</p> <p>13.5 OWNERS HOUSE ON LEFT. CALL IN. TURN RIGHT HERE</p> <p>142 FOLLOW TRACK UP HILL GATE FOLLOW FENCE ON LEFT</p> <p>1465 TURN RIGHT HEAD TO TOP OF HILL</p> <p>149 GWINNE GS (P)</p>	
<p>Beacon Diagram</p> <p style="text-align: right;">Not to Scale</p>	<p>Date</p> <p>Record of Station</p>
<p>This section to be completed by officer constructing pillar.</p> <p>Original station mark found/not found</p> <p>Description of mark: <u>BRASS TRIG PIN IN ROCK</u></p> <p>Original beacon found/not found</p> <p>Description of beacon: <u>CAIRN POLE + DISCS</u></p> <p>Height Top of Vanes to Top Mark: <u>3.110</u> m.</p> <p>Height of mark: <u>0.60</u> m. above rock/fence <u>0.200</u> m. below</p> <p>Diameter of Vanes: <u>0.610</u> m. Height of Cairn: <u>1.500</u> m.</p> <p>Original Beacon has/has not been destroyed by me.</p>	

CENTRAL MAPPING AUTHORITY

GEODETTIC SURVEY OF N.S.W.

GEODETTIC STATION RECONNAISSANCE and MAINTENANCE REPORT

- Description: *Note: Cross out word or words which do not apply*
- Cleared by lanes bearing..... from Trig. Mast
 - Mast & Vanes have been painted white & black respectively.
 - The station/pillar was unpiled/not unpiled/constructed on..... 19....., dimensions now being:
 - Description of mark.....should be explicit, e.g., S/Steel Pillar Plate, Steel plug, Brass plug, Bolt, G.I. Pipe
 - Height of mark.....m. ^{above} _{below} rock/concrete; Mark is.....m. ^{above} _{below} G.L.
 - Height of Top Vanes to Top Mark/Pillar plate.....m. Diameter of Vanes (vertical).....m.
 - Height of Cairn.....m. Diameter of Cairn.....m. Name Plate found/not found/placed.
 - Length of Mast.....m. (approximate if not unpiled)
 - A..... set in conc/rock has been placed/found, bearing.....°M from Mast/Plug/Pillar
 - A..... set in conc/rock has been placed/found, bearing.....°M from Mast/Plug/Pillar
 - A..... set in conc/rock has been placed/found, bearing.....°M from Mast/Plug/Pillar
 - A..... set in conc/rock has been placed/found, bearing.....°M from Mast/Plug/Pillar

8. Action required:..... STANDPOINT: **COPPER NAIL** \square **G.I. PIPE** \square

Mark	Direction	Horiz. Distance	Height Difference	Mark	Direction	VERT ANGLE	HT INST	HT TARGET
GOORAMMA (P)	0 00 00		above standpt	CANEMURBOLA (P)	0 00 00			
PUDMAN	165 48 55		above standpt	PUDMAN (P)	80 17 10			
CONC PILLAR 2	183 49 45	7771	1.636 above	BUFFALO (P)	138 51 20			
TRIG PUG 1	192 42 20	5680	0.268 above	GOORAMMA (P)	275 13 20			
G.I. PIPE 3	243 06 45	974855	1.439 above	CONC PILLAR 2	288 01 40	90 58 55	1418	0 00
			HT INST	TRIG PUG 1	342 35 10	90 46 10	1418	0 00
			HT INST	CONC PILLAR 0	345 00 45	89 19 25	1418	0 017

Prepared by: *[Signature]* Checked: *[Signature]* Noted on U.T.M. Card

STATION: **C. WYNNE C.S. (P)** - TS 7249 No.:
 MAP SHEETS SCALE 1:100 000
 SCALE 1:250 000 **COULBURN**
 INSPECTED BY: **L. HITCHINS** DATE: **14.2.86**
 AUTHORITY: **C.M.A** FIELD BOOK: **C384**

