


STATION: TERRY ME MIE - No.: TS 7250
 MAP SHEET SCALE 1:250 000
 INSPECTED BY: C. JONES DATE: 22/7/82
 AUTHORITY: C.O.A. FIELD BOOK: 2003

PROVIDED NEW STATION
 TERRY ME MIE -
 MIE REELL

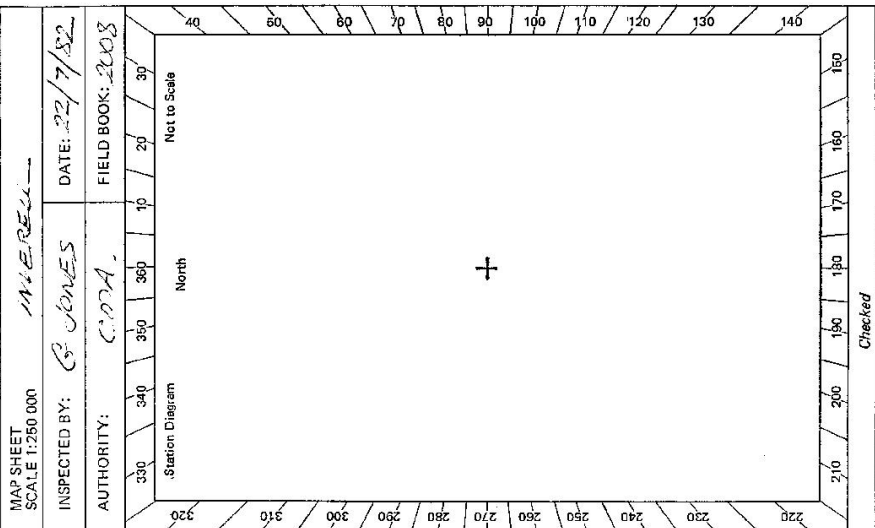

GEODETIC SURVEY OF N.S.W.
 CENTRAL MAPPING AUTHORITY
 GEODETIC STATION RECONNAISSANCE and MAINTENANCE REPORT

Description:
 Note: Cross out word or words which do not apply

1. Cleared by lanes bearing..... from Trig. Mast
2. Mast & Vanes have been painted white & black respectively.
3. The station/pillar was unpiled/not unpiled/constructed on..... 19..... dimensions now being:
 Description of mark..... should be explicit, e.g., Steel Pillar/Plate, Steel plug, Brass plug, Bolt, G.I. Pipe
 Height of mark..... m. above rock/concrete; ~~Mark~~..... m. above G.L.
 Height of Top Vanes to Top Mark/Pillar plate..... m. Diameter of Vanes (vertical)..... m.
 Height of Cairn..... m. Diameter of Cairn..... m. Name Plate found/not found/placed.
 Length of Mast..... m. (approximate if not unpiled)
4. A..... set in conc/rock has been placed/found, bearing..... °M from Mast/Plug/Pillar
5. A..... set in conc/rock has been placed/found, bearing..... °M from Mast/Plug/Pillar
6. A..... set in conc/rock has been placed/found, bearing..... °M from Mast/Plug/Pillar
7. A..... set in conc/rock has been placed/found, bearing..... °M from Mast/Plug/Pillar
8. Action required: ~~SEE 55/11/949~~


STANDPOINT:

Mark	Direction	Horiz. Distance	Height Difference	Mark	Direction	Horiz. Distance	Height Difference
			above standpt				above standpt
			below				below
			above standpt				above standpt
			below				below
Prepared by: GLOP 23/9/82 Checked: Noted on U.T.M. Card

St 2735-2 D. West, Government Printer

Beacon Diagram

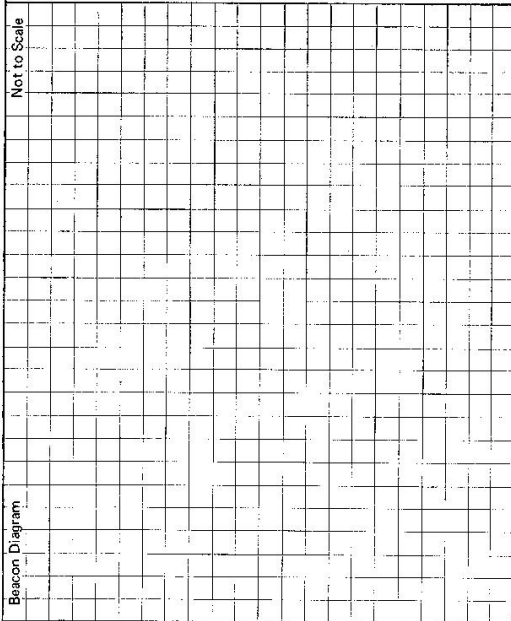

STATION

TERRY HIE HIE - TS 7250

Owner's Name: Mrs D & Mrs JA BUTLER

Address: "Kilgarr"

Phone: Baysan

Phone: 227121

ACCESS THROUGH JC & MRS CELESTON

Address: WEST LYNNIE

Phone: TERRY HIE HIE

Phone: 526143

ACCESS 22/7/1982

Access Report of www.govt.nz/territorial-authorities.

- 0:00 Phone box at TERRY HIE HIE. Travel south.
- 0:05 Courseway over "Tyconnah Creek"
- 1:15 Turn left onto gravel road. Sign "Crossroad"
- 2:15 Grid 510 Grid S-35 Grid
- 9:05 Turn right. Sign "The Tops"
- 9:55 Turn gate. 14-9 Grid 16-4 Grid
- 12:4 Grid
- 18:15 Cross grid. Sign "Boundary - West Lyne, The Tops"
- 18:4 Turn right off road towards small tower and building.
- 18:45 At shed and metal tower. Follow point track, then closed track through timber. (Roughly 40m from tower.)
- 19:15 Turn left onto track along side pulled carriage.
- 19:45 Pass track on left.
- 19:6 Turn sharp right off track. Then follow the left rough track.
- 19:75 At the end of the closed track, follow rough closed track through timber up hill.
- 20:25 Stop vehicle on top of ridge at fence line. The top site is dominated in a NW direction along ridge.

Date

Record of Station

This section to be completed by officer constructing pillar.

Original station mark found/not found.

Description of mark:

Original beacon found/not found.

Description of beacon:

Height: Top of Vanes to Top Mark m.

Height of mark: m. above rock/conc. m. below G.L.

Diameter of Vanes m.

Height of Cairn m.

Original beacon has/has not been destroyed by me.

CARD NO. (1) OF (2) CARDS

GEODETTIC SURVEY OF N.S.W.

GEODETTIC STATION RECONNAISSANCE and MAINTENANCE REPORT

Description:

1. Cleared by lanes bearing $324^\circ - 47^\circ$ $116^\circ - 193^\circ$ $230^\circ - 245^\circ$ from Trig. Mast
Note: Cross out word or words which do not apply
2. Mast & Vanes have been painted white & black respectively.
3. The station/pillar was ~~unrepaired/constructed~~ on 25 June 1966 , dimensions now being:

Description of mark: ~~Steel Pillar Plate~~ should be explicit, e.g. S/Steel Pillar Plate, Steel plug, Brass plug, Bolt, G.I. Pipe

Height of mark: 3.80 m. above ~~below~~ ~~rock/concrete~~; Mark is 5.24 m. above G.L.

Height of Top Vanes to Top ~~Mark~~/Pillar plate 4.35 m. Diameter of Vanes (vertical) 7.50 m.

Height of Cairn m. Diameter of Cairn m. Name Plate ~~found/not found~~/placed.

Length of Mast 1.525 m. (~~approximate/precise~~)

4. A. ~~Conc. Plug~~ set in conc/rock has been placed/~~found~~, bearing 244° from ~~Mast/Plug~~/Pillar

5. A. G. I. Pipe set in conc/rock has been placed/~~found~~, bearing 83° from ~~Mast/Plug~~/Pillar

6. A. set in conc/rock has been placed/~~found~~, bearing from Mast/Plug/Pillar

7. A. set in conc/rock has been placed/~~found~~, bearing from Mast/Plug/Pillar

8. Action required:

STANDPOINT:

STANDPOINT:


Mark	Direction	Horiz. Distance	Height Difference	Mark	Direction	Horiz. Distance	Height Difference
			above standpt.				above standpt.
			below				below
			above standpt.				above standpt.
			below				below
Prepared by: D. KAIN

Checked: *[Signature]*

Noted on U.I.M. Card


1. 1407

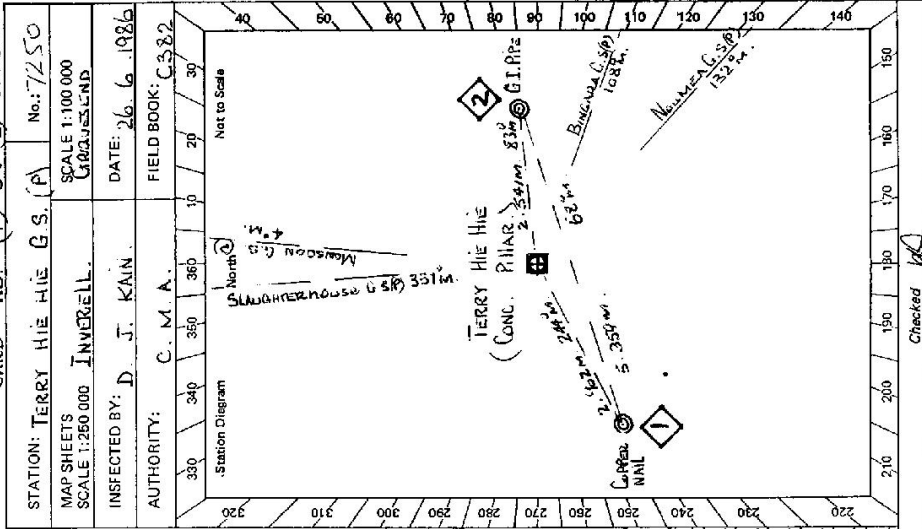

CARD No (2) of 2 U.T.M.A.

STATION: TERRY HIE HIE G.S. (P) No.: TS 7250
 MAP SHEETS SCALE 1:250 000
 SCALE 1:100 000

INSPECTED BY: D. J. KAIN
 DATE: 26. 6. 1986
 AUTHORITY: C. M. A.
 FIELD BOOK: C382.

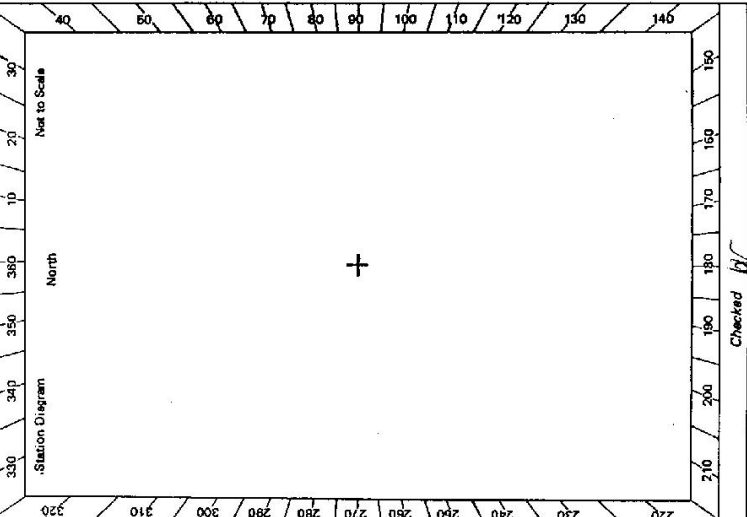

GEODETTIC STATION RECONNAISSANCE and MAINTENANCE REPORT

STANDPOINT: CONCRETE OBS. PILLAR.				STANDPOINT: COPPER NAIL.			
Mark	Direction	Horiz. Distance	Height Difference	Mark	Direction	Horiz. Distance	Height Difference
SLAUGHTER HOUSE (S.P)	0 00 00		above standpt	SLAUGHTER HOUSE G.S.(P)	0 00 00		above standpt
MONSOON G.S.(P)	08 56 41		below standpt	MONSOON G.S.(P)	8 56 11		below standpt
G.I. PIPE	89 03 00	2.542	above standpt	CON. OBS. PILLAR	68 30 03	2.902	above standpt
BINGARA G.S.(P)	117 02 36		below standpt	G.I. PIPE	78 04 28	5.359	below standpt
NOUMEA G.S.(P)	139 26 23		above standpt	BINGARA G.S.(P)	117 01 06		below standpt
COPPER NAIL	248 31 06	2.903	below standpt	NOUMEA G.S.(P)	139 24 49		below standpt

STANDPOINT: G.I. PIPE.				STANDPOINT:			
Mark	Direction	Horiz. Distance	Height Difference	Mark	Direction	Horiz. Distance	Height Difference
SLAUGHTER HOUSE (S.P)	0 00 00		above standpt				above standpt
MONSOON G.S.(P)	8 57 28		below standpt				below standpt
BINGARA G.S.(P)	117 03 57		above standpt				above standpt
NOUMEA G.S.(P)	139 27 36		below standpt				below standpt
COPPER NAIL	258 06 41	5.359	above standpt				above standpt
CONCRETE OBS. Pillar	269 03 43	2.541	below standpt				below standpt

Prepared by: D. KAIN.

Checked:

Noted on U.T.M. Card

Checked: [Signature]

SI 2750 - 2 D. West. Government Printer

STATION TERRY HIE HIE G.S. (P) IS 7250
 ACCESS CORNER AND 6 WESTERN SIDE OF
 BOUNDARY MARK - VEHICLE STOP


FREEHOLD LAND
 Owner's Name: MRS. D. J. E. MISS J.A. BUTLER.
 Address: KALLARA
 Phone: (067) 247 121

BINGAPOO
 Phone: (067) 546 148

TERRY HIE HIE
 Address: WEST LYNNE
 Phone: (067) 546 148

ACCESS
 Access Report of 27.7.19 was found suitable/unsuitable.
 FENCELINE.

KLMS.
 0.00 PHONE BOX AT TERRY HIE HIE, TRAVEL SOUTH.
 0.65 CAUSEWAY OVER TYENNANAH CREEK.
 1.75 TURN LEFT ONTO GRAVEL ROAD, SIGN, GRAVESEND.
 2.75 GRID. 5.00 KLMS GRID. 8.35 KLMS. GRID.
 9.05 TURN RIGHT SIGN, THE TAPS.
 9.85 IRON GATE.
 12.4 GRID. 14.9 KLMS. GRID. 16.4 KLMS. GRID.
 18.15 CROSS GRID SIGN BOUNDARY. WEST LYNNE, THE TAPS.
 18.4 TURN RIGHT OFF ROAD TOWARDS SMALL TOWER AND BUILDING.
 18.45 AT SHED AND SMALL TOWER FOLLOW FAINT TRACK, THEN
 DOZED TRACK THROUGH TIMBER. (ROUGHLY 40M. FROM TOWER.)
 19.15 TURN LEFT ONTO TRACK ALONGSIDE PULLED CLEARING.
 19.45 TURN LEFT ON LEFT.
 19.50 PASS TRACK ON LEFT.
 19.60 TURN SHARP RIGHT OFF TRACK.
 19.75 AT THE END OF THE DOZED TRACK, FOLLOW ROUGH BLAZED TRACK
 THROUGH TIMBER UP HILL.
 20.25 STOP VEHICLE ON TOP OF RIDGE AT FENCE LINE. LEAVE
 VEHICLE CROSS FENCE - 2 MINUTE WALK EASTERLY ALONG RIDGE
 TO TERRY HIE HIE G.S. (P)

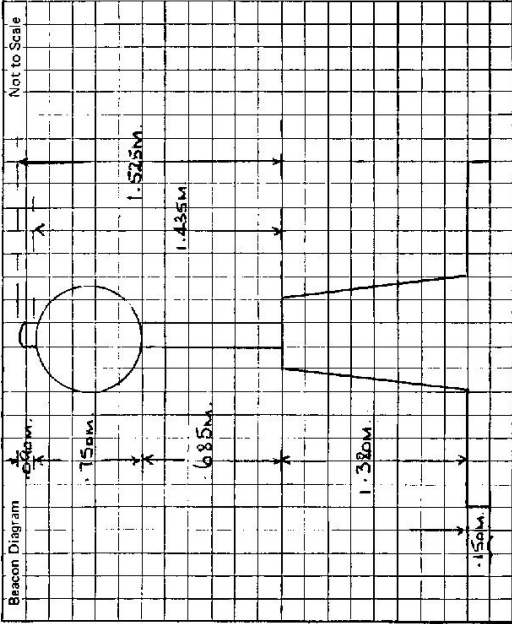

This section to be completed by officer constructing pillar.

Original station mark found/not found.

Description of mark: STATION

Original beacon found/not found.

Description of beacon: NEW

Height Top of Vanes to Top Mark:m.

Height of mark:m. above G.L. below G.L.

Diameter of Vanes:m. Height of Cairn:m.

Original Beacon has/has not been destroyed by me.

Date	Record of Station
	STATIONS WERE IN MARK CONNECTIONS WERE IN EARLY STATIONS visible this day due to very back haze.